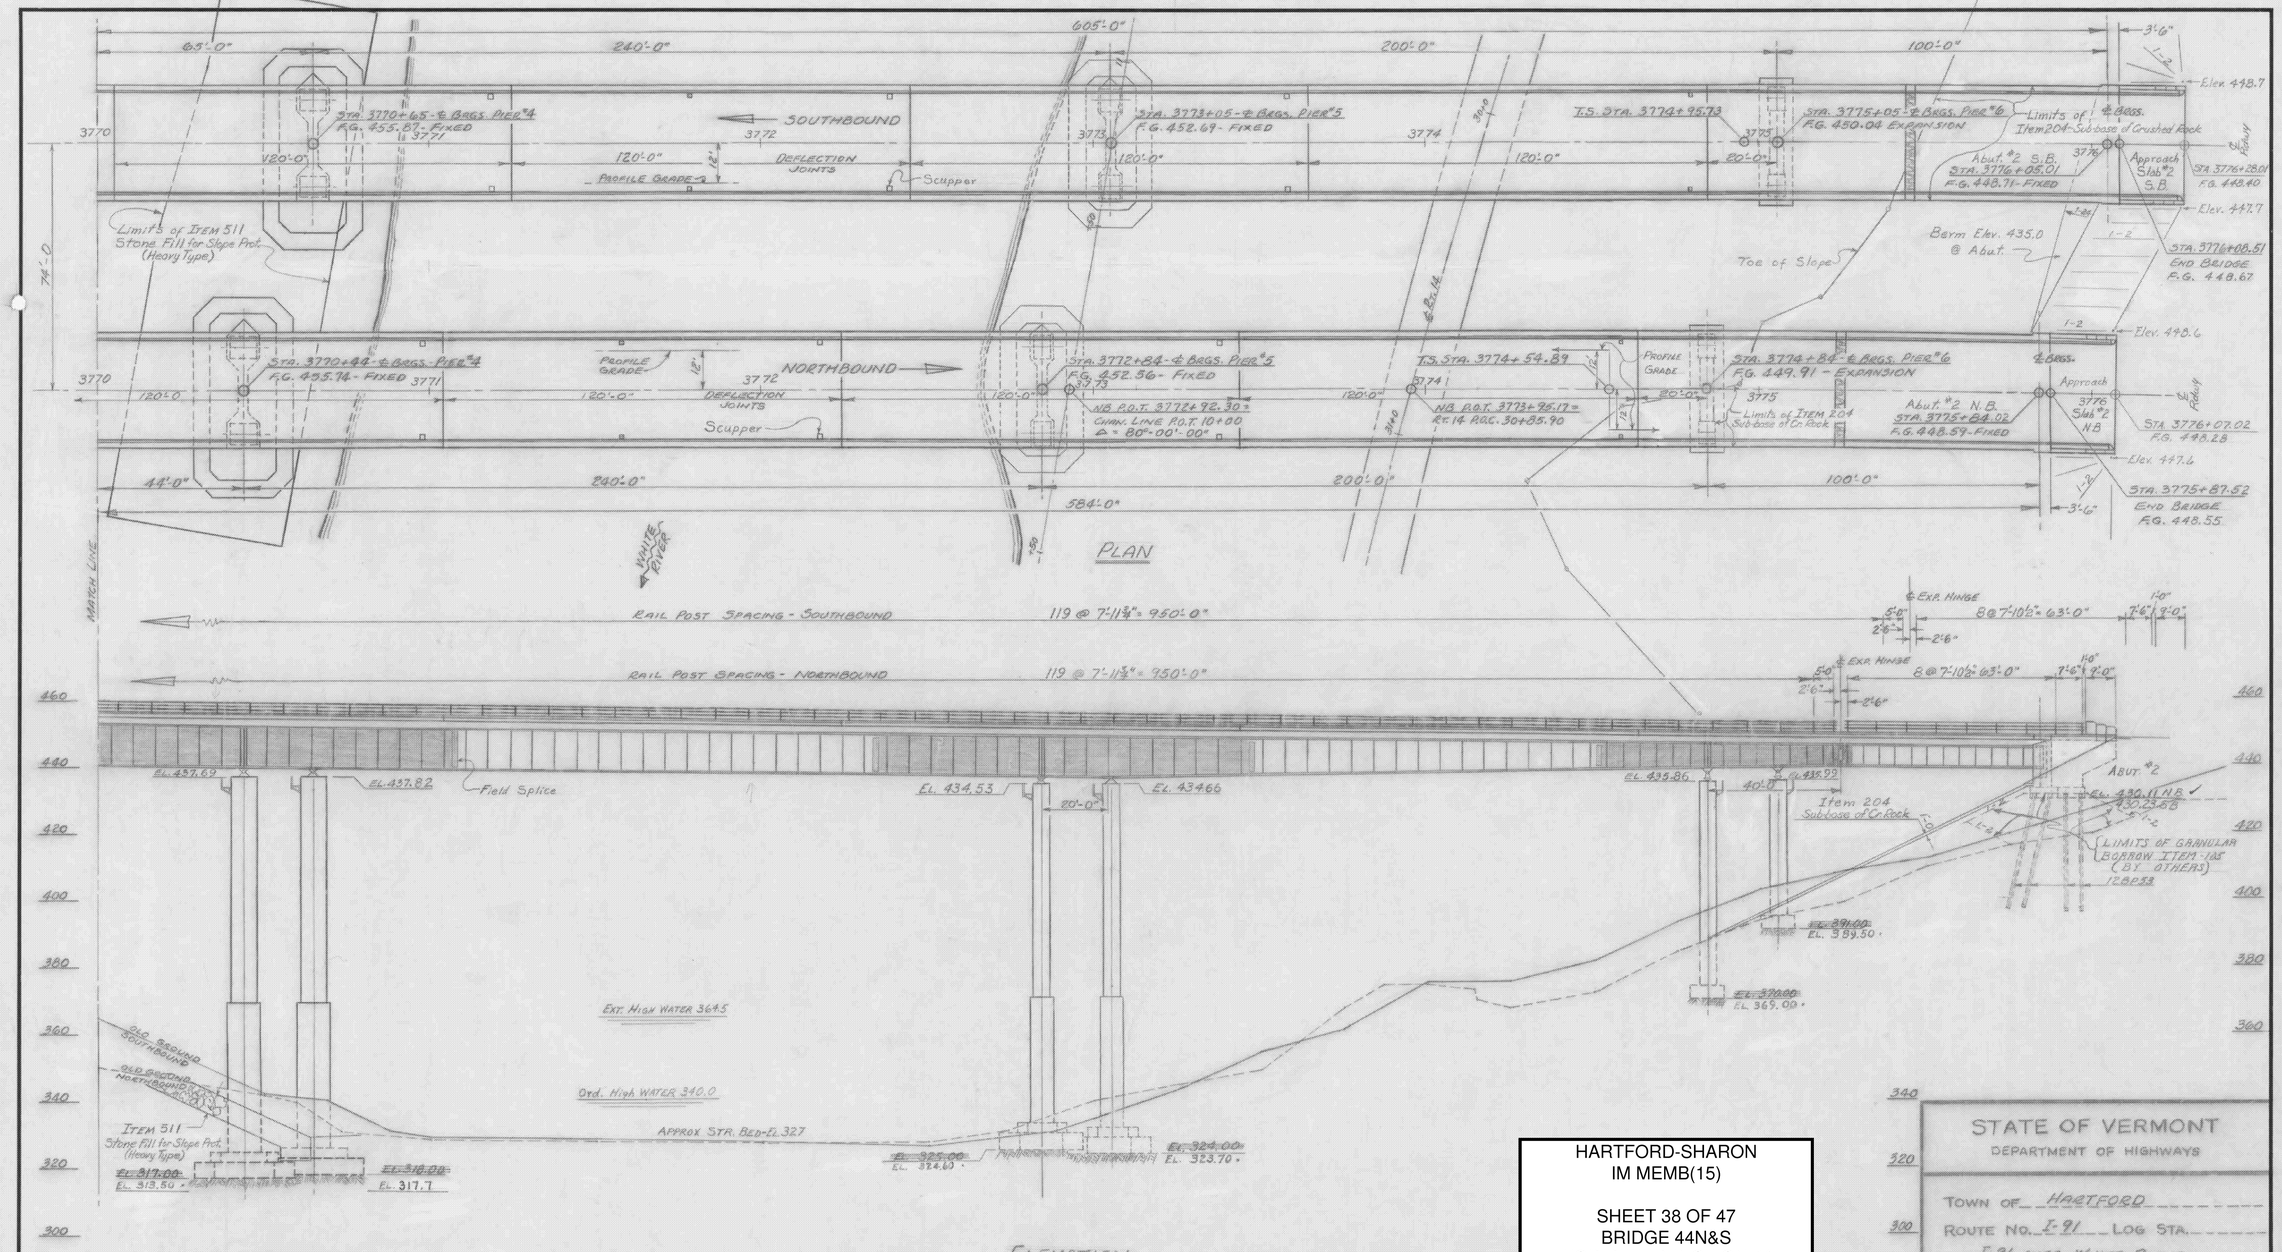

HARTFORD-SHARON
IM MEMB(15)

SHEET 38 OF 47
BRIDGE 44N&S
FOR REFERENCE ONLY

NOTE - Shaded areas of Girder in the elevation view indicate that Girder material is A.S.T.M. A-441 low-alloy, high strength steel. Remainder of Girder is A.S.T.M. A36 carbon steel.

BR 403 of 405

STATE OF VERMONT
DEPARTMENT OF HIGHWAYS

TOWN OF HARTFORD
ROUTE NO. I-91 LOG STA.
I-91 OVER WHITE RIVER
PLAN AND ELEVATION
SCALE 1" = 20'-0"
SURVEYED BY LOVETT & WATSON
DRAWN BY R.E.B. & R.L.M. CHECKED BY N.B.T.
PROJECT NO. I-91-2(3) (22)
SHEET 12 OF 60 63 of 175