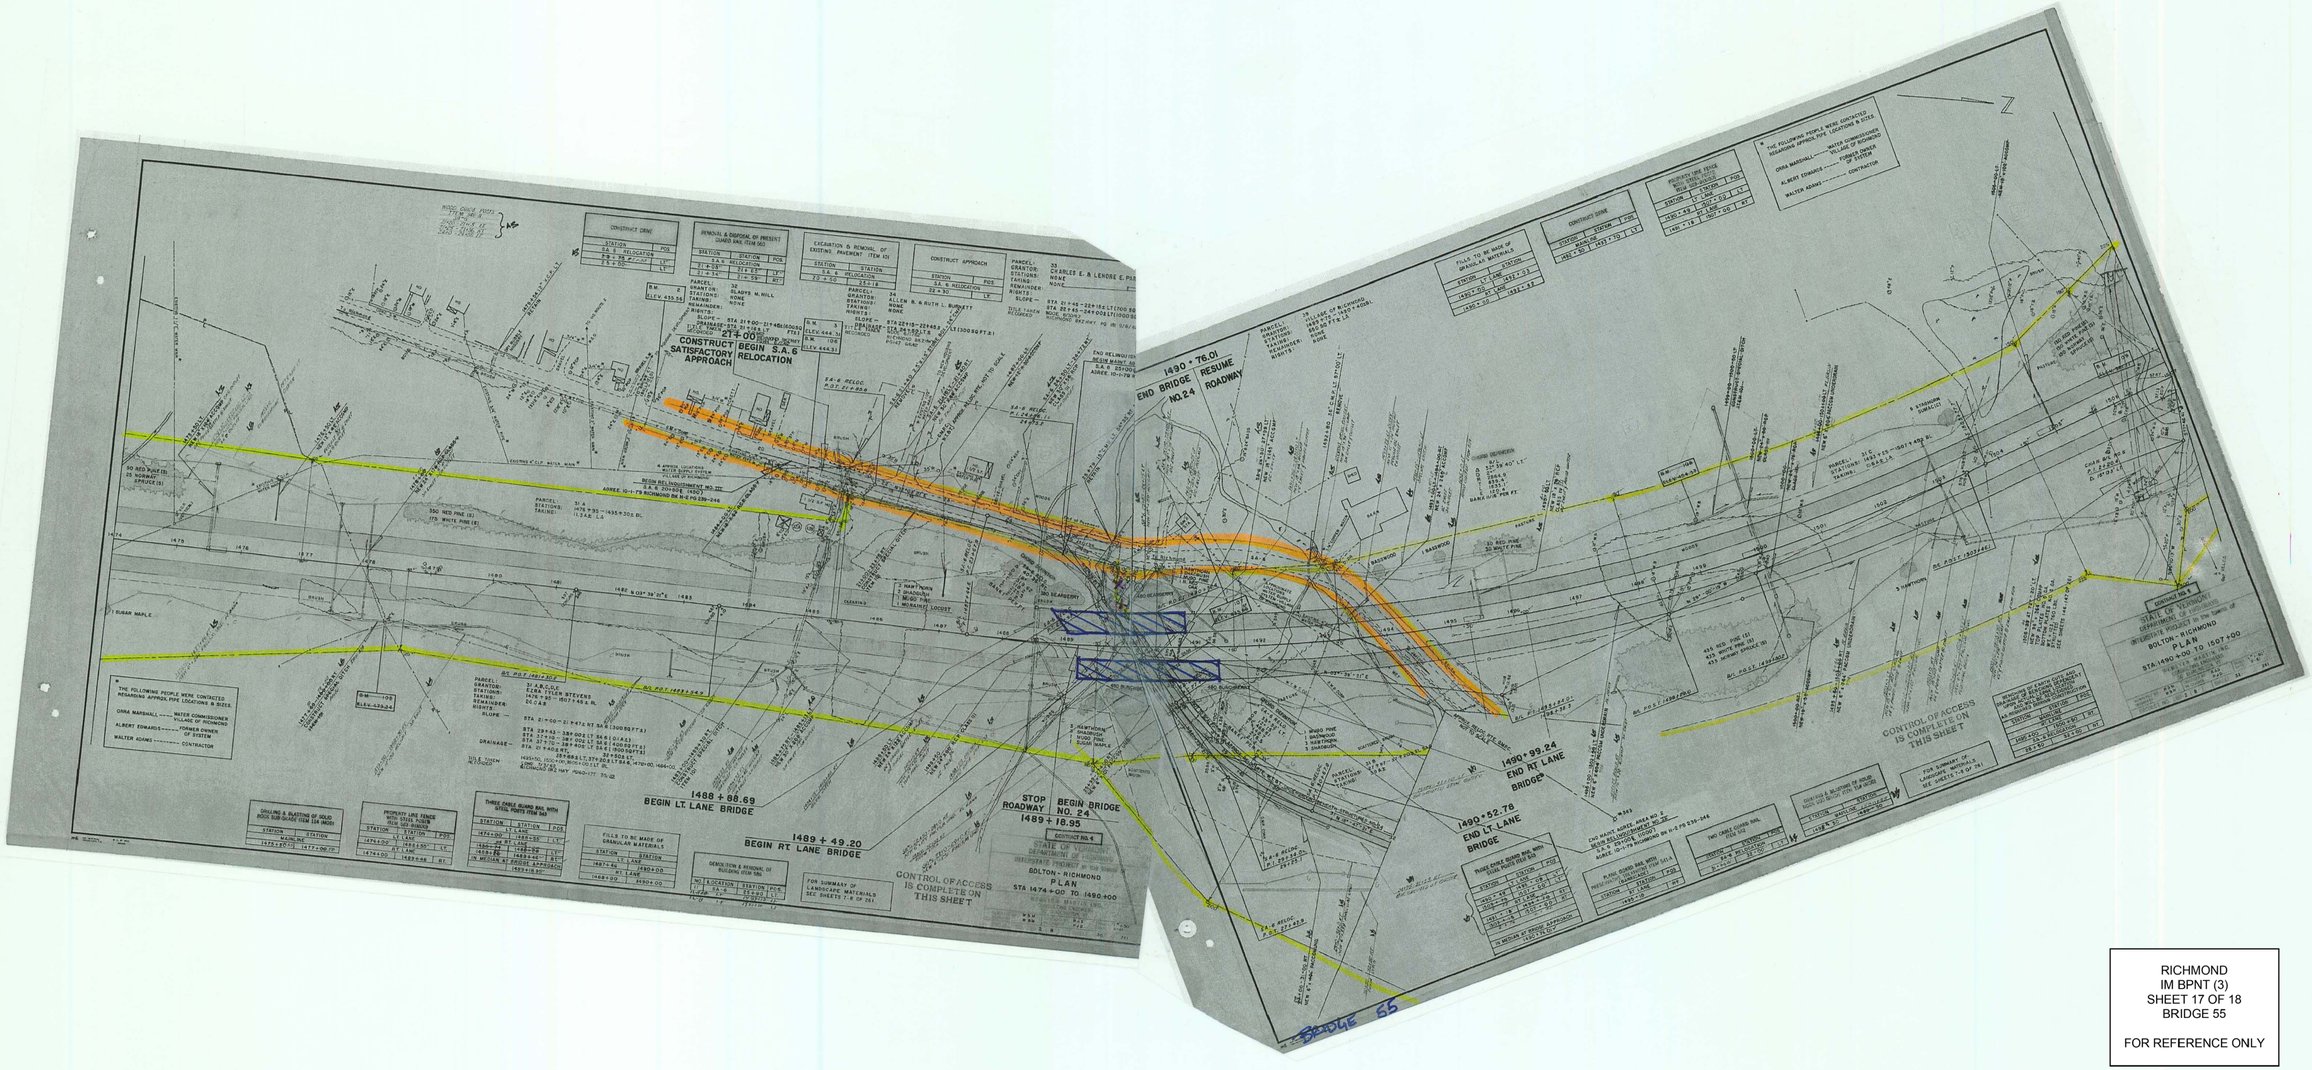

RICHMOND
IM BPNT (3)
SHEET 17 OF 18
BRIDGE 55

FOR REFERENCE ONLY