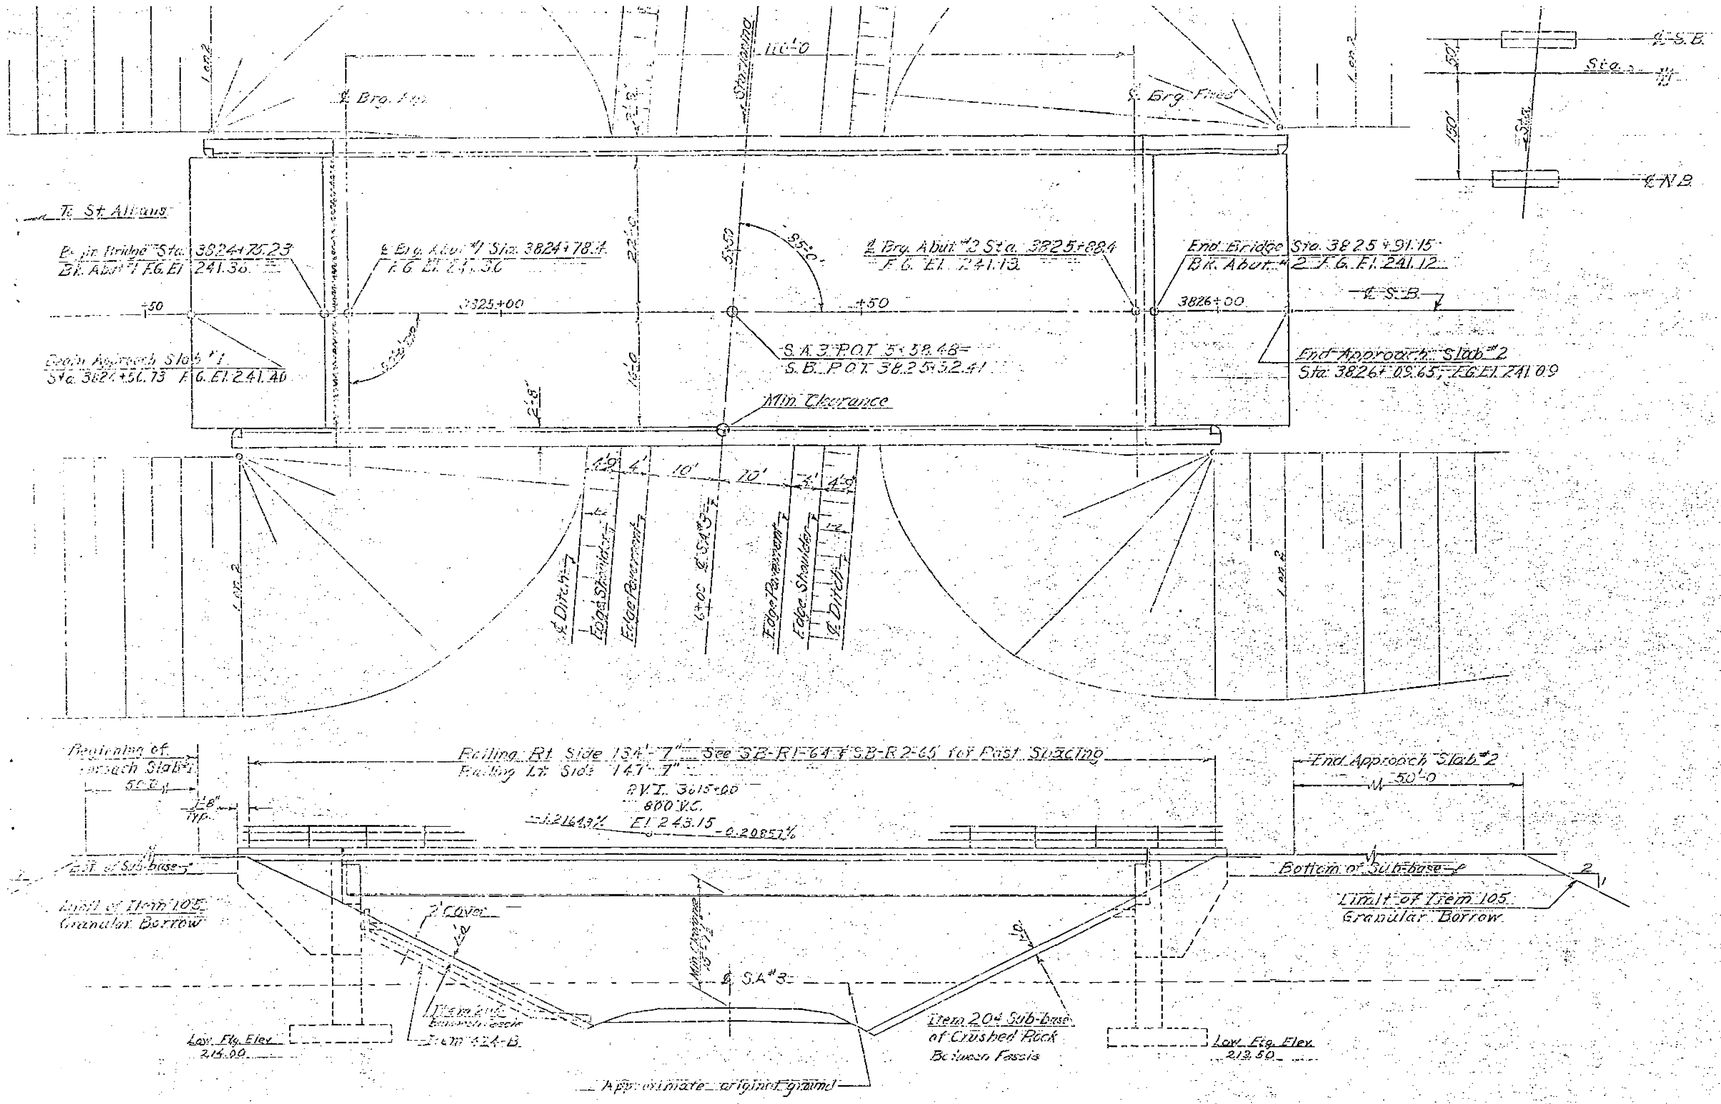

GENERAL NOTES

1. Elevation datum sea level based on nearest U.S. Government Vertical Control.
2. Footings are designed for 4 k.s.f. bearing on earth.
3. For additional General Notes see Standard SCB-D1-65

LIST OF BRIDGE SHEETS

Br. 200 S.B. Plan and Elevation
Br. 201 N.B. Plan and Elevation; Approach Slab and Joint Details
Br. 202 Bridge Quantity Sheet
Br. 203 Preliminary Information Sheet
Br. 204-205 Borings
Br. 206 Superstructure and Girder Details
Br. 207 Typical Cross Section and Details of Bearing Devices
Br. 208 Expansion Dam Details
Br. 209-212 Abutments No. 1-4 Details
Br. 213-214 Reinforcing Steel Schedule

BRIDGE STANDARDS

SCB-3B-65
SCB-D1-65
SCB-D2-65 Det. "K" & "B"
SCB-D4-65
SCB-D6-65
SB-R1-64 Sheets 1 & 2
SB-R2-65
SCB Sheets 5 & 6

REFERENCE SHEETS

I-89 Roadway Plan Sheet Sta. 3812 to 3828.
I-89 Roadway Profile Sheet Sta. 3812 to 3828.
I-89 Roadway Sections S.B. & N.B. Sta. 3824+00 to 3828+00
S.A. 3 Roadway Plan & Profile Sheet Sta. 0+00 to 15+00.
S.A. 3 Roadway Sections Sta. 4+00 to 10+00.

BR 200 OF 214

Revised Footing and Notes. W.B.T. 5-13-66

REF. NO.	ITEM	UNIT	NET		TOTAL	FINAL
	CHAN. EXCAV. OF EARTH	C.Y.				
	CHAN. EXCAV. OF ROCK	C.Y.				
	UNCLASS. CHAN. EXCAV.	C.Y.				
	STRUCT. EXCAV.	C.Y.				
	[illegible]	[illegible]				
	[illegible]	[illegible]				
	[illegible]	[illegible]				
	[illegible]	C.Y.				
	[illegible]	[illegible]				
	STRUCTS. [illegible]	[illegible]				
	[illegible]	[illegible]				
	[illegible]	[illegible]				

STATE OF VERMONT
DEPARTMENT OF HIGHWAYS

PROJECT NAME: ST. ALBANS - SWANTON
TOWN OF SWANTON
I-89
F.G. OVER S.A. 3 & S.B. STA. 3825+32
SOUTHBOUND PLAN & ELEVATION
1" = 10'-0"
Specifications
R.T.S. & E.
I-89-3 [illegible]
[illegible] A 153

ST. ALBANS - HIGHGATE
IM BPNT(4)
SHEET 17 OF 32
BRIDGE 94N&S
FOR REFERENCE ONLY