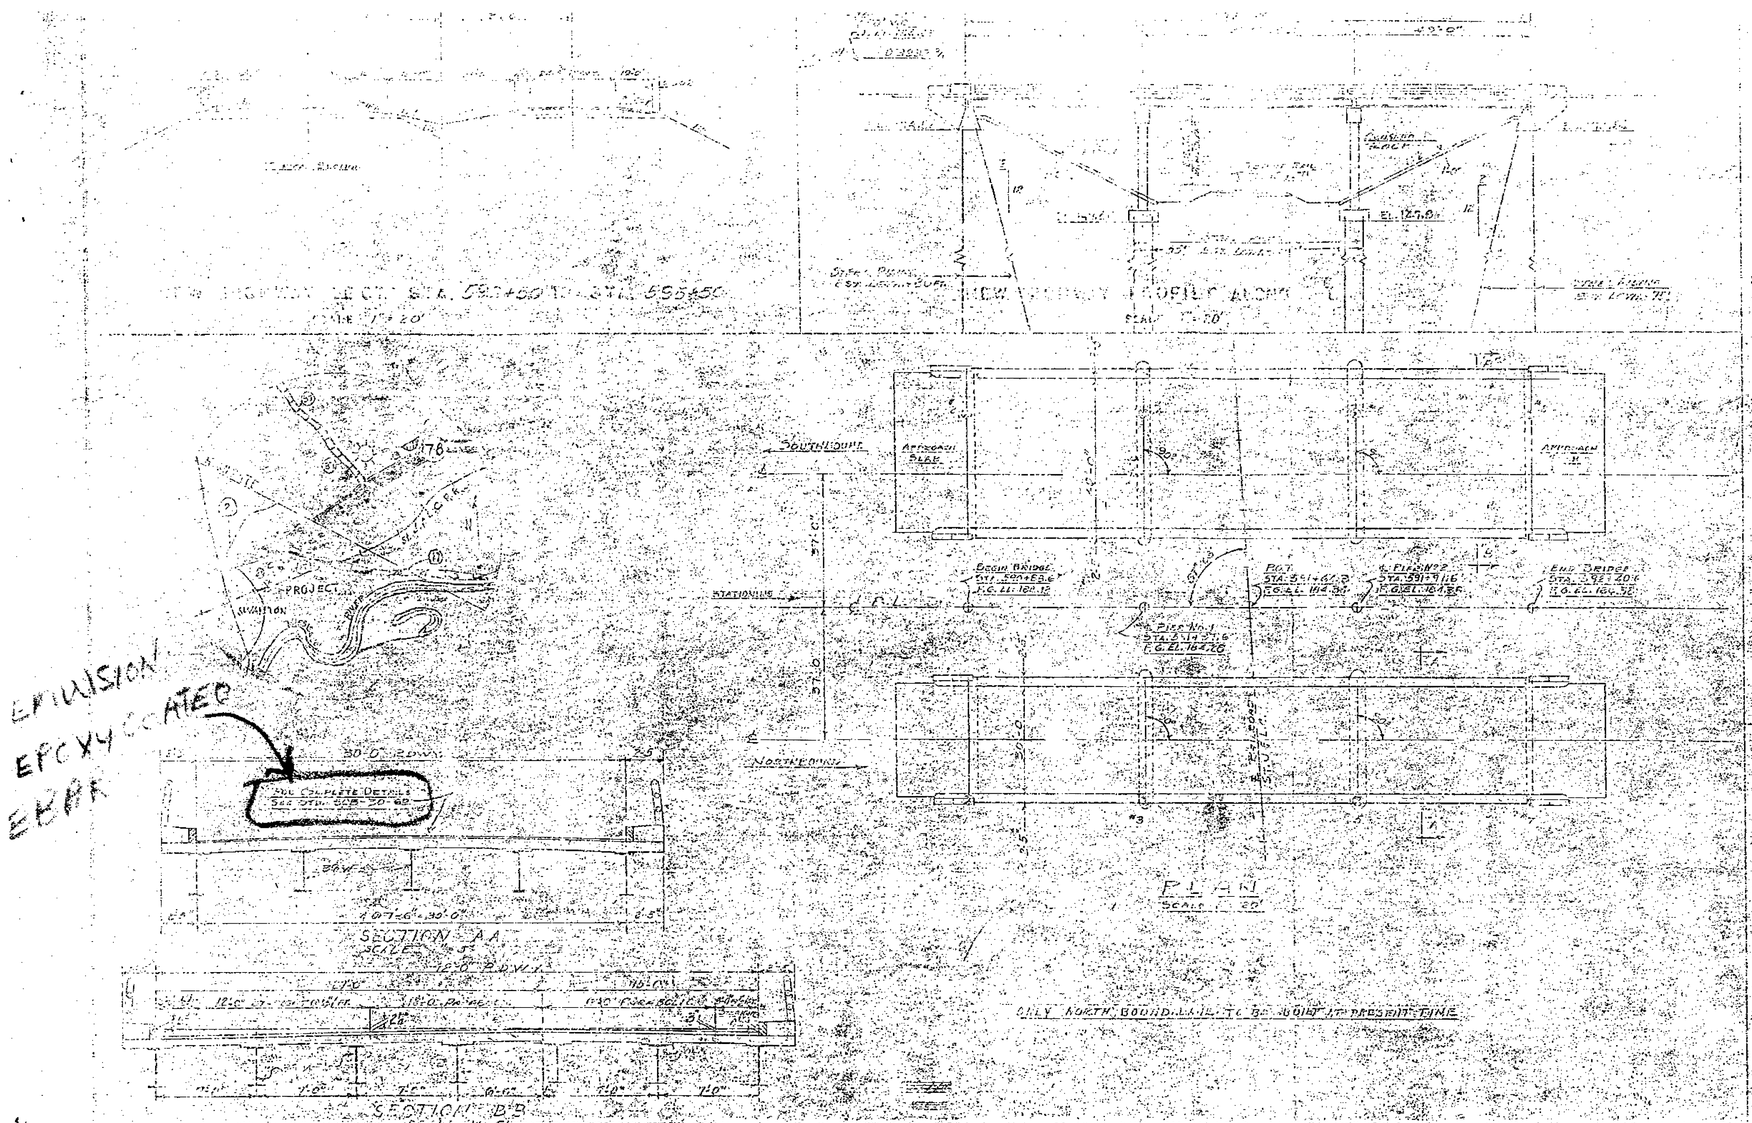

EMULSION
EPOXY COATED
REBAR

STRUCTURE

FOUNDATION INFORMATION

Design Specifications:
AASHTO 1961 Edition and its Amendments
VT Vermont Dept. of Highways

Live Load:
H20-S16-44 and Military Loading

Design Stresses:
Struct. Steel - 20 KSI
Reinf. Steel - 20 KSI
Concrete - 3000 PSI

ST. ALBANS - HIGHGATE
IM BPNT(4)
SHEET 24 OF 32
BRIDGE 97N&S
FOR REFERENCE ONLY

DR 303 OF 319

STATE OF VERMONT
DEPARTMENT OF HIGHWAYS

INTERSTATE BRIDGE
ST. ALBANS - HIGHGATE