STATE OF VERMONT
AGENCY OF TRANSPORTATION

TRAFFIC SIGN SUMMARY SHEET

MILEMARKER, STATION, OR SIGN NUMBER	SIGN LEGEND	SIGN DIMENSIONS EA	WIDTH (in)	HEIGHT (in)	NEW & SALVAGED SIGNS "A"	"B"	SALV SIGN	SALV TIS	EXIST POST RETAIN	EXIST POST SALVAGE	NEW SIGN POSTS NO. OF POSTS	FLANGED CHANNEL lb/ft 1.12	2.0	3.0	SQUARE STEEL (in) lb/ft 1.75 1.88	2.0 2.42	2.5 3.35	ANCHOR	SLEEVE	TUBULAR ALUMINUM Ø (in) lb/ft 3.0 1.3	4.0 1.7	4.0 MOD 1.7	FOUNDATION	TUBULAR STEEL Ø (in) lb/ft 3.0 7.6	3.5 9.0	4.0 10.8	5.0 14.6	W-SHAPE STEEL FTG. SIZE 24"	30"	WEIGHT	POST SIZE	SIGN REQUIRED FRAME	REMARKS	SIGN DETAIL DETAIL ON SHEET NUMBER	STD. SHEET NUMBER
											OPTION ITEMS																										
SOUTHBOUND MM 129.910 LT		1	36	36	9.00						2					X		X																R3-4		SHS
SOUTHBOUND MM 129.880 LT		1	36	12	3.00						2					X		X																R6-1R		SHS
SOUTHBOUND MM 129.879 RT		1	48	48	16.00						2						X	X																VR-654		E-143
		1	24	18	3.00																													VR-655P	46	
SOUTHBOUND MM 129.831 RT		1	6	10	0.42						1				X			X																VD-701		E-134
SOUTHBOUND MM 129.850 ~~LT~~ RT		1 1	48 24	48 18	16.00 3.00						2						X	X																VW-397 MOUNT VW-397 ABOVE VP-396 VP-396	46	E-153B
SOUTHBOUND MM 129.820 RT		1	96	30	20.00						3																	3		1140	W8X21		EI-5 FUSE PLATE BOLT TENSION = 28.4 KIPS NEED SPECIAL 8' W-SHAPE FOOTINGS. SEE CROSS SECTION AND DETAIL ON SHEET 2.	38	
	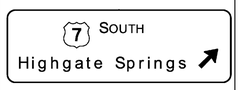	1	312	102		221.00																												EI-1	38	
		1	30	30	6.25																													D9-11		SHS
SOUTHBOUND MM 129.782 RT	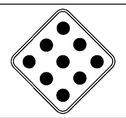	1	18	18	2.25						1					X		X																OMI-1		SHS
					SF 78.92	SF 221.00	EA.	SF				FT	FT	FT	FT 8	FT 75.00	FT 60		EA	LB	LB	LB	EA	LB	LB	LB	LB	EA. 3	EA.	LB. 1140					

FINAL POST LENGTHS ARE TO BE DETERMINED IN THE FIELD. POST SIZES ARE COMPUTED BASED ON INFORMATION FURNISHED ON THE VTRANS STANDARD SHEETS AND "SIGN POST DESIGN GUIDELINE".

FT FT FT FT 8 | FT 75.00 FT 60 | EA | LB LB LB | LB LB LB LB

FT 143.00 | LB | EA. | LB

SOUTHBOUND TRAFFIC SIGN SUMMARY SHEET 1

PROJECT NAME: COLCHESTER-HIGHGATE
PROJECT NUMBER: IMG SIGN (17)

FILE NAME: 09A016.DGN
PROJECT LEADER: EPD
DESIGNED BY: BMB
PLOT FILE: 09A016TSSSSBI.i

PLOT DATE: 8/20/2009
DRAWN BY: BMB
CHECKED BY: EPD
SHEET 94 OF 221