INDEX OF SHEETS
SEE SHEET 2

STATE OF VERMONT
AGENCY OF TRANSPORTATION

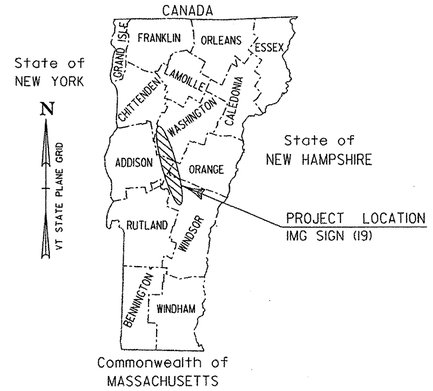

PROPOSED IMPROVEMENT
TOWNS OF ROYALTON, BETHEL, RANDOLPH, BROOKFIELD, WILLIAMSTOWN, BERLIN, MONTPELIER & MIDDLESEX
COUNTIES OF WINDSOR, ORANGE & WASHINGTON

VERMONT INTERSTATE ROUTE 89

BEGINNING AT THE ROYALTON EXIT 3 INTERCHANGE ON INTERSTATE 89 AT MILE MARKER 22.000 AND EXTENDING NORTHERLY FOR BOTH THE NORTHBOUND AND SOUTHBOUND LANES A DISTANCE OF 38.880 MILES AND ENDING AT THE MIDDLESEX-WATERBURY TOWN LINE AT MILE MARKER 60.880.

LENGTH OF ROADWAY = 38.880 MILES
LENGTH OF PROJECT = 38.880 MILES

WORK TO BE PERFORMED UNDER THIS PROJECT INCLUDES THE REMOVAL OF EXISTING SIGNS AND POSTS AND THE INSTALLATION OF NEW SIGNS AND SIGN POSTS AND ASSOCIATED ELEMENTS ALONG THE PROJECT LENGTH, RAMPS, INTERCHANGES AND INCIDENTAL ITEMS.

RECORD PLANS

CONTRACTOR: CCS CONSTRUCTORS LLC– MORRISVILLE, VT
RESIDENT ENGINEER: AL JONES
CONSTRUCTION BEGAN: APRIL 6, 2010
CONSTRUCTION COMPLETE: MAY 23, 2011
RECORD PLANS BY: AL JONES & JENNA HYDE

I HEREBY CERTIFY THAT ALL THE CONSTUCTION REQUIRED BY THIS SET OF DRAWINGS HAS BEEN ACCOMPLISHED AS INDICATED HEREIN.

BY al Jones RESIDENT ENGINEER
DATE 3/29/13

NOTE: Any further information concerning final quantities, amounts or other details relative to this project may be found at Central Files in the electronic archives.

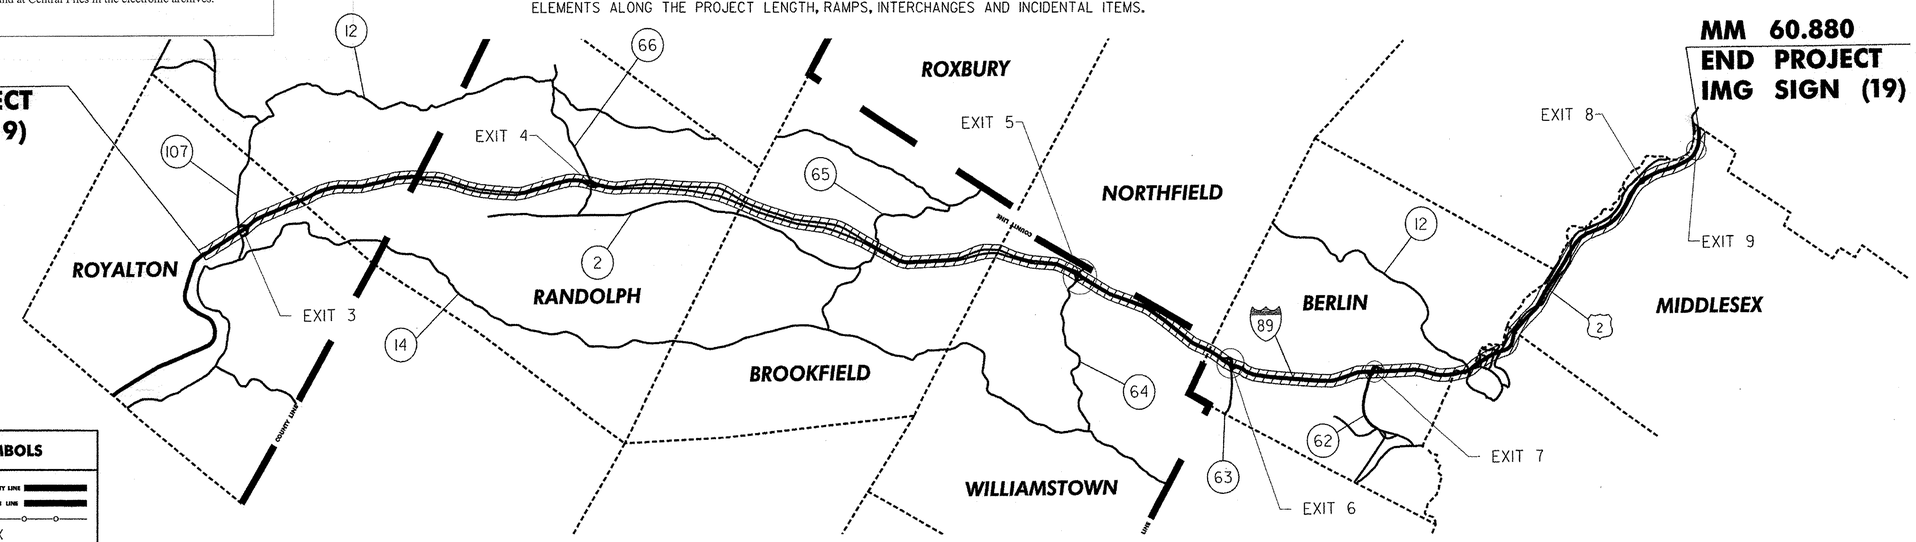

CONVENTIONAL SYMBOLS

COUNTY LINE
TOWN LINE
LIMITS OF ACCESS
POINT OF ACCESS
FENCE LINE
STONE WALL
TRAVELED WAY
GUARD RAIL
RAILROAD
SURVEY LINE
CULVERT
POWER POLE
TELEPHONE POLE
TREES
CONTROL OF ACCESS
PROPERTY LINE
R.O.W. TAKING LINE
SLOPE RIGHTS
TOP OF CUT
TOE OF SLOPE

SURVEYED BY : N/A
SURVEYED DATE : N/A

DATUM
VERTICAL N/A
HORIZONTAL N/A

CONSULTING ENGINEERS Inc.
540 Commercial Street Manchester, NH 03101
(603) 668-8223 • Fax: (603) 668-8802
email: cle@cleengineers.com • www.cleengineers.com
Maine • New Hampshire • Vermont

STATE OF VERMONT REGISTERED PROFESSIONAL ENGINEER No. 5529 CHRISTOPHER R. BEAM

2 0 2
SCALE IN MILES

THESE PLANS ARE SUBJECT TO SUCH ENGINEERING CHANGES AS MAY BE REQUIRED BY THE FEDERAL HIGHWAY ADMINISTRATION OR THE DIRECTOR OF PROGRAM DEVELOPMENT.

CONSTRUCTION IS TO BE CARRIED ON IN ACCORDANCE WITH THESE PLANS AND THE STANDARD SPECIFICATIONS FOR CONSTRUCTION DATED 2006, AS APPROVED BY THE FEDERAL HIGHWAY ADMINISTRATION ON JUNE 15, 2006 FOR USE ON THIS PROJECT, INCLUDING ALL SUBSEQUENT REVISIONS AND SUCH REVISED SPECIFICATIONS AND SPECIAL PROVISIONS AS ARE INCORPORATED IN THESE PLANS.

DIRECTOR OF PROGRAM DEVELOPMENT
APPROVED Peter B. Thomas DATE 8-19-09

PROJECT MANAGER : AMY GAMBLE

PROJECT NAME : ROYALTON - MIDDLESEX
PROJECT NUMBER : IMG SIGN (19)

SHEET 1 OF 163 SHEETS

MODEL: Cover z09a020cov.dgn