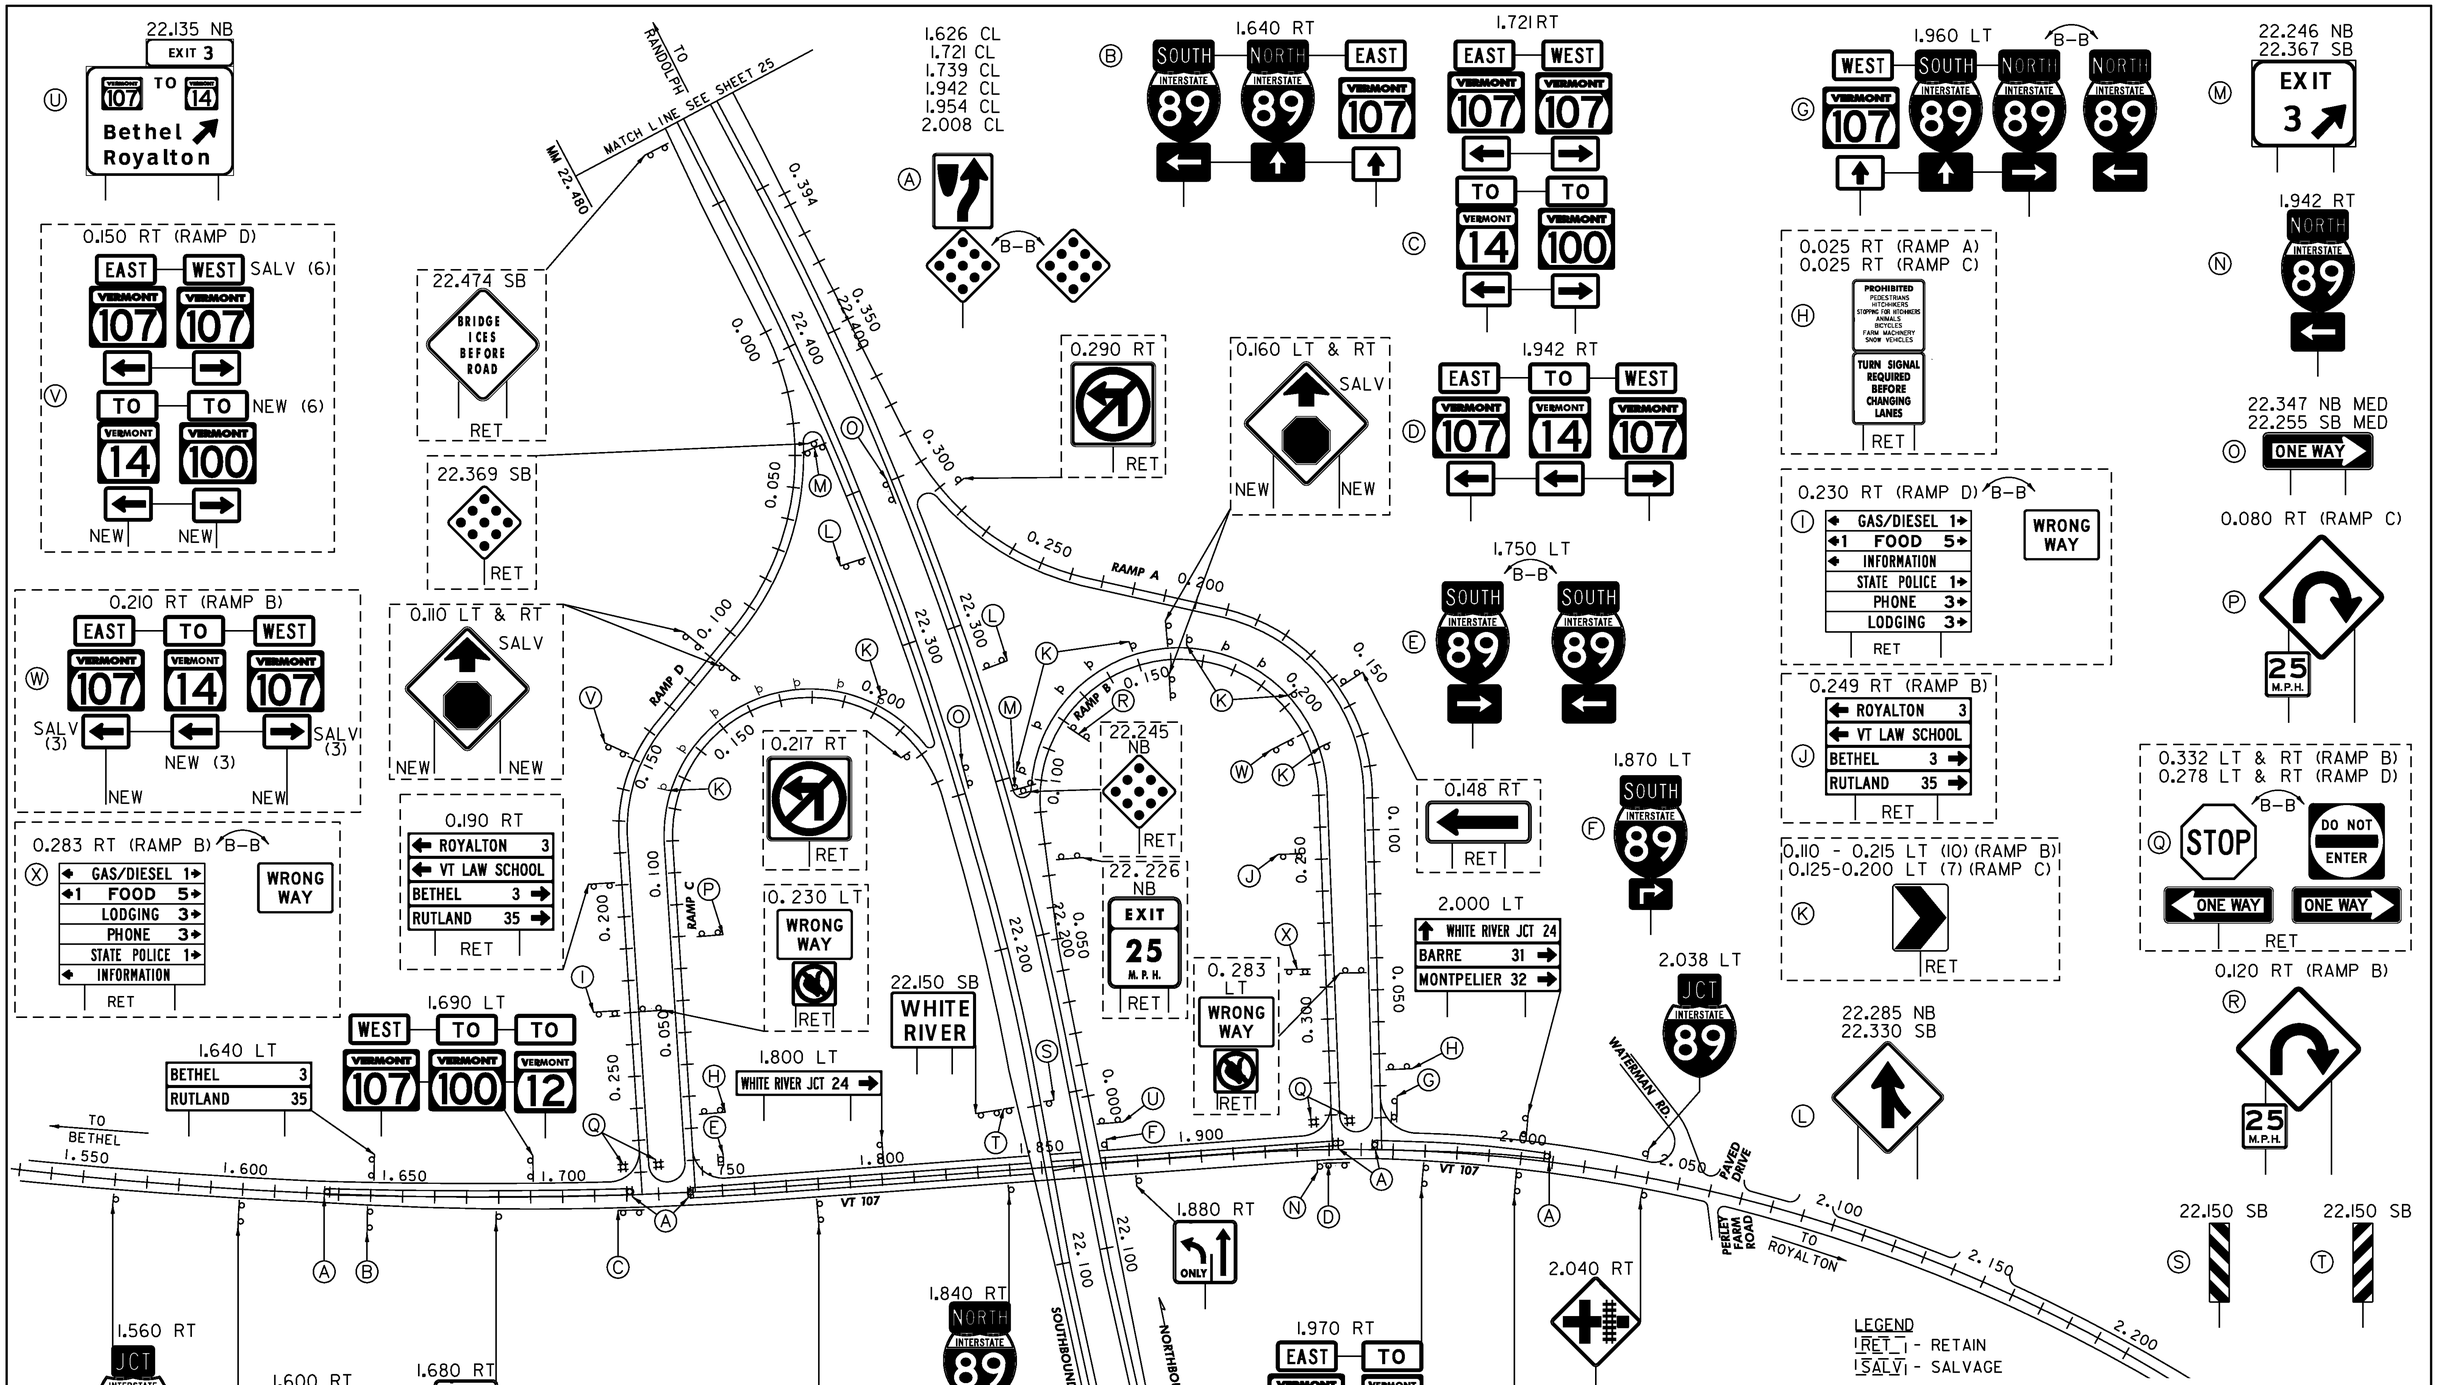

ALL RETAINED SIGNS THIS SHEET INSTALLED UNDER IM 089-1(54)
ALL SIGNS AND POSTS ARE NEW UNLESS OTHERWISE NOTED

INTERCHANGE 3 NEW SIGNS

PROJECT NAME: ROYALTON-MIDDLESEX
PROJECT NUMBER: IMG SIGN(19)

FILE NAME: z09a020int03.dgn
PROJECT LEADER: CRB
DESIGNED BY: BDB
CLD REF. NO.: 09-0106
PLOT DATE: 8/12/2009
DRAWN BY: JBZ
CHECKED BY: DAM
SHEET 33 OF 163

MODEL: NEW