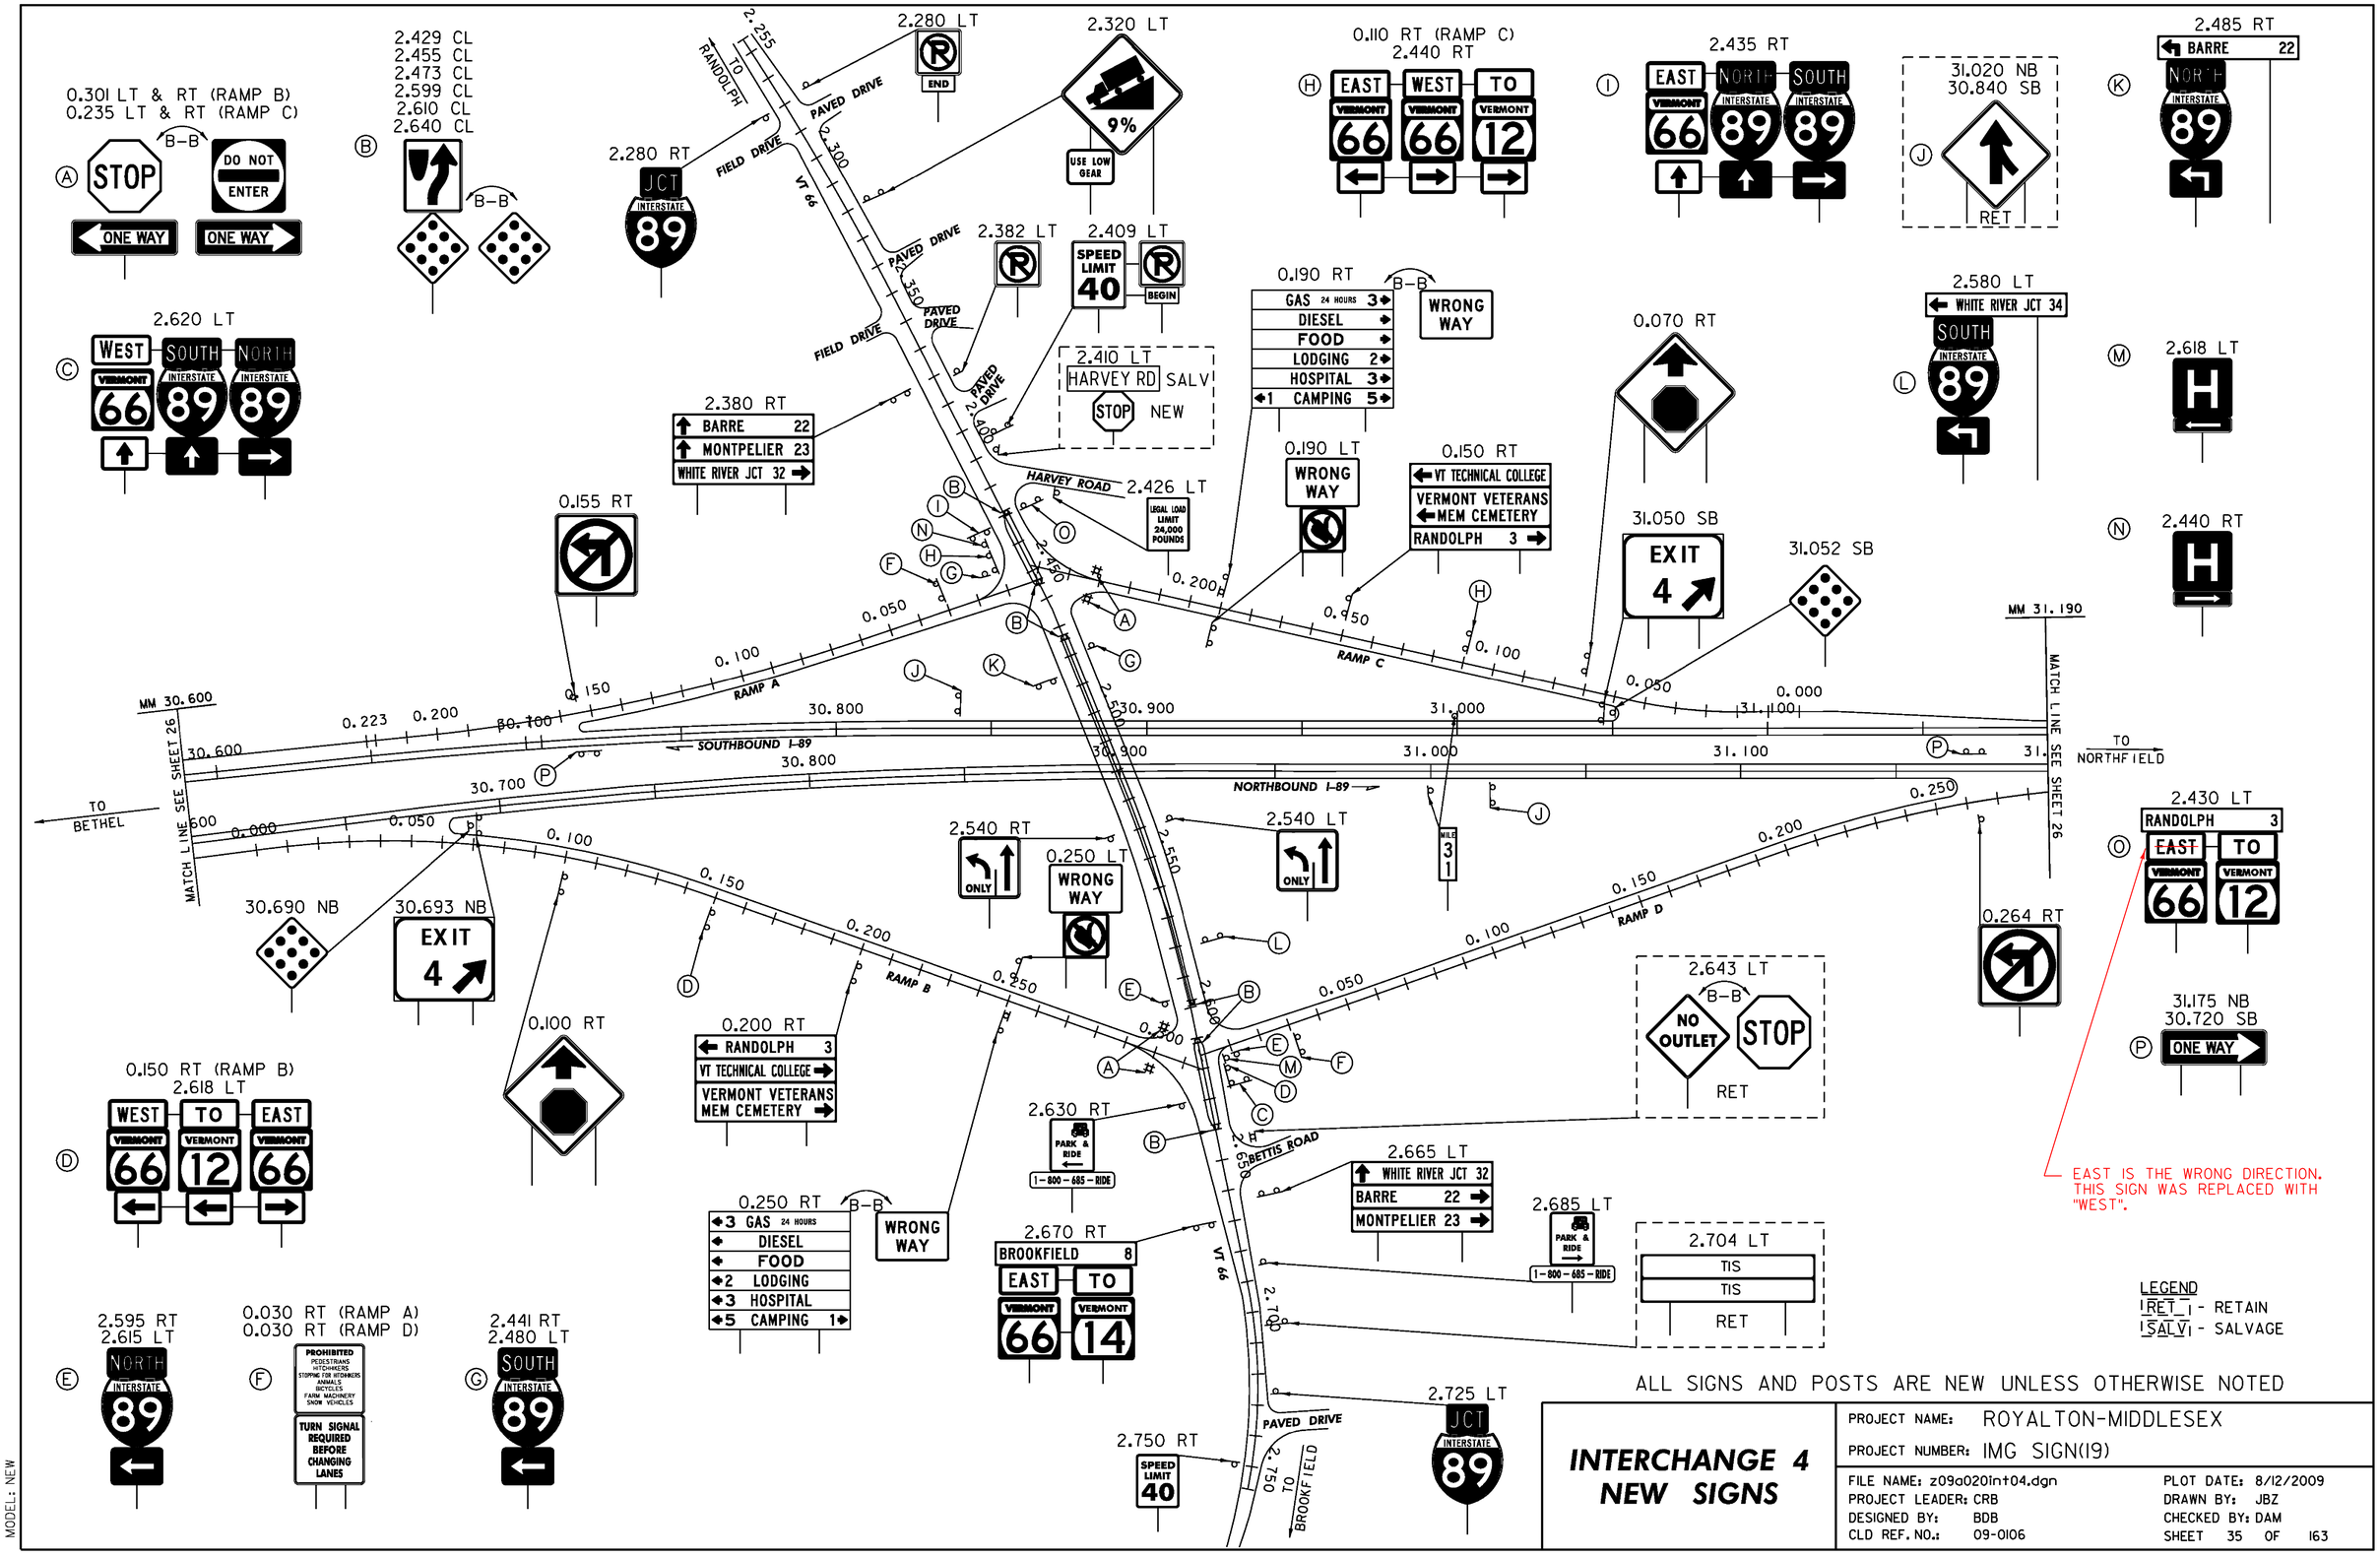

ALL SIGNS AND POSTS ARE NEW UNLESS OTHERWISE NOTED

INTERCHANGE 4 NEW SIGNS

PROJECT NAME: ROYALTON-MIDDLESEX
PROJECT NUMBER: IMG SIGN(19)

FILE NAME: z09a0201n+04.dgn
PROJECT LEADER: CRB
DESIGNED BY: BDB
CLD REF. NO.: 09-0106
PLOT DATE: 8/12/2009
DRAWN BY: JBZ
CHECKED BY: DAM
SHEET 35 OF 163