NOTE
FOR TYPICAL PLACEMENT OF DELINEATORS
SEE STANDARD E-197 AND SHEET 4.

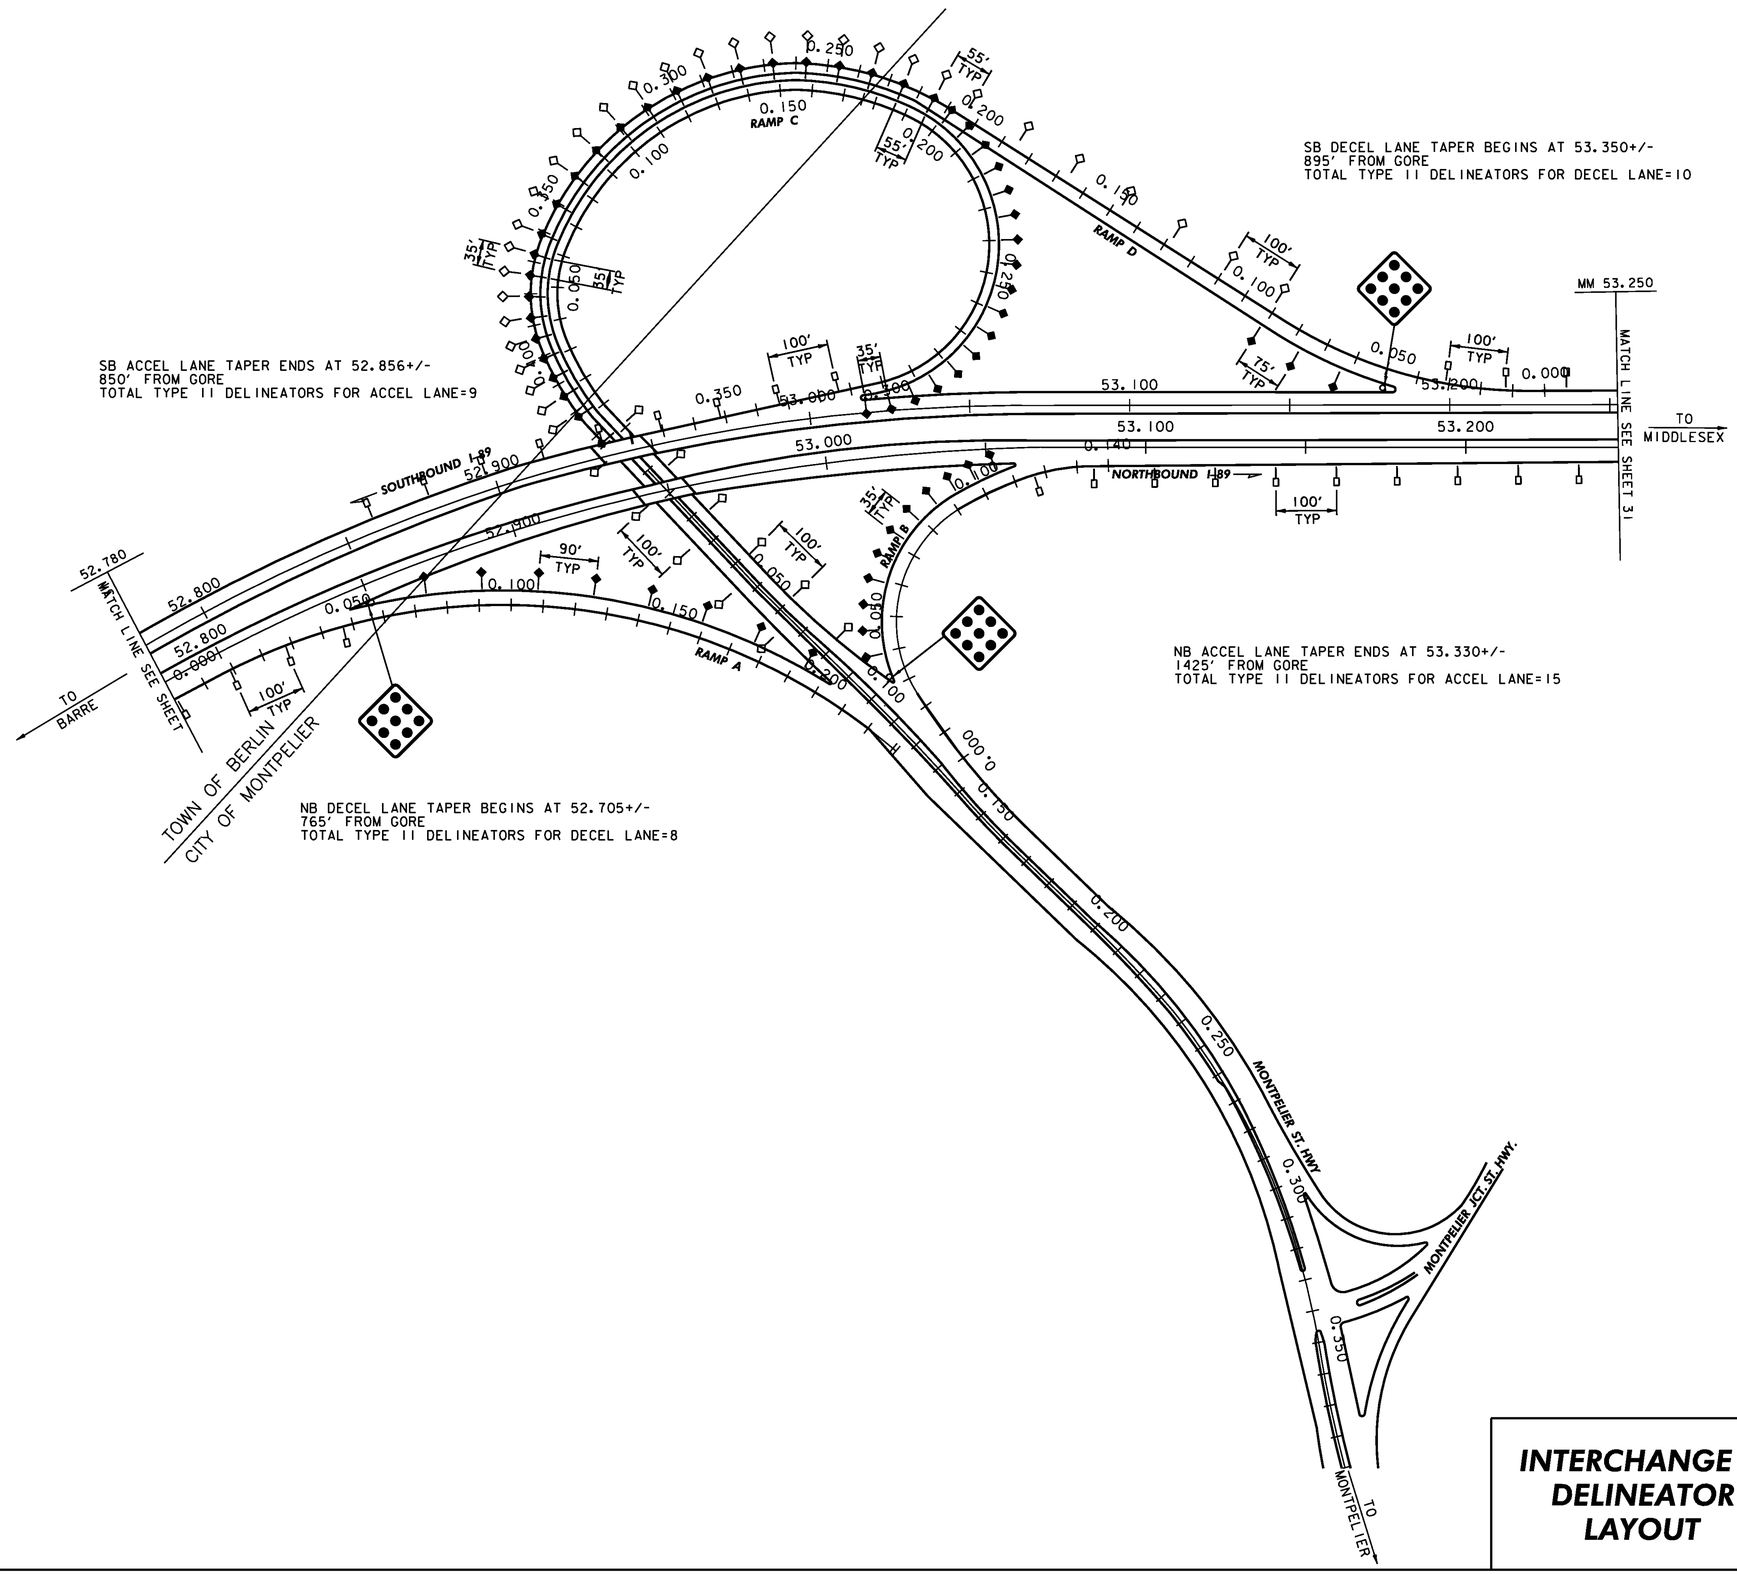


## LEGEND

- TYPE I (YELLOW)
- TYPE I (WHITE)
- TYPE II (WHITE)
- TYPE III (YELLOW, RED ON BACK)
- TYPE III (WHITE, RED ON BACK)

**INTERCHANGE 8 DELINEATOR LAYOUT**

PROJECT NAME: ROYALTON-MIDDLESEX
PROJECT NUMBER: IMG SIGN(19)

FILE NAME: z09a0201n+08.dgn
PROJECT LEADER: CRB
DESIGNED BY: BDB
CLD REF. NO.: 09-0106
PLOT DATE: 8/12/2009
DRAWN BY: JBZ
CHECKED BY: BDB
SHEET 51 OF 163

MODEL: DELIN