STATE OF VERMONT
AGENCY OF TRANSPORTATION

TRAFFIC SIGN SUMMARY SHEET 17

MILE MARKER, STATION OR SIGN NUMBER	SIGN LEGEND	SIGN DIMENSIONS E A	WIDTH (in)	HEIGHT (in)	NEW & SALVAGED SIGNS "A"	"B"	SALV SIGN	SALV TIS	EXIST POST RETAIN	EXIST POST SALVAGE	NEW SIGN POSTS NO. OF POSTS	FLANGED CHANNEL lb/ft 1.12	2.0	3.0	SQUARE STEEL (in) lb/ft 1.75 1.88	2.0 2.42	2.5 3.35	ANCHOR	SLEEVE	TUBULAR ALUMINUM DIA (in) lb/ft 3.0 1.3	4.0 1.7	4.0Mod 1.7	FND-ATION	TUBULAR STEEL DIA (in) lb/ft 3.0 7.6	3.5 9.0	4.0 10.8	5.0 14.6	W-SHAPE STEEL FTG. SIZE 24"	30"	WEIGHT	POST SIZE	SIGN	FRAME	REMARKS	SIGN DETAIL DETAIL ON SHEET NUMBER	STD. SHEET NUMBER
59.490 NB MED		1	36	36	9.00						2					X		2															R3-4		
59.550 NB	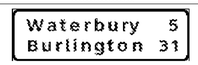	1	108	36		27.00					2										X												138	
59.800 NB		1	48	60	20.00						2												2	X								VR-132	144	
59.800 NB MED		1	48	60	20.00						2												2	X								VR-132	144	
60.000 NB		1	12	36	~~3.00~~ 4.00						1					X		1														D10-2		E-139
60.880 NB	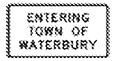	1	36	24	6.00						2					X		2														I-2		E-131

								FT	FT	FT	FT	FT 73.7	FT		EA.	LB	LB 54.4	LB		LB 440.8	LB	LB	LB						
SHEET TOTALS	SF ~~58.00~~ 55.00	SF 27.00	EA.	SF		FT			FT 73.7					LB 54.4		EA. 4			LB 440.8				EA.	EA.	LB				

FINAL POST LENGTHS ARE TO BE DETERMINED IN THE FIELD. POST SIZES ARE COMPUTED BASED ON INFORMATION FURNISHED ON THE STANDARD SHEETS AND THE VTRANS "SIGN POST DESIGN GUIDELINE".

PROJECT NAME: ROYALTON - MIDDLESEX
PROJECT NUMBER: IMG SIGN(19)

FILE NAME: 090106_tss_main_NB.xls
PROJECT LEADER: CRB
DESIGNED BY: BDB
PLOT DATE: 8/12/2009
DRAWN BY: SRB
CHECKED BY: DAM
TRAFFIC SIGN SUMMARY SHEET # 17
SHEET 69 OF 163