STATE OF VERMONT
AGENCY OF TRANSPORTATION

TRAFFIC SIGN SUMMARY SHEET 31

MILE MARKER, STATION OR SIGN NUMBER	SIGN LEGEND	SIGN DIMENSIONS EA	WIDTH (in)	HEIGHT (in)	NEW & SALVAGED SIGNS "A"	"B"	SALV SIGN	SALV TIS	EXIST POST RETAIN	EXIST POST SALVAGE	NEW SIGN POSTS NO. OF POSTS	FLANGED CHANNEL lb/ft 1.12	2.0	3.0	SQUARE STEEL (in) 1.75 lb/ft 1.88	2.0 lb/ft 2.42	2.5 lb/ft 3.35	ANCHOR	SLEEVE	TUBULAR ALUMINUM DIA (in) 3.0 lb/ft 1.3	4.0 lb/ft 1.7	4.0Mod lb/ft 1.7	TUBULAR STEEL DIA (in) FND-ATION	3.0 lb/ft 7.6	3.5 lb/ft 9.0	4.0 lb/ft 10.8	5.0 lb/ft 14.6	W-SHAPE STEEL FTG. SIZE 24"	30"	WEIGHT	POST SIZE	SIGN FRAME	REMARKS	SIGN DETAIL DETAIL ON SHEET NUMBER	STD. SHEET NUMBER
54.807 SB		1	12	36	3.00						1				X			1																OM-3R		
54.807 SB MED		1	12	36	3.00						1				X			1																OM-3L		
54.906 SB MED		1	36	36	9.00						2					X		2																R3-4		
54.925 SB		1	48	48	16.00						2									X														W8-13		
55.000 SB		1	12	36	~~3.00~~ 4.00						1					X		1																D10-2		E-139
55.259 SB		1	48	48	16.00						2												2	X											145	
56.000 SB		1	12	36	~~3.00~~ 4.00						1					X		1																D10-2		E-139
56.048 SB MED		1	36	36	9.00						2					X		2																R3-4		
57.000 SB		1	12	36	~~3.00~~ 4.00						1					X		1																D10-2		E-139
57.600 SB		1	48	60	20.00						2										X													VR-132	144	
57.600 SB MED		1	48	60	20.00						2												2	X											VR-132	144	
57.752 SB MED		1	36	36	9.00						2					X		2																R3-4		
57.850 SB	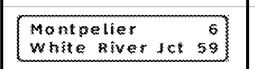	1	144	36		36.00					2												2		X										141	
57.950 SB		1	48	48	16.00																													VW-001	144	
	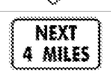	1	30	24	5.00						2										X														144	
58.000 SB		1	12	36	~~3.00~~ 4.00						1					X		1																D10-2		E-139
54.500	MOVE OVER SIGN					60.5																														
												FT	FT	FT	FT	FT	FT		EA.	LB	LB	LB		LB	LB	LB	LB									
															25.2	140.0				49.6	143.2			422.6	289.8											
	SUBTOTALS SHEET 31	SF ~~138.00~~ 126.00	SF ~~36.00~~ 96.50	EA.	SF			FT			FT 165.2				LB 192.8			EA. 6		LB 712.4				EA.	EA.	LB									

FINAL POST LENGTHS ARE TO BE DETERMINED IN THE FIELD. POST SIZES ARE COMPUTED BASED ON INFORMATION FURNISHED ON THE STANDARD SHEETS AND THE VTRANS "SIGN POST DESIGN GUIDELINE".

PROJECT NAME: ROYALTON - MIDDLESEX
PROJECT NUMBER: IMG SIGN(19)

FILE NAME: 090106_tss_main_SB.xls
PROJECT LEADER: CRB
DESIGNED BY: BDB
TRAFFIC SIGN SUMMARY SHEET # 31

PLOT DATE: 8/12/2009
DRAWN BY: SRB
CHECKED BY: DAM
SHEET 83 OF 163