STATE OF VERMONT
AGENCY OF TRANSPORTATION

TRAFFIC SIGN SUMMARY SHEET 36

MILE MARKER, STATION OR SIGN NUMBER	SIGN LEGEND	SIGN DIMENSIONS EA	WIDTH (in)	HEIGHT (in)	NEW & SALVAGED SIGNS "A"	"B"	SALV SIGN	SALV TIS	EXIST POST RETAIN	EXIST POST SALVAGE	NEW SIGN POSTS NO. OF POSTS	FLANGED CHANNEL lb/ft 1.12	2.0	3.0	SQUARE STEEL (in) 1.75 lb/ft 1.88	2.0 lb/ft 2.42	2.5 lb/ft 3.35	ANCHOR	SLEEVE	TUBULAR ALUMINUM DIA (in) 3.0 lb/ft 1.3	4.0 lb/ft 1.7	4.0Mod lb/ft 1.7	TUBULAR STEEL DIA (in) FND-ATION	3.0 lb/ft 7.6	3.5 lb/ft 9.0	4.0 lb/ft 10.8	5.0 lb/ft 14.6	W-SHAPE STEEL FTG. SIZE 24"	30"	WEIGHT	POST SIZE	SIGN FRAME	REMARKS	SIGN DETAIL DETAIL ON SHEET NUMBER	STD. SHEET NUMBER
1.690 VT 107 LT	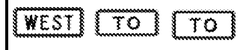	1	24	12	2.00																												M3-4 GREEN ON WHITE		
		1	24	12	2.00																												M4-5 GREEN ON WHITE		
		1	24	12	2.00																												M4-5 GREEN ON WHITE		
		1	30	24	5.00																												M1-5		E-136B
		1	30	24	5.00						2												2	X							#3C	M1-5		E-136B
		1	24	24	4.00																												M1-5		E-136B
1.721 VT 107 RT		1	24	12	2.00																												M3-2 GREEN ON WHITE		
		1	24	12	2.00																												M3-4 GREEN ON WHITE		
		1	30	24	5.00																												M1-5		E-136B
		1	30	24	5.00																												M1-5		E-136B
		1	21	15	2.19																												M6-1L GREEN ON WHITE		
		1	21	15	2.19																											#2B	M6-1R GREEN ON WHITE		
		1	24	12	2.00																												M4-5 GREEN ON WHITE		
		1	24	12	2.00																												M4-5 GREEN ON WHITE		
		1	24	24	4.00																												M1-5		E-136B
		1	30	24	5.00																												M1-5		E-136B
		1	21	15	2.19																												M6-1L GREEN ON WHITE		
		1	21	15	2.19						2												2	X							#2A	M6-1R GREEN ON WHITE		
1.721 VT 107 CL		1	24	30	5.00																												R4-7		
		1	18	18	2.25																												OM1-1		
		1	18	18	2.25						1					X			1	1												BACK TO BACK OM1-1		
1.739 VT 107 CL		1	24	30	5.00																												R4-7		
		1	18	18	2.25																												OM1-1		
		1	18	18	2.25						1					X			1	1												BACK TO BACK OM1-1		
1.750 VT 107 LT		1	24	12	2.00																												M3-3 WHITE ON BLUE		
		1	24	12	2.00																												BACK TO BACK M3-3 WHITE ON BLUE		
		1	24	24	4.00																												M1-1		
		1	24	24	4.00																												BACK TO BACK M1-1		
		1	21	15	2.19																												M6-1R WHITE ON BLUE		
		1	21	15	2.19						1					X			1													BACK TO BACK M6-1L WHITE ON BLUE		
1.780 VT 107 RT		1	72	12	6.00 6.00	OOC #1					2					X			2														D1-1a		E-123
1.800 VT 107 LT	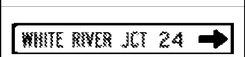	1	72	12	6.00						2					X			2														D1-1a		E-123
												FT	FT	FT	FT	FT 102.7	FT		EA. 2	LB	LB	LB		LB 418.9	LB	LB	LB								
SUBTOTALS SHEET 36		SF ~~103.14~~ 109.14		SF	EA.	SF			FT			FT 102.7								LB			EA. 4	LB 418.9				EA.	EA.	LB					

FINAL POST LENGTHS ARE TO BE DETERMINED IN THE FIELD. POST SIZES ARE COMPUTED BASED ON INFORMATION FURNISHED ON THE STANDARD SHEETS AND THE VTRANS "SIGN POST DESIGN GUIDELINE".

PROJECT NAME: ROYALTON - MIDDLESEX
PROJECT NUMBER: IMG SIGN(19)

FILE NAME: 090106_tss_int3.xls
PROJECT LEADER: CRB
DESIGNED BY: BDB
TRAFFIC SIGN SUMMARY SHEET # 36

PLOT DATE: 8/12/2009
DRAWN BY: JH
CHECKED BY: DAM
SHEET 88 OF 163