STATE OF VERMONT
AGENCY OF TRANSPORTATION

TRAFFIC SIGN SUMMARY SHEET 42

MILE MARKER, STATION OR SIGN NUMBER	SIGN LEGEND	SIGN DIMENSIONS EA	WIDTH (in)	HEIGHT (in)	NEW & SALVAGED SIGNS "A"	"B"	SALV SIGN	SALV TIS	EXIST POST RETAIN	EXIST POST SALVAGE	NEW SIGN POSTS NO. OF POSTS	FLANGED CHANNEL lb/ft 1.12	2.0	3.0	SQUARE STEEL (in) 1.75 lb/ft 1.88	2.0 lb/ft 2.42	2.5 lb/ft 3.35	ANCHOR	SLEEVE	TUBULAR ALUMINUM DIA (in) 3.0 lb/ft 1.3	4.0 lb/ft 1.7	4.0Mod lb/ft 1.7	TUBULAR STEEL DIA (in) FND-ATION	3.0 lb/ft 7.6	3.5 lb/ft 9.0	4.0 lb/ft 10.8	5.0 lb/ft 14.6	W-SHAPE STEEL FTG. SIZE 24"	30"	WEIGHT	POST SIZE	SIGN FRAME	REMARKS	SIGN DETAIL DETAIL ON SHEET NUMBER	STD. SHEET NUMBER
2.382 VT 66 LT		1	24	24	4.00						1					X		1															R8-3a		
2.409 VT 66 LT		1 1	24 24	30 24	5.00 4.00																												R2-1 R8-3a		
	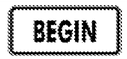	1	24	12	2.00						2					X		2														#1	M4-11 BLACK ON WHITE		E-140
2.410 VT 66 LT							1																												
		1	30	30	6.25						1					X		1															R1-1		
2.426 VT 66 LT		1	24	30	5.00						1					X		1															VR-017		E-141
2.429 VT 66 CL		1	24	30	5.00																												R4-7		
		1 1	18 18	18 18	2.25 2.25						1					X		1	1														OM1-1 BACK TO BACK OM1-1		
2.430 VT 66 LT	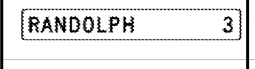	1	72	12	6.00																												D2-1		E-123
WEST		1 1	24 24	12 12	2.00 2.00																												M3-2 GREEN ON WHITE M4-5 GREEN ON WHITE		
		1 1	24 24	24 24	4.00 4.00						2							2					2	X							#1	M1-5 M1-5		E-136B E-136B
2.435 VT 66 RT		1 1 1	24 24 24	12 12 12	2.00 2.00 2.00																												M3-2 GREEN ON WHITE M3-1 WHITE ON BLUE M3-3 WHITE ON BLUE		
		1 1 1	24 24 24	24 24 24	4.00 4.00 4.00																												M1-5 M1-1 M1-1		E-136B
	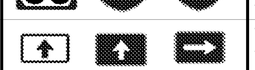	1 1 1	21 21 21	15 15 15	2.19 2.19 2.19						2							2					2	X							#3	M6-3 GREEN ON WHITE M6-3 WHITE ON BLUE M6-1R WHITE ON BLUE		

												FT	FT	FT	FT	FT	FT		EA.	LB	LB	LB		LB	LB	LB	LB								
																85.6			1					378.6											
SUBTOTALS SHEET 42		SF ~~78.32~~ 80.32	SF	EA. 1	SF			FT		FT 85.6			LB		EA. 4		LB 378.6				EA.	EA.	LB												

FINAL POST LENGTHS ARE TO BE DETERMINED IN THE FIELD. POST SIZES ARE COMPUTED BASED ON INFORMATION FURNISHED ON THE STANDARD SHEETS AND THE VTRANS "SIGN POST DESIGN GUIDELINE".

PROJECT NAME: ROYALTON-MIDDLESEX
PROJECT NUMBER: IMG SIGN(19)

FILE NAME: 090106_tss_int4.xls
PROJECT LEADER: CRB
DESIGNED BY: BDB
TRAFFIC SIGN SUMMARY SHEET # 42

PLOT DATE: 8/12/2009
DRAWN BY: JH
CHECKED BY: DAM
SHEET 94 OF 163