STATE OF VERMONT
AGENCY OF TRANSPORTATION

TRAFFIC SIGN SUMMARY SHEET 55

MILE MARKER, STATION OR SIGN NUMBER	SIGN LEGEND	SIGN DIMENSIONS EA	WIDTH (in)	HEIGHT (in)	NEW & SALVAGED SIGNS "A"	"B"	SALV SIGN	SALV TIS	EXIST POST RETAIN	SALVAGE	NEW SIGN POSTS NO. OF POSTS	FLANGED CHANNEL lb/ft 1.12	2.0	3.0	SQUARE STEEL (in) 1.75 lb/ft 1.88	2.0 2.42	2.5 3.35	ANCHOR	SLEEVE	TUBULAR ALUMINUM DIA (in) 3.0 lb/ft 1.3	4.0 1.7	4.0Mod 1.7	TUBULAR STEEL DIA (in) FND-ATION	3.0 lb/ft 7.6	3.5 9.0	4.0 10.8	5.0 14.6	W-SHAPE STEEL FTG. SIZE 24"	30"	WEIGHT	POST SIZE	SIGN FRAME	REMARKS	SIGN DETAIL DETAIL ON SHEET NUMBER	STD. SHEET NUMBER
0.450 VT 64 LT	RANDOLPH 15 / WHITE RIVER JCT 44	1	72	12	6.00																												D1-1a		E-123
		1	72	12	6.00																												D1-1a		E-123
	BARRE 10 / MONTPELIER 11	1	72	12	6.00						2										X												D1-1a		E-123
		1	72	12	6.00																												D1-1a		E-123
0.460 VT 64 RT	WILLIAMSTOWN 4 / BROOKFIELD 13	1	72	12	6.00						2					X		2															D2-1		E-123
		1	72	12	6.00																												D2-1		E-123
0.490 VT 64 LT	JCT	1	21	15	2.19																												M2-1 WHITE ON BLUE		
	89	1	24	24	4.00						1					X		1															M1-1		
0.495 VT 64 RT		1	54	48	18.00		I				2												2	X									RETAINED OLD SIGN	145	
0.497 VT 64 LT	STOP	1	30	30	6.25						1					X		1															R1-1		
0.530 VT 64 RT	SPEED LIMIT 50	1	24	30	5.00						1					X		1															R2-1		
												FT	FT	FT	FT	FT 78.6	FT		EA.	LB	LB 66.9	LB		LB 184.0	LB	LB	LB								
	SHEET TOTALS				SF ~~71.44~~ 109.01	SF	EA. I	SF				FT			FT 78.6					LB 66.9			EA. 2	LB 184.0				EA.	EA.	LB					

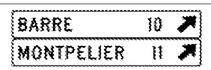

FINAL POST LENGTHS ARE TO BE DETERMINED IN THE FIELD. POST SIZES ARE COMPUTED BASED ON INFORMATION FURNISHED ON THE STANDARD SHEETS AND THE VTRANS "SIGN POST DESIGN GUIDELINE".

PROJECT NAME: ROYALTON-MIDDLESEX
PROJECT NUMBER: IMG SIGN(19)

FILE NAME:	090106_tss_int5.xls	PLOT DATE:	8/12/2009
PROJECT LEADER:	CRB	DRAWN BY:	JH
DESIGNED BY:	BDB	CHECKED BY:	DAM
TRAFFIC SIGN SUMMARY SHEET # 55		SHEET	107 OF 163