STATE OF VERMONT
AGENCY OF TRANSPORTATION

TRAFFIC SIGN SUMMARY SHEET 71

MILE MARKER, STATION OR SIGN NUMBER	SIGN LEGEND	SIGN DIMENSIONS EA	WIDTH (in)	HEIGHT (in)	NEW & SALVAGED SIGNS "A"	"B"	SALV SIGN	SALV TIS	EXIST POST RETAIN	EXIST POST SALVAGE	NEW SIGN POSTS NO. OF POSTS	FLANGED CHANNEL lb/ft 1.12	2.0	3.0	SQUARE STEEL (in) 1.75 lb/ft 1.88	2.0 lb/ft 2.42	2.5 lb/ft 3.35	ANCHOR	SLEEVE	TUBULAR ALUMINUM DIA (in) 3.0 lb/ft 1.3	4.0 lb/ft 1.7	4.0Mod lb/ft 1.7	TUBULAR STEEL DIA (in) FND-ATION	3.0 lb/ft 7.6	3.5 lb/ft 9.0	4.0 lb/ft 10.8	5.0 lb/ft 14.6	W-SHAPE STEEL FTG. SIZE 24"	30"	WEIGHT	POST SIZE	SIGN FRAME	REMARKS	SIGN DETAIL DETAIL ON SHEET NUMBER	STD. SHEET NUMBER
0.040 MSH LT	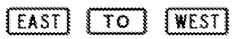	1	24	12	2.00																												M3-2 BLACK ON WHITE		
		1	24	12	2.00																												M4-5 GREEN ON WHITE		
		1	24	12	2.00																												M3-4 BLACK ON WHITE		
		1	24	24	4.00																												M1-4		
		1	30	24	5.00																												M1-5		E-136B
		1	24	24	4.00																												M1-4		
		1	21	15	2.19																												M6-1L BLACK ON WHITE		
		1	21	15	2.19						2										X										#3B	M6-1L GREEN ON WHITE		
		1	21	15	2.19																												M6-1R BLACK ON WHITE		
0.050 MSH RT		1	24	12	2.00																												M4-5 BLACK ON WHITE		
		1	24	12	2.00																												M4-5 GREEN ON WHITE		
		1	24	24	4.00																												M1-4		
		1	30	24	5.00																												M1-5		E-136B
		1	21	15	2.19																												M6-1R BLACK ON WHITE		
		1	21	15	2.19						2												2	X							#2A	M6-1R GREEN ON WHITE		
0.050 MSH RT		1	24	12	2.00																												M3-3 WHITE ON BLUE		
		1	24	24	4.00																												M1-1		
		1	21	15	2.19						1					X		1															M6-1L WHITE ON BLUE		
0.100 MSH LT	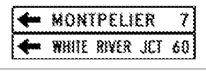	1	72	12	6.00																												D1-1a		E-123
		1	72	12	6.00																												D1-1a		E-123
		1	24	12	2.00																												M3-3 WHITE ON BLUE		
		1	24	24	4.00																												M1-1		
		1	21	15	2.19						2										X												M6-1L WHITE ON BLUE		
0.106 MSH RT	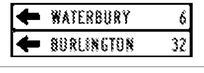	1	72	12	6.00																												D1-1a		E-123
		1	72	12	6.00																												D1-1a		E-123
		1	24	12	2.00																												M3-1 WHITE ON BLUE		
		1	24	24	4.00																												M1-1		
		1	21	15	2.19						2										X												M6-1L WHITE ON BLUE		
												FT	FT	FT	FT	FT 16.0	FT		EA.	LB	LB 208.0	LB		LB 177.1	LB	LB	LB							
SUBTOTALS SHEET 71		SF 91.52	SF	EA.	SF							FT			FT 16.0					LB 208.0			EA. 2	LB 177.1				EA.	EA.	LB				

FINAL POST LENGTHS ARE TO BE DETERMINED IN THE FIELD. POST SIZES ARE COMPUTED BASED ON INFORMATION FURNISHED ON THE STANDARD SHEETS AND THE VTRANS "SIGN POST DESIGN GUIDELINE".

PROJECT NAME: ROYALTON-MIDDLESEX
PROJECT NUMBER: IMG SIGN(19)

FILE NAME: 090106_tss_int9.xls
PROJECT LEADER: CRB
DESIGNED BY: BDB
TRAFFIC SIGN SUMMARY SHEET # 71

PLOT DATE: 8/12/2009
DRAWN BY: SRB
CHECKED BY: DAM
SHEET 123 OF 163