INDEX OF SHEETS
SEE SHEET 2

TRAFFIC DATA
SOUTH BURLINGTON
INTERSTATE 89
MM 89.636
2010 ADT = 52,300
2010 DHV = 4,800
2010 ADTT = 3,660
%T = 7
NB %D = 50
SB %D = 50
V = 55 MPH

TRAFFIC DATA
COLCHESTER
INTERSTATE 89
MM 95.183
2010 ADT = 28,800
2010 DHV = 2,800
2010 ADTT = 2,020
%T = 7
NB %D = 50
SB %D = 50
V = 65 MPH

STATE OF VERMONT
AGENCY OF TRANSPORTATION

PROPOSED IMPROVEMENT
CITY OF SOUTH BURLINGTON
AND TOWN OF COLCHESTER
COUNTY OF CHITTENDEN
INTERSTATE 89 NB & SB

PROJECT LOCATION: THE FOLLOWING CULVERTS ALONG THE INTERSTATE 89 CORRIDOR
BRIDGE 69-1 AT MILE MARKER 89.636 IN THE CITY OF SOUTH BURLINGTON
BRIDGE 75-3 AT MILE MARKER 95.183 IN THE TOWN OF COLCHESTER

PROJECT DESCRIPTION: PREVENTIVE MAINTENANCE TO EXISTING CULVERTS INCLUDING THE INSTALLATION OF PIPE LINERS AND HEADWALLS ALONG WITH THE CONSTRUCTION OF NEW CULVERTS USING TRENCHLESS TECHNOLOGY ALONGSIDE THE EXISTING CULVERTS.

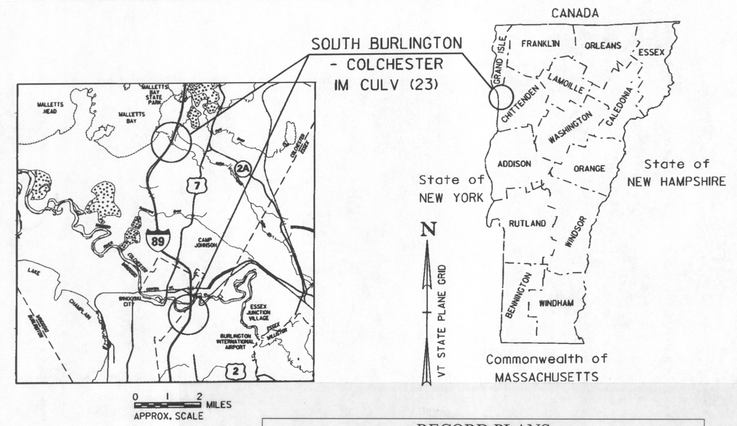

RECORD PLANS	
CONTRACTOR:	MORRILL CONSTRUCTION INC.– NORTH HAVERHILL, NH
RESIDENT ENGINEER:	GREG WILCOX
CONSTRUCTION BEGAN:	JUNE 13, 2011
CONSTRUCTION COMPLETE:	AUGUST 29, 2012
RECORD PLANS BY:	GREG WILCOX & JENNA HYDE

I HEREBY CERTIFY THAT ALL THE CONSTUCTION REQUIRED BY THIS SET OF DRAWINGS HAS BEEN ACCOMPLISHED AS INDICATED HEREIN.

BY _____ RESIDENT ENGINEER

DATE 7/18/13

NOTE: Any further information concerning final quantities, amounts or other details relative to this project may be found at Central Files in the electronic archives.

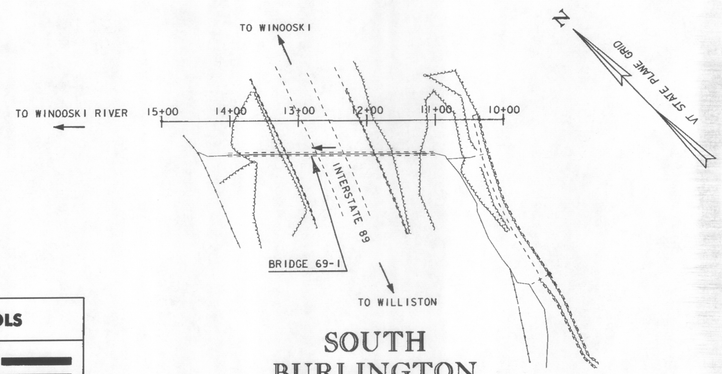

SOUTH BURLINGTON
MM 89.636

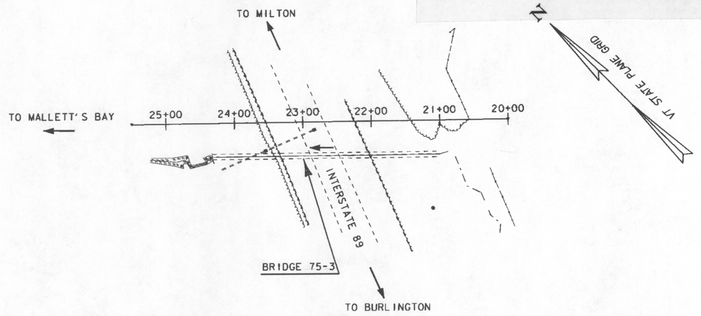

COLCHESTER
MM 95.183

CONVENTIONAL SYMBOLS

COUNTY LINE
TOWN LINE
LIMITS OF ACCESS
POINT OF ACCESS
FENCE LINE
STONE WALL
TRAVELED WAY
GUARD RAIL
RAILROAD
SURVEY LINE
CULVERT
POWER POLE
TELEPHONE POLE
TREES
CONTROL OF ACCESS
PROPERTY LINE
R.O.W. TAKING LINE
SLOPE RIGHTS
TOP OF CUT
TOE OF SLOPE

SURVEYED BY : TOPOGRAPHIC SURVEY BY : VSE DATE: 9/2009
SURVEY CONTROL BY: VSE DATE: 9/2009

DATUM
VERTICAL NAVD 88 (GEOID03)
HORIZONTAL NAD 83 (CORS96)

ROADWAY PLANS PREPARED BY
McFarland Johnson
Mc FARLAND-JOHNSON, INC
CONCORD, N.H.
BY _____

0 100 200
SCALE IN FEET

THESE PLANS ARE SUBJECT TO SUCH ENGINEERING CHANGES AS MAY BE REQUIRED BY THE FEDERAL HIGHWAY ADMINISTRATION OR THE DIRECTOR OF THE PROGRAM DEVELOPMENT

CONSTRUCTION IS TO BE CARRIED ON IN ACCORDANCE WITH THESE PLANS AND THE VERMONT AGENCY OF TRANSPORTATION STANDARD SPECIFICATIONS FOR CONSTRUCTION DATED 2006, AS APPROVED BY THE FEDERAL HIGHWAY ADMINISTRATION ON JUNE 4, 2006 FOR USE ON THIS PROJECT, INCLUDING ALL SUBSEQUENT REVISIONS AND SUCH REVISED SPECIFICATIONS AND SPECIAL PROVISIONS AS ARE INCORPORATED IN THESE PLANS.

DEPARTMENT OF TRANSPORTATION
FEDERAL HIGHWAY ADMINISTRATOR
APPROVED _____ DATE _____

DIRECTOR OF PROGRAM DEVELOPMENT
APPROVED _____ DATE 2-15-11

PROJECT MANAGER : D. LANDRY

PROJECT NAME : SOUTH BURLINGTON - COLCHESTER
PROJECT NUMBER : IM CULV (23)

SHEET 1 OF 36 SHEETS