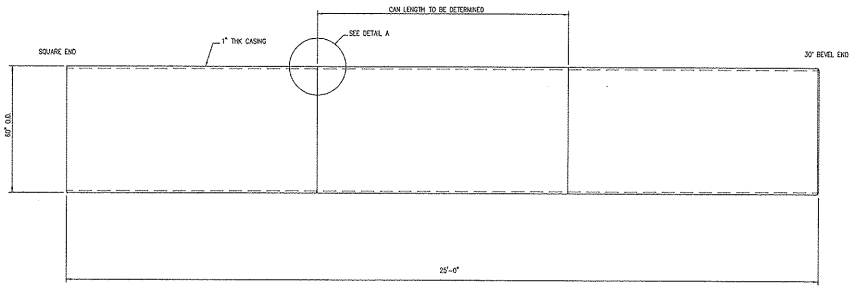

SPOOL No/ 60100-7

60" O.D. x 1.00 WALL

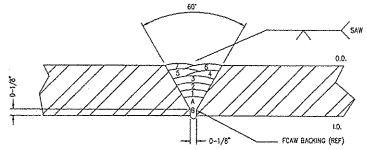

FCAW- SAW- WPS- 01
A. FCAW (HAND WELD FROM OUTSIDE)
B. FCAW (BACKGOUGE THEN HAND WELD FROM INSIDE)
1 thru 7 SAW (MACHINE WELD, MULTIPLE LAYERS REQ'D TO COMPLETE WELD)

DETAIL A

TYPICAL WELD JOINT
CIRCUMFERENTIAL & LONGITUDINAL
NO SCALE
(SECTION CUT FOR CLARITY)

VTrans
Received
CK'D _____ OK'd BY JLW

MAY 11 2012

Resubmit _____ APPROVED
BY _____ DATE 5/11/12

GENERAL NOTES:

1. ALL WELDS TO BE CONTINUOUS WITH FULL PENETRATION, PERFORMED BY CERTIFIED WELDERS PER AWS D
2. PIPE TO BE MANUFACTURED IN ACCORDANCE WITH ASTM A139 GR. B WITH THE EXCEPTION OF THE TEST
WAIVED BY THE STATE OF VERMONT AS DOCUMENTED IN WRITEN ORDER #18.

PROPRIETARY NOTICE
This drawing is the property of Valiant Steel & Equip. and is loaned, subject to recall and shall not be reproduced or information contained herein transmitted in any manner directly or indirectly, any way detrimental to the interest of Valiant Steel & Equip. All rights of design and invention are reserved.
Acceptance of this drawing is an acceptance of the foregoing conditions and recognition of the exclusive ownership to this drawing as the property of Valiant Steel and Equipment, Inc.

REV. NO.	DATE	BY	DESCRIPTION

PROJECT NUMBER	IM GULV (23)
COMPANY	Bore Tech LLC, St. Johnsbury, VT.
PROJECT NAME	South Burlington- Colchester
DRAWN MBE	SCALE NONE
DATE 4/26/12	DWG'S
REV.	

Valiant Steel and Equipment, Inc.
6455 Old Peachtree Road
NORCROSS, GEORGIA (770) 417-1233

DWG. NO. 60100