STATE OF VERMONT
AGENCY OF TRANSPORTATION

INDEX OF SHEETS

1.	TITLE SHEET
2.	QUANTITY SHEET
3. - 5.	TRAFFIC CONTROL SHEETS
6.	PROJECT NOTES AND DETAILS
7. - 10.	REFERENCE PLANS - BRIDGES 70 N&S

VAOT STANDARD SHEETS

E-100	01/02/04
E-101	05/30/03
E-102	06/30/03
E-102A	05/01/04
E-103	03/01/04
E-106	03/01/04
E-107	06/30/03
E-107A	06/06/09
E-110	08/08/95
E-120	08/08/95
E-121	08/08/95

PROPOSED IMPROVEMENT
BRIDGE PROJECT
TOWNS OF SOUTH BURLINGTON, WINOOSKI
COUNTY OF CHITTENDEN
PROJECT IM BPNT(5)

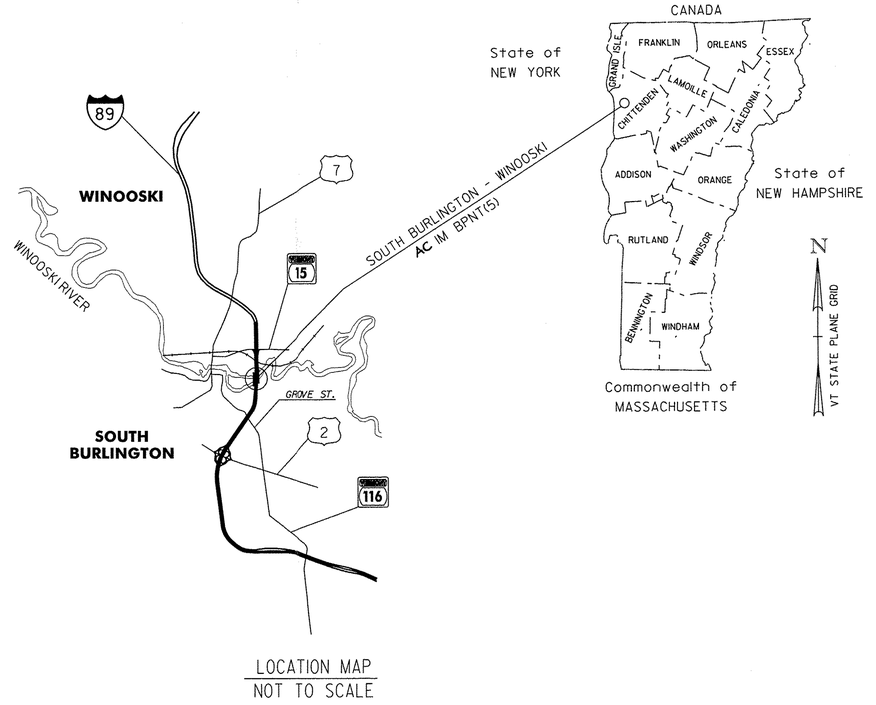

LOCATION MAP
NOT TO SCALE

ROUTE NO.: INTERSTATE 89

BRIDGE NO.: 70N&S

PROJECT LOCATION: BR 70N&S OVER WINOOSKI RIVER (MM 90.008)

PROJECT DESCRIPTION: THIS PROJECT INVOLVES CLEANING AND REPAINTING THE EXISTING STEEL SUPERSTRUCTURE MEMBERS AND MINOR RELATED WORK.

SURVEYED BY : N/A

SURVEYED DATE : N/A

DATUM

VERTICAL N/A

HORIZONTAL N/A

CONVENTIONAL SYMBOLS

COUNTY LINE
TOWN LINE
LIMITS OF ACCESS
POINT OF ACCESS
FENCE LINE
STONE WALL
TRAVELED WAY
GUARD RAIL
RAILROAD
SURVEY LINE
CULVERT
POWER POLE
TELEPHONE POLE
TREES
CONTROL OF ACCESS
PROPERTY LINE
R.O.W. TAKING LINE
SLOPE RIGHTS (SR SR SR)
TOP OF CUT
TOE OF SLOPE

RECORD PLANS

CONTRACTOR: ATSALIS BROTHERS PAINTING CO. - CLINTON TWP., MI

RESIDENT ENGINEER: SCOTT WHEATLEY

CONSTRUCTION BEGAN: SEPTEMBER 7, 2010

CONSTRUCTION COMPLETE: MARCH 23, 2012

RECORD PLANS BY: SCOTT WHEATLEY

I HEREBY CERTIFY THAT ALL THE CONSTUCTION REQUIRED BY THIS SET OF DRAWINGS HAS BEEN ACCOMPLISHED AS INDICATED HEREIN.

BY Scott Wheatley RESIDENT ENGINEER

DATE 7/9/12

NOTE: Any further information concerning final quantities, amounts or other details relative to this project may be found at Central Files in the electronic archives.

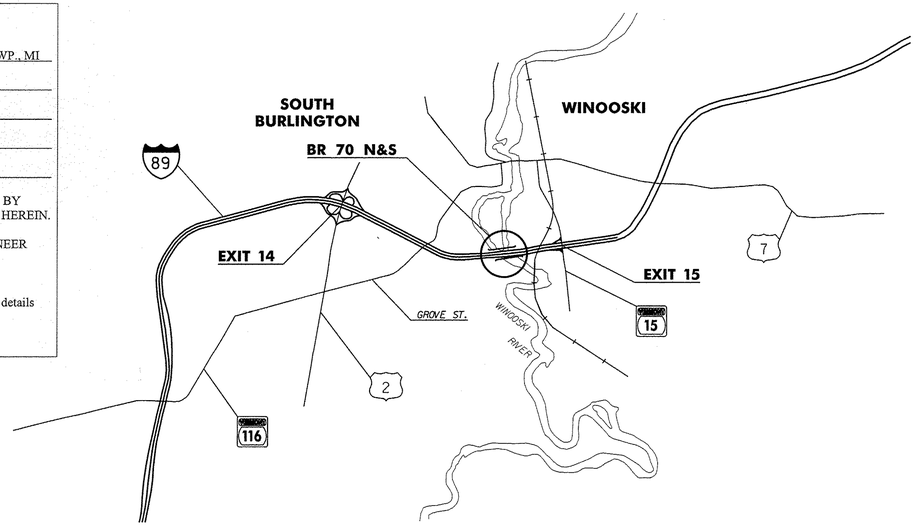

2009 AADTs	
NORTHBOUND	SOUTHBOUND
26,700	26,700

THESE PLANS ARE SUBJECT TO SUCH ENGINEERING CHANGES AS MAY BE REQUIRED BY THE FEDERAL HIGHWAY ADMINISTRATION OR THE DIRECTOR OF PROGRAM DEVELOPMENT.

CONSTRUCTION IS TO BE CARRIED ON IN ACCORDANCE WITH THESE PLANS AND THE STANDARD SPECIFICATIONS FOR CONSTRUCTION DATED 2006, AS APPROVED BY THE FEDERAL HIGHWAY ADMINISTRATION ON JUNE 15, 2006 FOR USE ON THIS PROJECT, INCLUDING ALL SUBSEQUENT REVISIONS AND SUCH REVISED SPECIFICATIONS AND SPECIAL PROVISIONS AS ARE INCORPORATED IN THESE PLANS.

STATE OF VERMONT DANIEL HUDSON No. 9125 CIVIL ENGINEER
7-10-09
TRAFFIC CONTROL

STATE OF VERMONT JOHN P. BYATT NO. 6478 Structural LICENSED PROFESSIONAL ENGINEER
7/10/09

PLANS PREPARED BY:

CONSULTING ENGINEERS Inc.
540 Commercial Street • Manchester, NH 03101
(603) 668-8223 • Fax: (603) 668-8802
email: cle@cleengineers.com • www.cleengineers.com
Maine • New Hampshire • Vermont

DEPARTMENT OF TRANSPORTATION
FEDERAL HIGHWAY ADMINISTRATOR

APPROVED Ted Kniffin DATE 8/29/09

DIRECTOR OF PROGRAM DEVELOPMENT

APPROVED Richard Peterson DATE 7-22-09

PROJECT MANAGER : JOHN WEAVER

PROJECT NAME : **SOUTH BURLINGTON - WINOOSKI**

PROJECT NUMBER : AC IM BPNT(5)

SHEET 1 OF 10 SHEETS