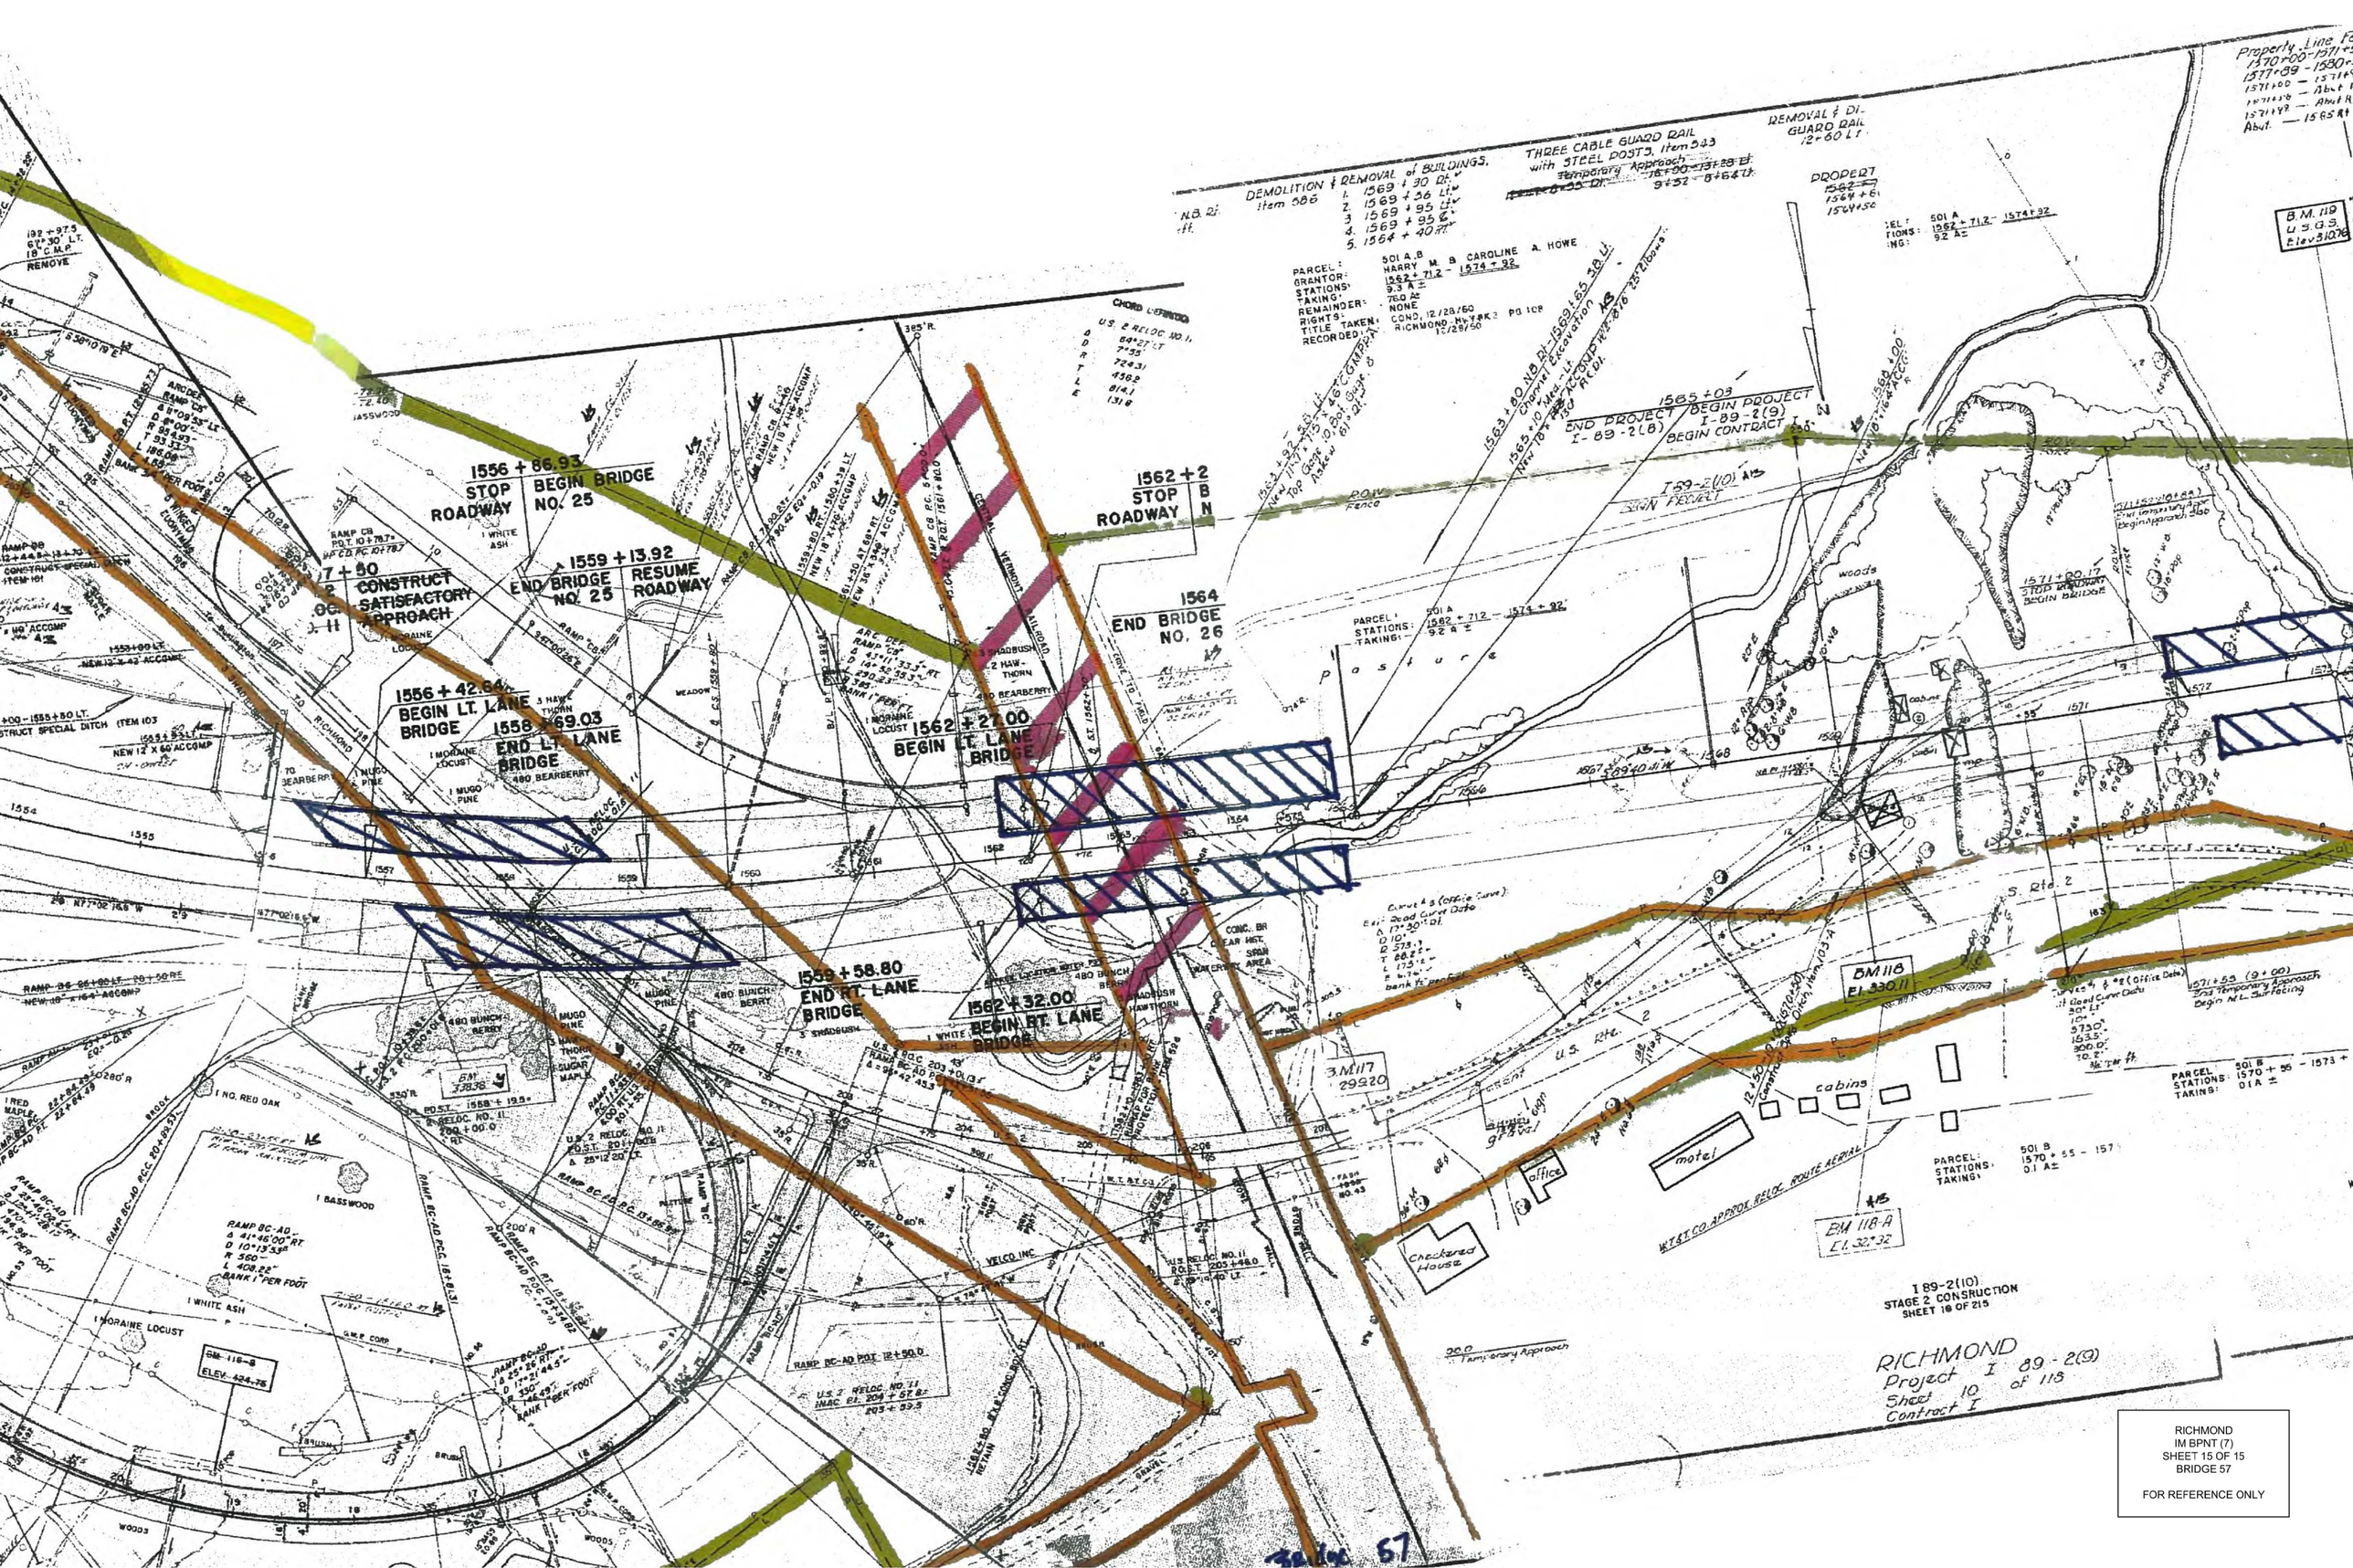

RICHMOND
IM BPNT (7)
SHEET 15 OF 15
BRIDGE 57

FOR REFERENCE ONLY