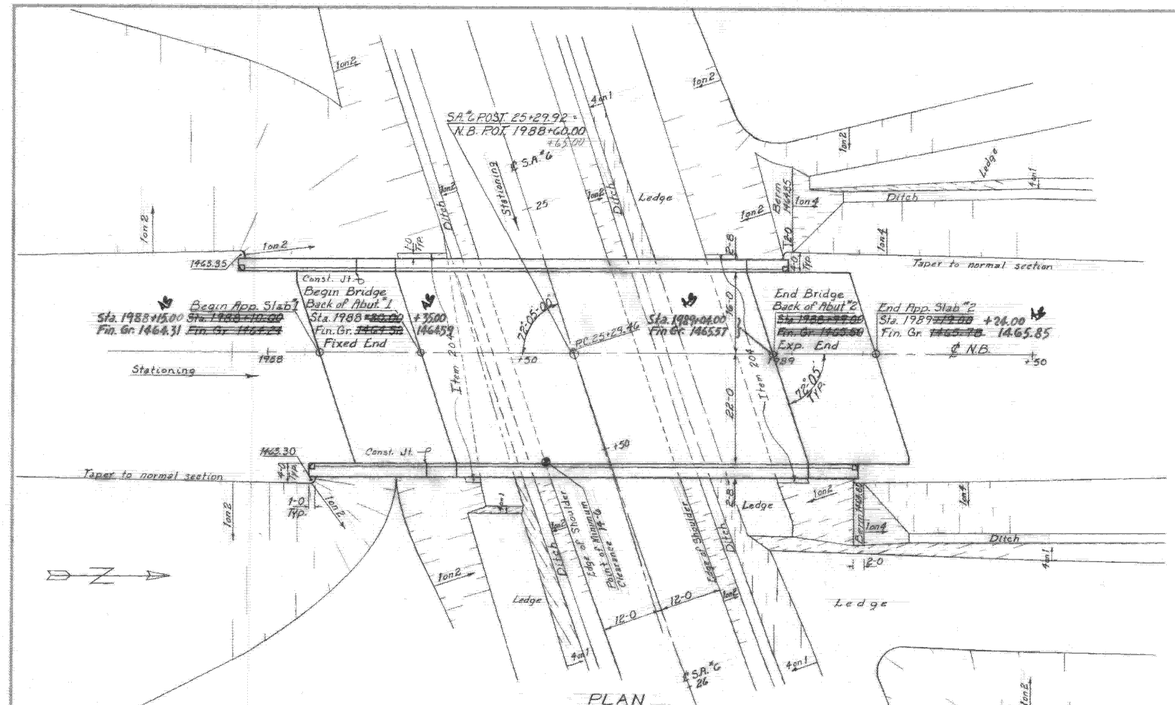
S.A.℄ POST 25+29.92 =
N.B. POT 1988+60.00
Begin App. Slab #1
Sta. 1988+15.00
Fin. Gr. 1464.31
Begin Bridge
Back of Abut. #1
Sta. 1988
Fin. Gr.
Fixed End
End Bridge
Back of Abut #2
End App. Slab #2
Sta. 1989
Fin. Gr. 1465.85
Exp. End
℄ N.B.
Stationing
Const. Jt.
Taper to normal section
Ledge
Ditch
Item 204
Item 204
Item 204