



DETAIL OF PARTIAL PARABOLIC CROWN OF SLAB

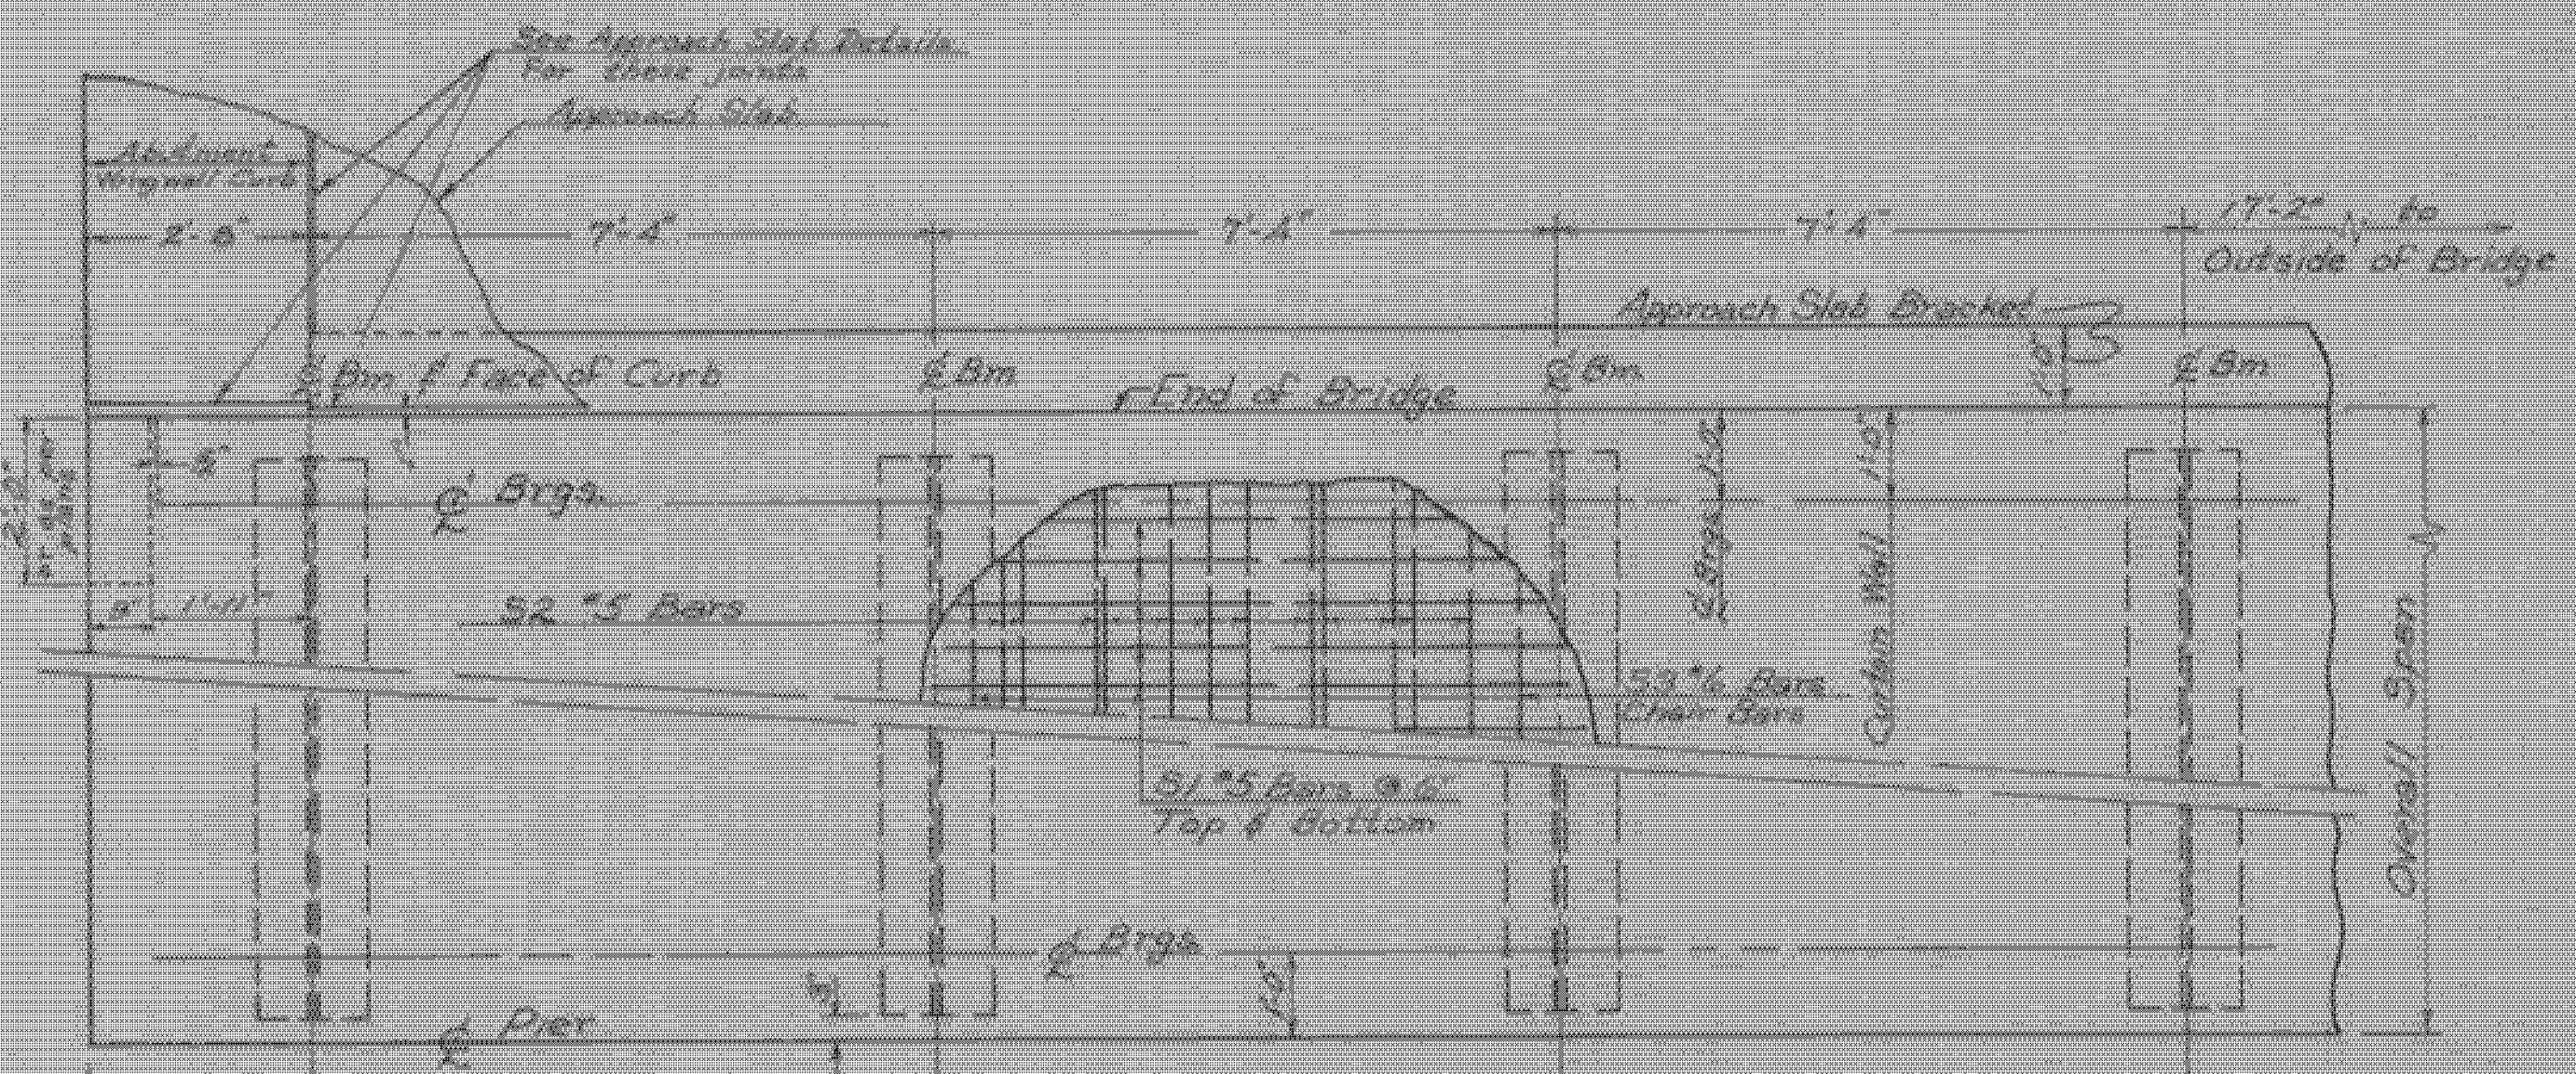

PARTIAL PLAN

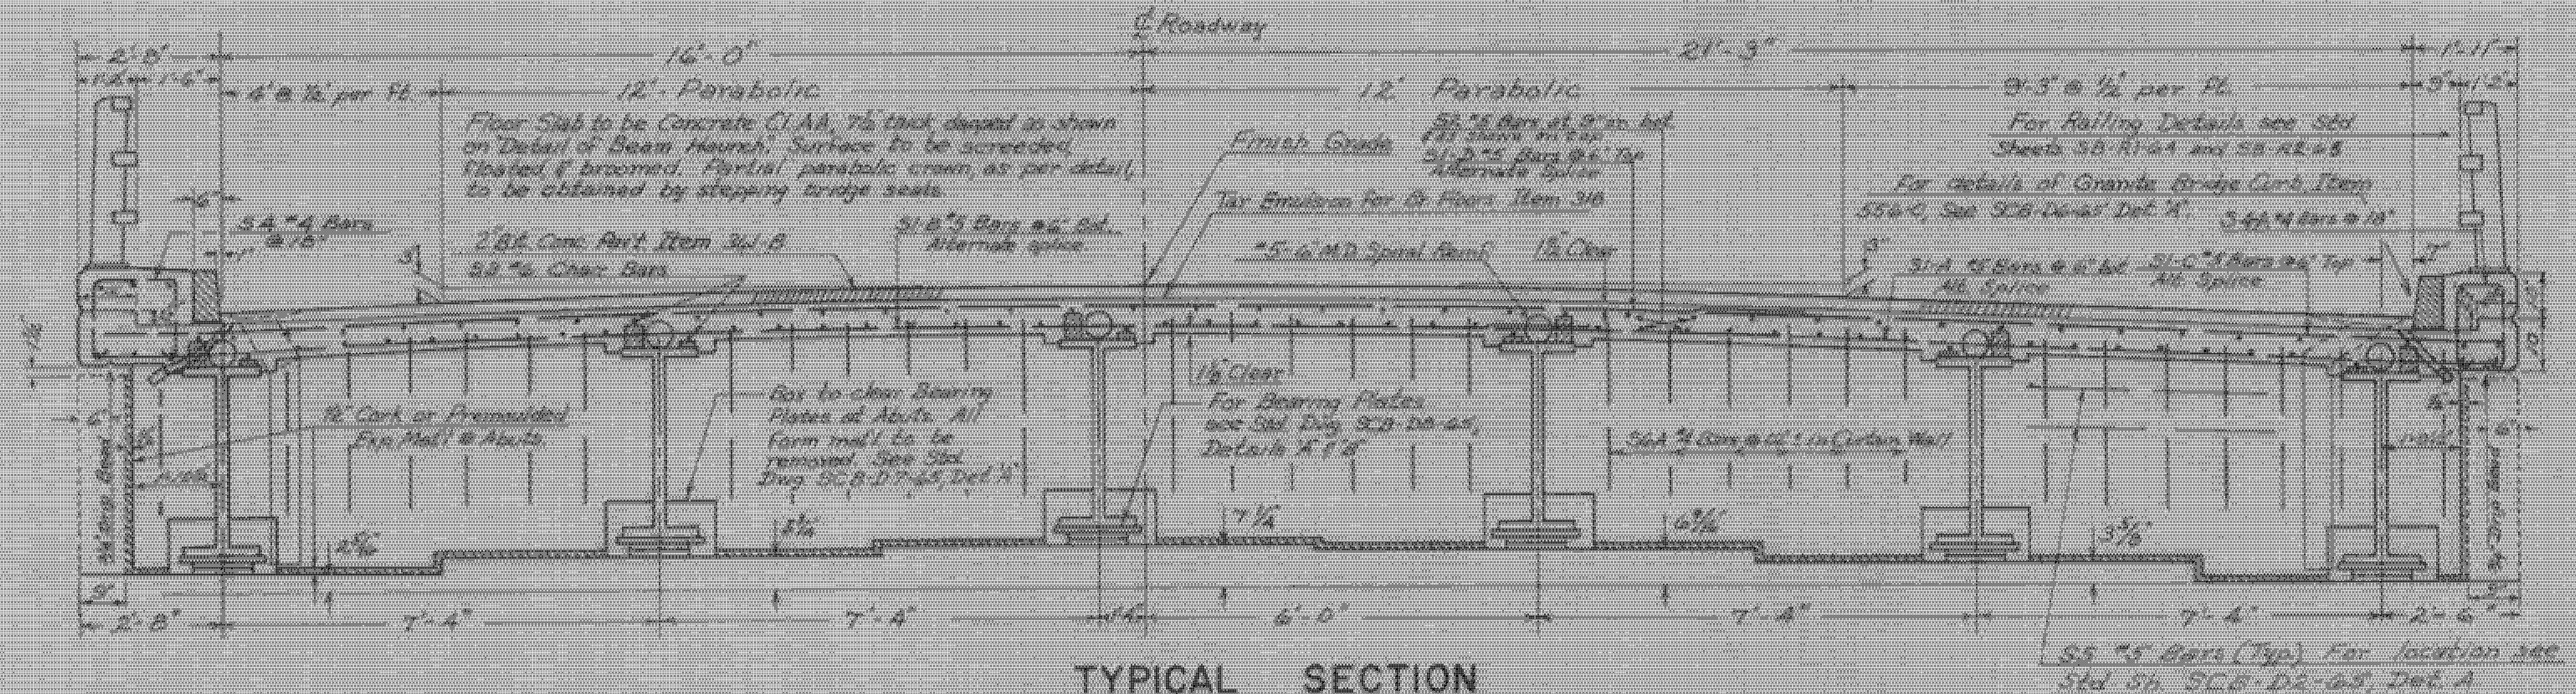

TYPICAL SECTION

TABLE OF QUANTITIES FOR SINGLE (SQUARE) SPAN (INCLUDES TWO CURTAIN WALLS)


* Excluding Scupper and Bearing Devices.

REINFORCING STEEL SCHEDULE

Span	Str.	Length	Str.	Length	S6A #4	Total Length	S4 #4	S4A #4	S6A #4
34	S1-A #5	17'-6"	S1-B #5	26'-0"	2'-6"	6'-6"	4'-8"	4'-8"	4'-8"
39	S1-C #5	13'-10"	S1-D #5	29'-8"	2'-9"	7'-0"	4'-8"	4'-8"	4'-8"
44	S5 #5	21'-0"	S1-D #5	29'-8"	2'-9"	7'-0"	4'-8"	4'-8"	4'-8"
49	S2 #5	33'-6"	S3 #5	33'-6"	3'-0"	7'-6"	4'-8"	4'-8"	4'-8"
54	S2 #5	20'-3"	S3 #5	20'-6"	3'-0"	7'-6"	4'-8"	4'-8"	4'-8"
59	S2 #5	22'-9"	S3 #5	23'-0"	3'-0"	7'-6"	4'-8"	4'-8"	4'-8"
64	S2 #5	25'-3"	S3 #5	25'-6"	3'-0"	7'-6"	4'-8"	4'-8"	4'-8"
69	S2 #5	27'-9"	S3 #5	28'-0"	3'-0"	7'-6"	4'-8"	4'-8"	4'-8"
74	S2 #5	30'-3"	S3 #5	30'-6"	3'-0"	7'-6"	4'-8"	4'-8"	4'-8"
79	S2 #5	32'-9"	S3 #5	33'-0"	3'-0"	7'-6"	4'-8"	4'-8"	4'-8"
84	S2 #5	24'-3"	S3 #5	24'-6"	3'-2"	7'-10"	4'-8"	4'-8"	4'-8"
89	S2 #5	26'-0"	S3 #5	26'-3"	3'-2"	7'-10"	4'-8"	4'-8"	4'-8"
94	S2 #5	27'-6"	S3 #5	27'-9"	3'-2"	7'-10"	4'-8"	4'-8"	4'-8"
99	S2 #5	29'-3"	S3 #5	29'-6"	3'-2"	7'-10"	4'-8"	4'-8"	4'-8"

Revisions & Corrections
 1. Original B.I.L. Cont. thickness from 12" to 2" revised 8-21-65
 2. Changed S1-A #5 to S1-B #5 8-21-65
 3. Revised Item #10 8-21-65

Drawn By: W.B.T. Aug. 1964 Revised Jan. 65
 Traced By: W.B.T. Aug. 1964 Revised Jan. 65
 Checked By: T.K.-W.M.S. Oct. 1964 Rev. Jan. 65
 Recommended For Approval: [Signature] Date 11/65
 Recommended For Approval: [Signature] Date 11/65
 Approved By: [Signature] Chief Engineer Date 11/65

TYPICAL SECTION, PLAN VIEW, & QUANTITIES
 37.25 FOOT ROADWAY W/ BEAM BRIDGES
 DESIGN LOADING - HS20-44 (A.S.T.M.-A36-62T STEEL)
 34-44 NON COMPOSITE, 49-99 COMPOSITE
 FOR ADDITIONAL DETAILS SEE STANDARDS SCB-DI THRU D9-65

STATE OF VERMONT
 DEPARTMENT OF HIGHWAYS
 STANDARD STRUCTURES
SCB-37.25-65
 WESTMINSTER-NORWICH
 IM BPNT (8)
 SHEET 36 OF 58
 FOR REFERENCE ONLY