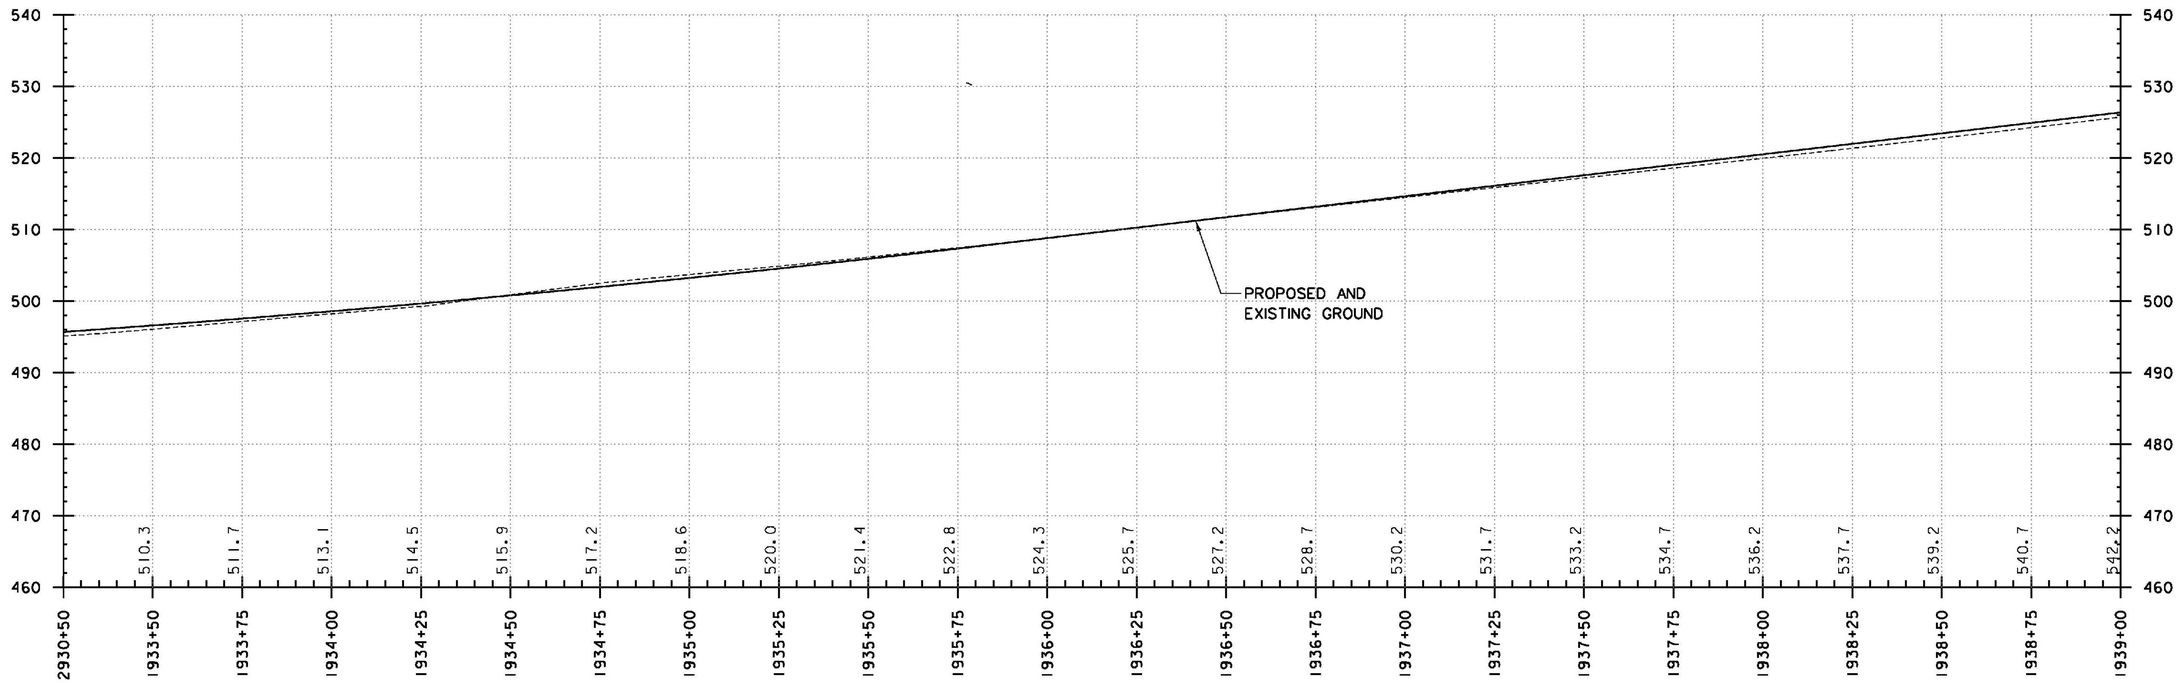

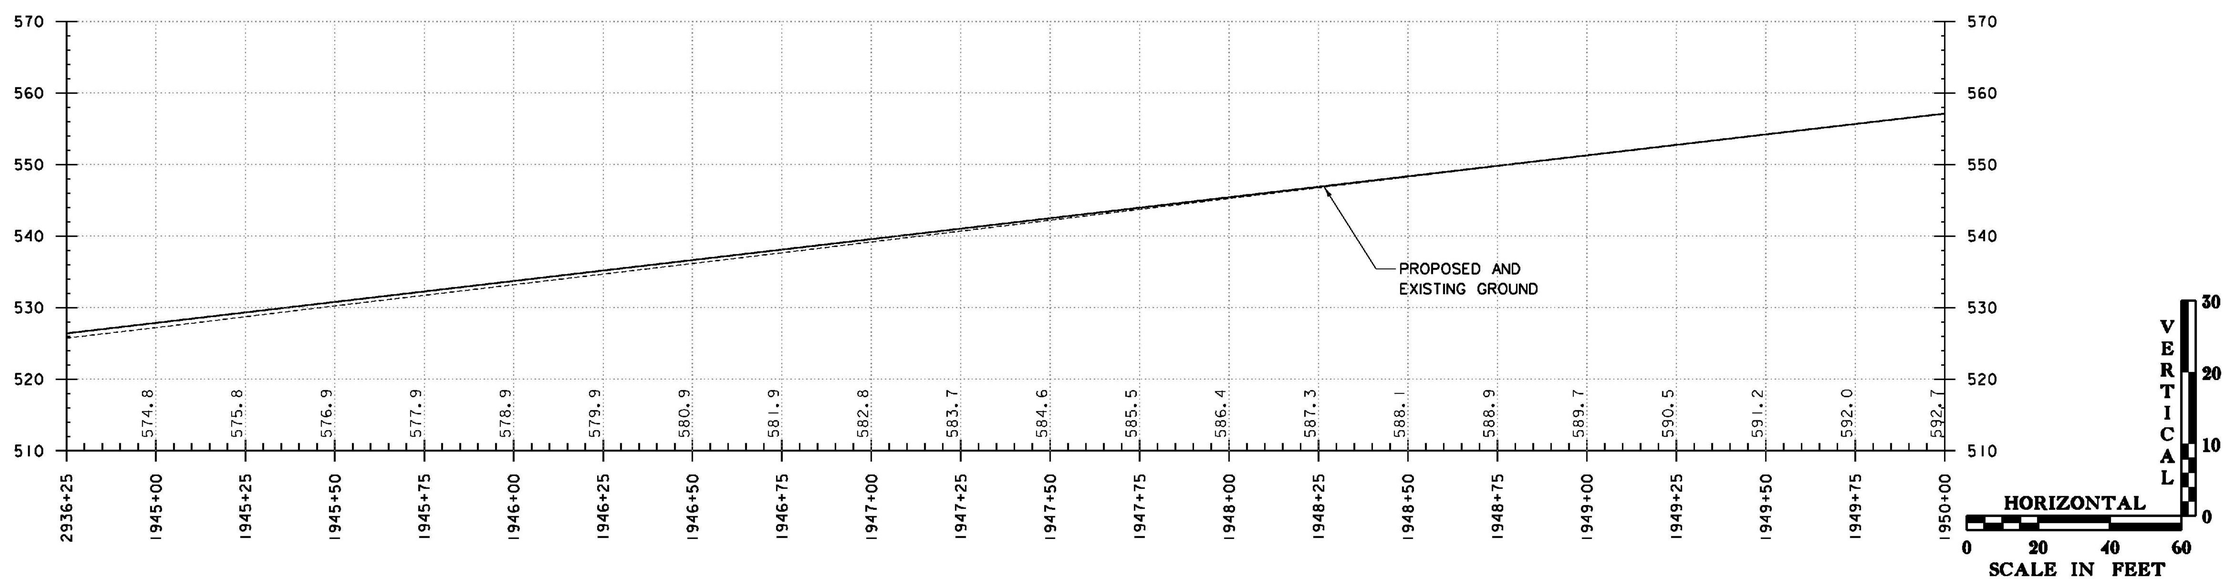

THE GRADES SHOWN TO THE NEAREST TENTH ARE THE ORIGINAL GROUND ELEVATIONS ALONG THE PROPOSED ALIGNMENT. THE GRADES SHOWN TO THE NEAREST HUNDREDTH ARE THE PROPOSED GRADES FOR THE NEW ALIGNMENT.

DATUM

VERTICAL NAVD88

HORIZONTAL NAD 83 (07)

I-91 SOUTHBOUND PROFILE

PROJECT NAME: WINDSOR

PROJECT NUMBER: IM 091-1(64)

FILE NAME: z20a188bdr PRO-SB.dgn

PROJECT LEADER: J. WILSON

DESIGNED BY: H. FULLER

PROFILE SHEET 6 - I-91 SOUTHBOUND

PLOT DATE: 7/30/2015

DRAWN BY: S. GUNN

CHECKED BY: T. MORIN

SHEET 32 OF 156