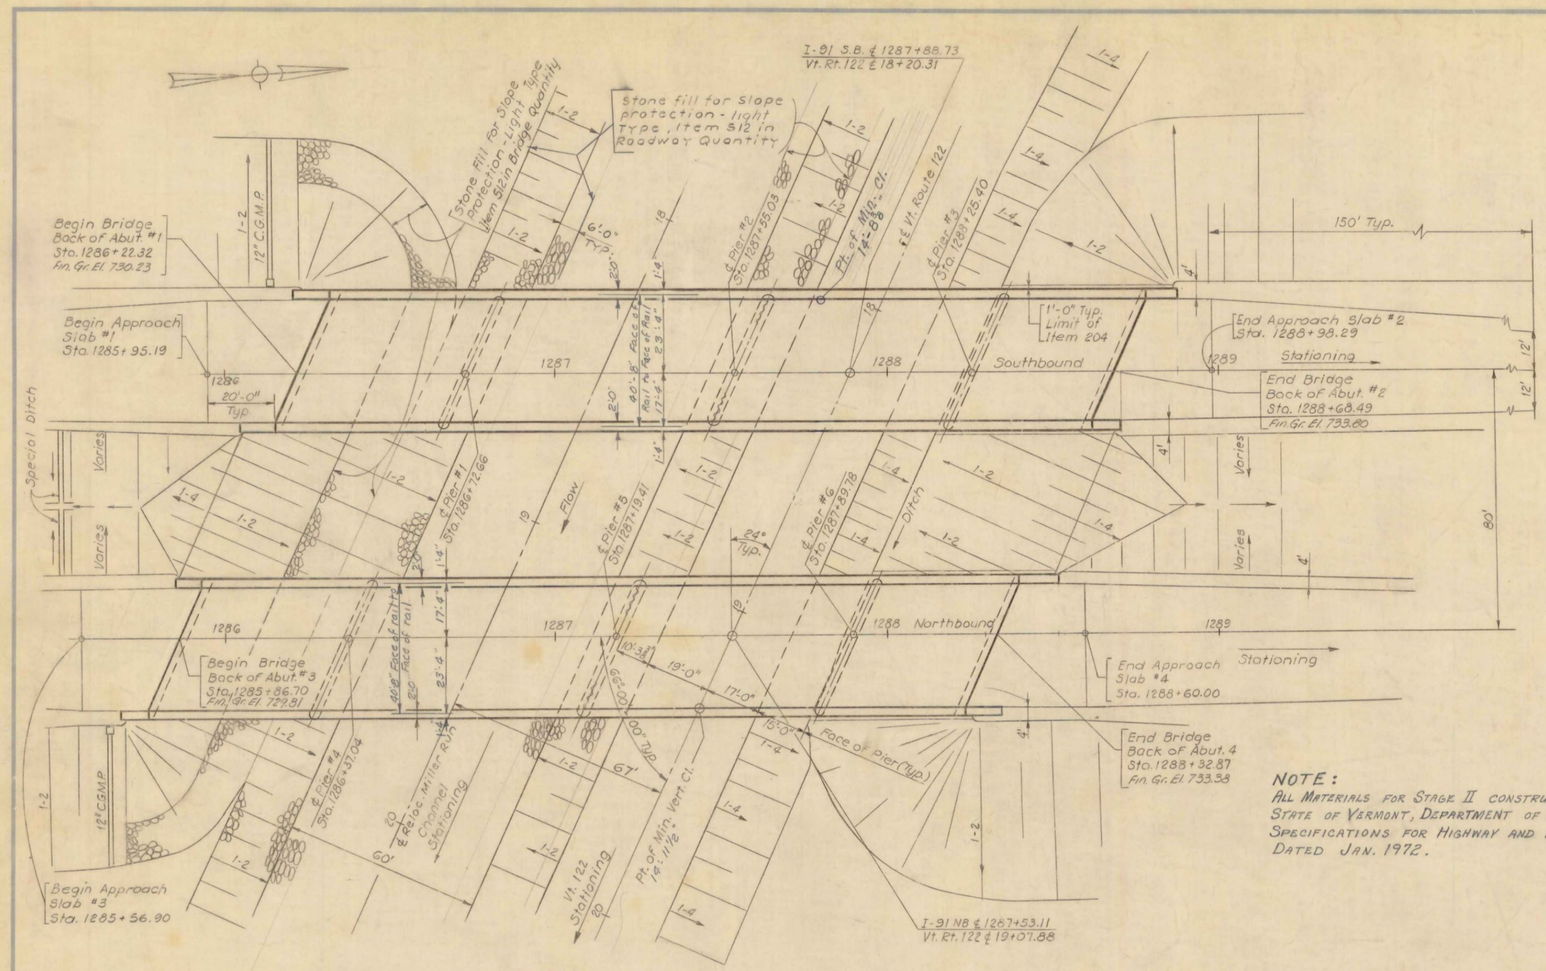

LIST OF BRIDGE SHEETS

**BR 200	GENERAL PLAN
**BR 201	BRIDGE QUANTITY SHEET
**BR 202	PRELIMINARY INFORMATION SHEET
BR 203	BORING LAYOUT SHEET & BORING LOGS
BR 204	BORING LOGS
BR 205	BORING LOGS
BR 206	BORING LOGS
**BR 207	FRAMING PLAN
**BR 208	STRUCTURAL STEEL DETAILS
BR 209	EXPANSION DAM DETAILS
BR 210	EXPANSION DAM DETAILS
BR 211	ROCKER BEARINGS
BR 212	ABUTMENT #1
BR 213	ABUTMENT #2
BR 214	ABUTMENT #3
BR 215	ABUTMENT #4
BR 216	PIERS #1 & #4
BR 217	PIERS #2 & #5
BR 218	PIERS #3 & #6
BR 219	PIER DETAILS
**BR 220	APPROACH SLABS #1 & #4
**BR 221	APPROACH SLABS #2 & #3
BR 222	REINFORCING STEEL DETAILS
BR 223	REINFORCING STEEL DETAILS
BR 224	REINFORCING STEEL DETAILS
BR 225	REINFORCING STEEL DETAILS

STANDARD SHEETS REQUIRED

SCB-D1-67	4-28-70 R.	SCB-D8-67 Ⓐ	1-24-68
SCB-D2-67 ⒶⒷⒸ	1-24-68	SCB-D9-67 Ⓐ & Ⓑ	4-28-70 R.
SCB-D4-67	12-17-68 R.	SB-R1-69 SHEET #1	4-28-70 R.
SCB-D6-67 ⒶⒷⒸ	4-28-70 R.	SHEET #2	4-28-70 R.
SCB-D7-67 ⒶⒸⒹ	1-24-68	SB-P1-66	11-8-66
** SCB-D9-71 Ⓑ	12-14-71 A	G-9	9-27-67

REFERENCE SHEETS

PLAN SB & NB STA. 1285+00 TO STA. 1293+00
PROFILE SB & NB STA. 1285+00 TO STA. 1293+00
VT. 122 STA. 9+00 TO STA. 25+00
CROSS SECTIONS SB & NB STA 1284+50 TO STA. 1292+00
VT. 122 STA 15+50 TO STA. 22+50

** Sheets for Stage II Construction.

NOTE:
ALL MATERIALS FOR STAGE II CONSTRUCTION SHALL CONFORM TO STATE OF VERMONT, DEPARTMENT OF HIGHWAYS, STANDARD SPECIFICATIONS FOR HIGHWAY AND BRIDGE CONSTRUCTION DATED JAN. 1972.

NOTES

1. For General Notes see Std. SCB-D1-67.
2. Item 440, Water Repellent, shall consist of furnishing and applying water repellent on exterior concrete surfaces including top of safety walks, fascia and back to the fascia beam under the slab and exposed areas of abutments and piers not otherwise treated.

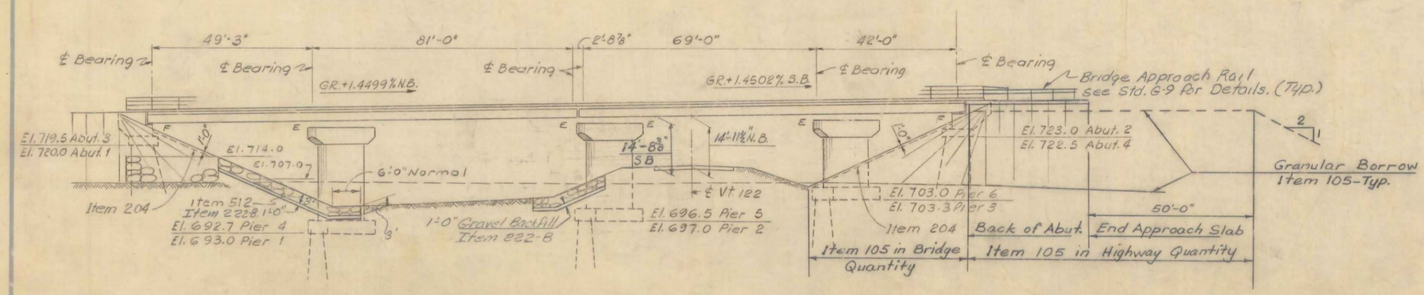

ELEVATION
EAST FASCIA OF NORTHBOUND ROADWAY SHOWN

LYNDON-IRASBURG
IM MEMB(29)
SHEET 20 OF 55
BRIDGE NO. 96S
FOR REFERENCE ONLY

Stage 2 Construction

Revised Stage II Plans, R. Gendron 8-30-72

REVISED CURBS TO 2'-0" HELD FASCIA. 8-70 CRO. & AG.C.

CONTRACT 1
STAGE 1 CONSTRUCTION

PREPARED BY
BLAUVELT ENGINEERING CO.
CONSULTING ENGINEERS
ORLEANS, VERMONT

STATE OF VERMONT
DEPARTMENT OF HIGHWAYS

PROJECT LYNDON - BARTON
TOWN OF LYNDON BR 96
ROUTE NO. I-91 LOG STA. 1287
I-91 OVER VT 122 & RELOC MILLER RUN
GENERAL PLAN
SCALE 1" = 20'
IN CHARGE H.C. MARGOLIS
DRAWN BY V. VERLATE CHECKED BY F. McELROY
PROJECT NO. I-91-3 (18)
SHEET 169 OF 185 BR 200

368 369