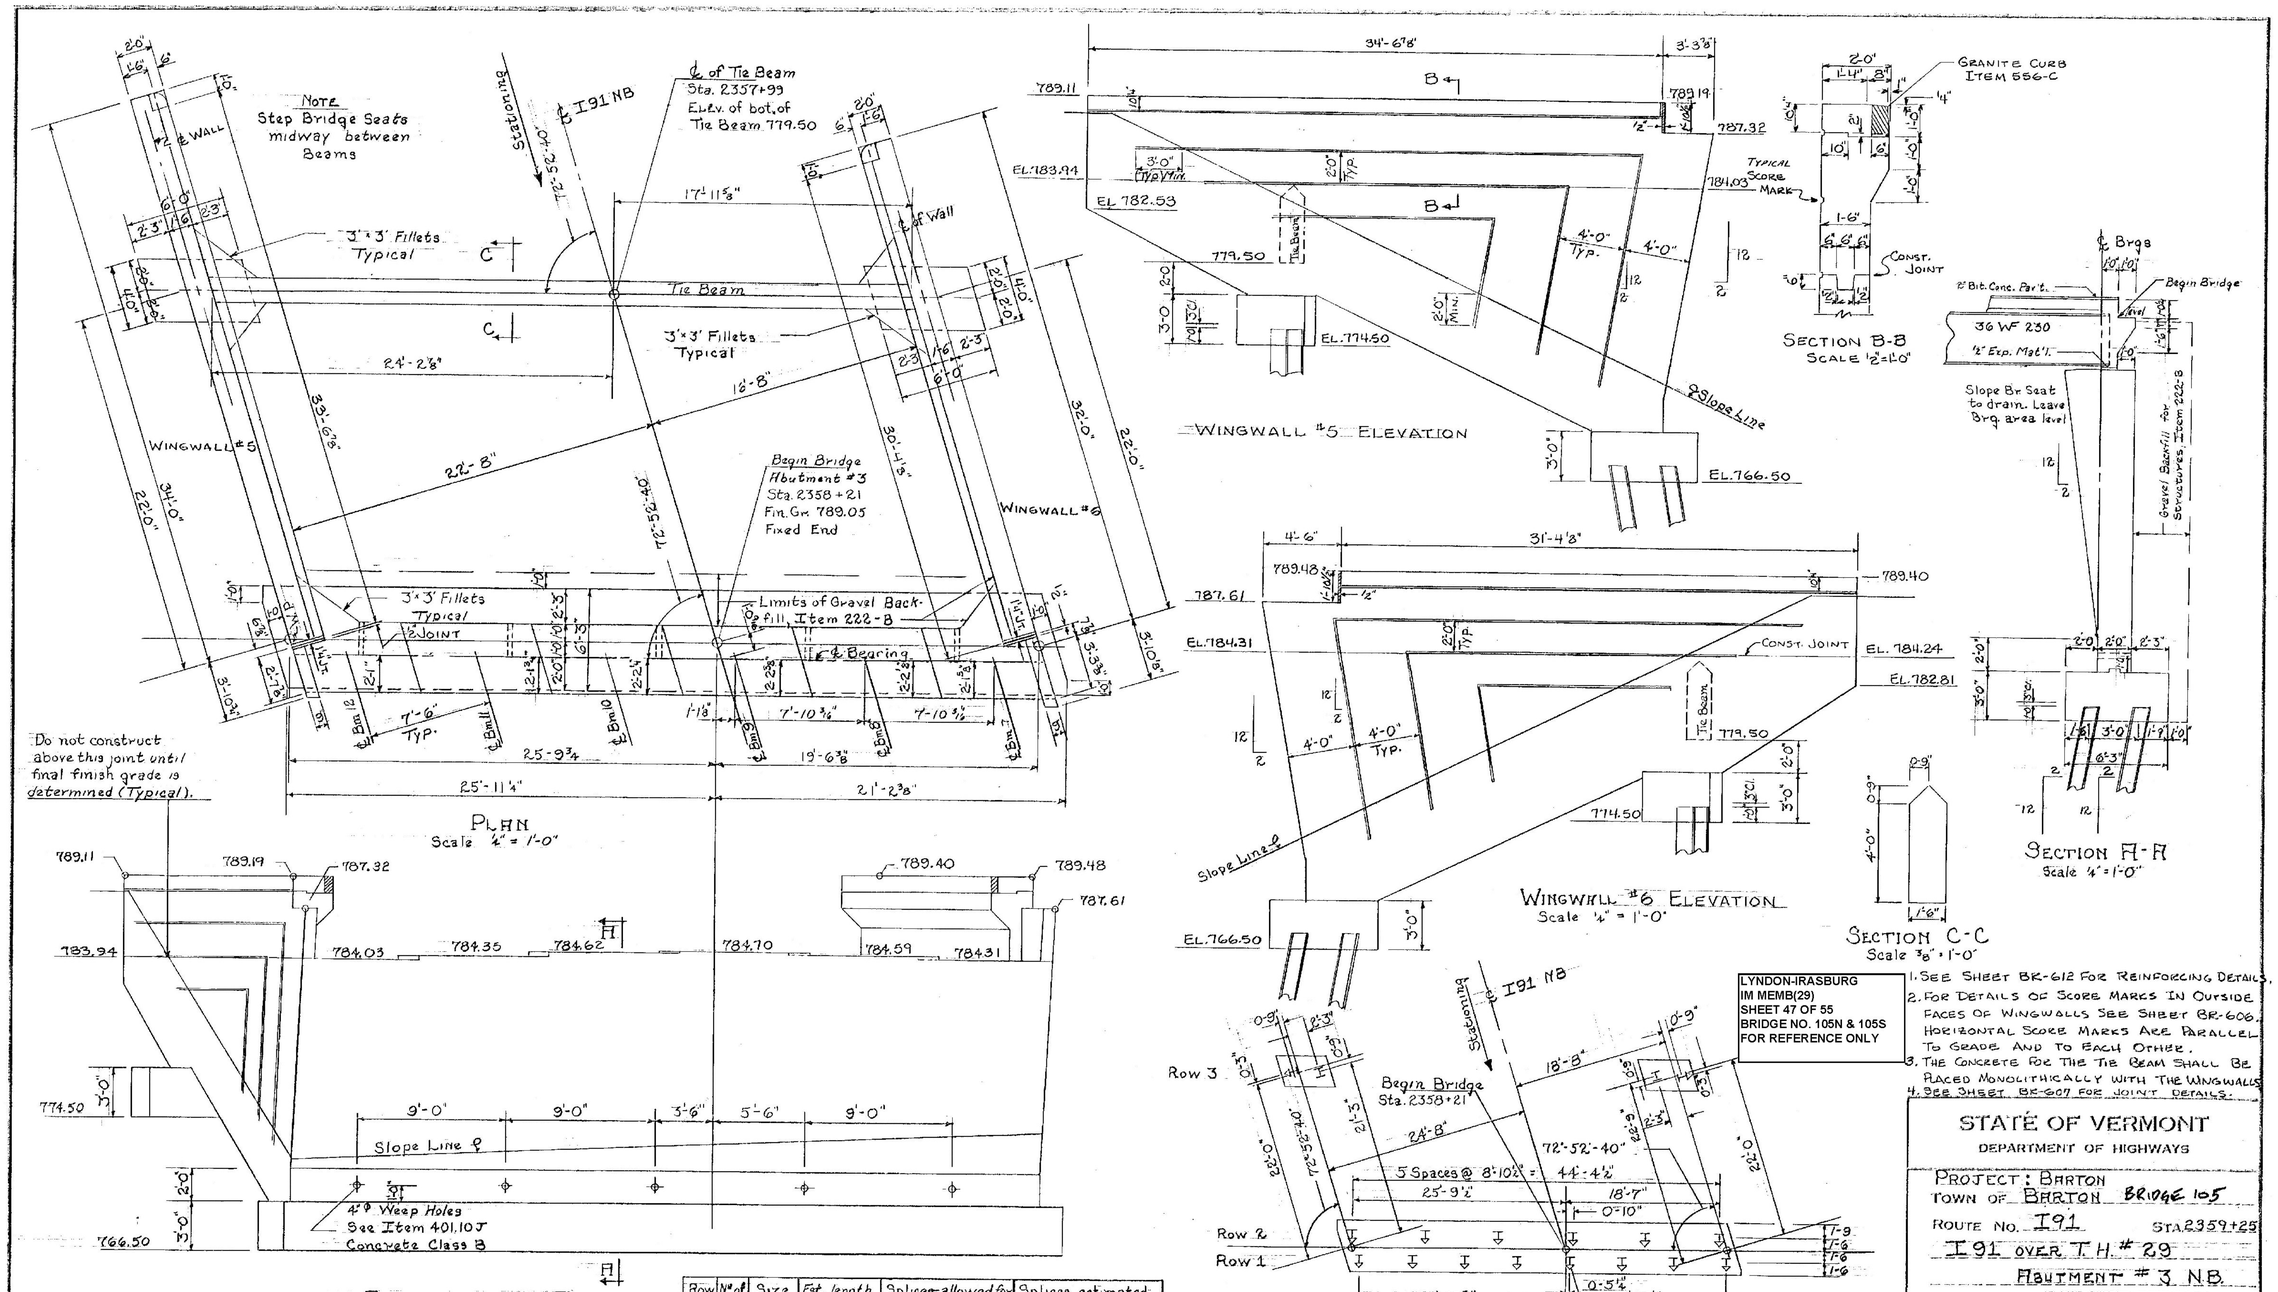

Row	No. of Piles	Size	Est. length of Piles	Splices allowed for piles not exceeding plan length. (To be paid for only if used)	Splices estimated for piles exceeding plan length (To be paid for only if used.)
1 & 2	14	12BP53	35	None	3
3	4	12BP53	45	None	1

LYNDON-IRASBURG
IM MEMB(29)
SHEET 47 OF 55
BRIDGE NO. 105N & 105S
FOR REFERENCE ONLY

1. See Sheet BR-612 for Reinforcing Details.
2. For Details of Score Marks in Outside Faces of Wingwalls See Sheet BR-606. Horizontal Score Marks Are Parallel to Grade and to Each Other.
3. The Concrete for the Tie Beam Shall Be Placed Monolithically with the Wingwalls.
4. See Sheet BR-607 for Joint Details.

Stage 1 Construction

STATE OF VERMONT
DEPARTMENT OF HIGHWAYS

PROJECT: BARTON
TOWN OF BARTON BRIDGE 105
ROUTE NO. I91 STA. 2359+25
I91 OVER T.H. # 29
ABUTMENT # 3 NB
SCALE As Noted
SECTION SUPERVISOR: F.W. Balkum - 4/10
DRAWN BY E.S. Snyder CHECKED BY BET 2/10
PROJECT NO. I91-3(11)
SHEET 199 OF 672 BR-610