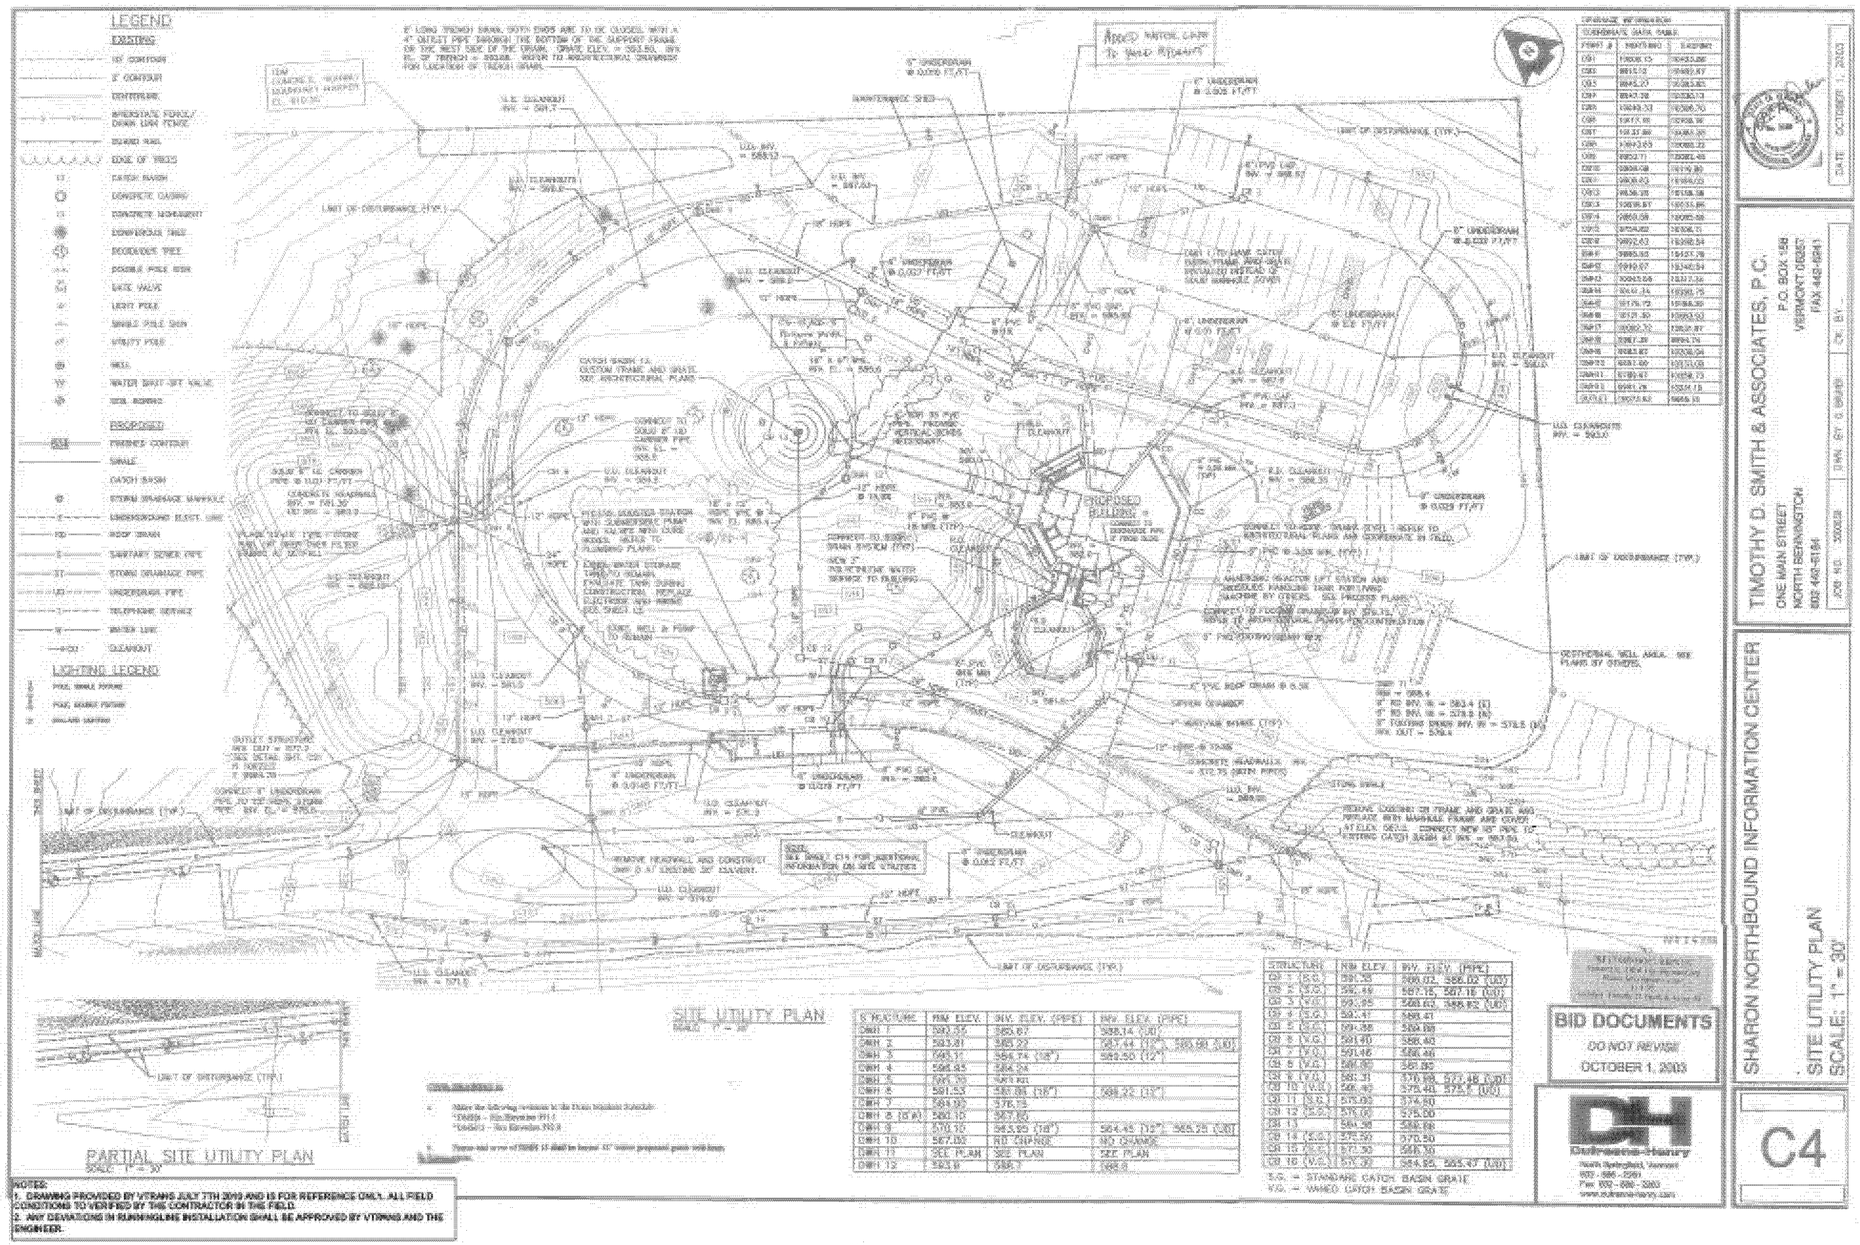


| STRUCTURE | RIM ELEV. | INV. ELEV. (PIPE) |
|---|---|---|
| CB 1 (S.G.) | 590.35 | 588.02, 588.02 (UD) |
| CB 2 (S.G.) | 590.49 | 587.16, 587.16 (UD) |
| CB 3 (S.G.) | 593.95 | 588.83, 588.82 (UD) |
| CB 4 (S.G.) | 592.41 | 588.41 |
| CB 5 (S.G.) | 591.38 | 589.88 |
| CB 6 (V.G.) | 591.40 | 588.40 |
| CB 7 (V.G.) | 591.46 | 588.46 |
| CB 8 (V.G.) | 588.80 | 581.80 |
| CB 9 (V.G.) | 581.31 | 578.98, 577.48 (UD) |
| CB 10 (V.G.) | 586.45 | 575.48, 575.5 (UD) |
| CB 11 (S.G.) | 575.00 | 574.50 |
| CB 12 (S.G.) | 575.00 | 575.00 |
| CB 13 | 584.34 | 580.88 |
| CB 14 (S.G.) | 575.50 | 570.50 |
| CB 15 (S.G.) | 571.50 | 568.50 |
| CB 16 (V.G.) | 575.00 | 584.85, 583.47 (UD) |

S.G. = STANDARD CATCH BASIN GRATE
V.G. = VANED CATCH BASIN GRATE

| STRUCTURE | RIM ELEV. | INV. ELEV. (PIPE) | INV. ELEV. (PIPE) |
|---|---|---|---|
| DMH 1 | 592.55 | 585.67 | 588.14 (UD) |
| DMH 2 | 593.81 | 585.27 | 587.44 (12"), 586.88 (UD) |
| DMH 3 | 591.31 | 584.74 (18") | 585.50 (12") |
| DMH 4 | 588.85 | 584.24 | |
| DMH 5 | 591.20 | 579.81 | |
| DMH 6 | 581.53 | 581.84 (18") | 581.22 (12") |
| DMH 7 | 584.00 | 576.13 | |
| DMH 8 (S.W) | 580.10 | 567.80 | |
| DMH 9 | 570.10 | 565.95 (18") | 564.45 (12"), 565.25 (UD) |
| DMH 10 | 567.00 | NO CHANGE | NO CHANGE |
| DMH 11 | SEE PLAN | SEE PLAN | SEE PLAN |
| DMH 12 | 592.9 | 588.3 | 588.8 |

PROVIDED BY VTRANS - FOR REFERENCE ONLY

| | |
|---|---|
| PROJECT NAME: HARTFORD SHARON | |
| PROJECT NUMBER: FITS503 | |
| FILE NAME: z06e142HRA.dgn | PLOT DATE: 9/16/2010 |
| PROJECT LEADER: J. YOUNG | DRAWN BY: S. GUNN |
| DESIGNED BY: J. DURANTE | CHECKED BY: J. YOUNG |
| HARTFORD RA REFERENCE PLAN | SHEET 42 OF 70 |