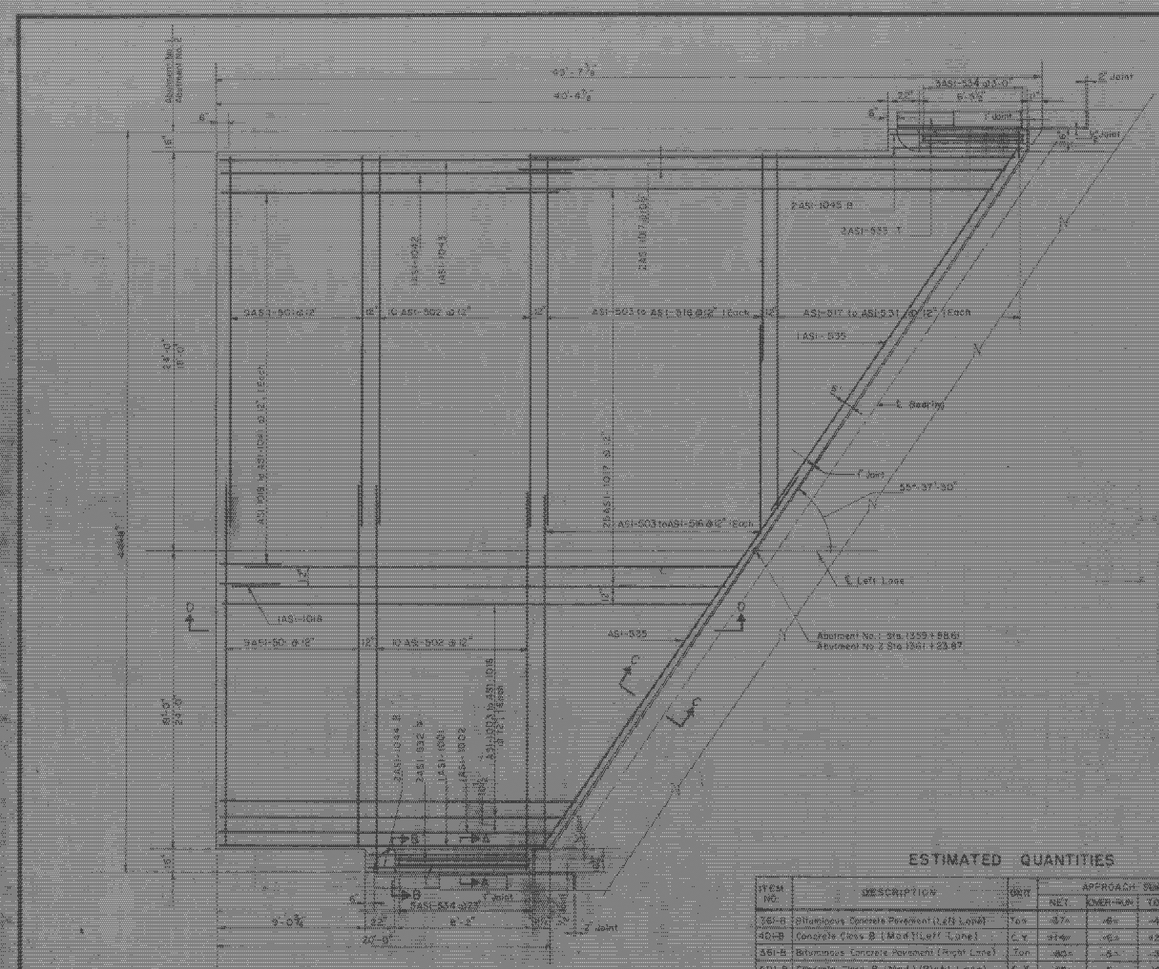

APPROACH SLAB - ABUTMENT NO. 1
APPROACH SLAB-ABUTMENT NO. 2 (SIMILAR UNLESS NOTED OTHERWISE)
SCALE: ¼" = 1'-0"

## ESTIMATED QUANTITIES

| ITEM NO. | DESCRIPTION | UNIT | APPROACH SLABS NET | OVER-RUN | TOTAL | FINAL |
|---|---|---|---|---|---|---|
| 361-B | Bituminous Concrete Pavement (Left Lane) | Ton | 437 | 65 | 432 | 46 |
| 401-B | Concrete Class B (Modified) (Left Lane) | C.Y. | 314 | 63 | 420 | 117 |
| 361-B | Bituminous Concrete Pavement (Right Lane) | Ton | 403 | 63 | 466 | 39 |
| 401-B | Concrete Class B (Modified) (Right Lane) | C.Y. | 355 | 57 | 400 | 70 |
| 402 | Reinforcing Steel | Lbs | See Reinforcing Schedule Sh. No. 20 | | | |
| 656-C | Granite Bridge Curb (Type I) | L.F. | See Sheet No. 102 | | | |

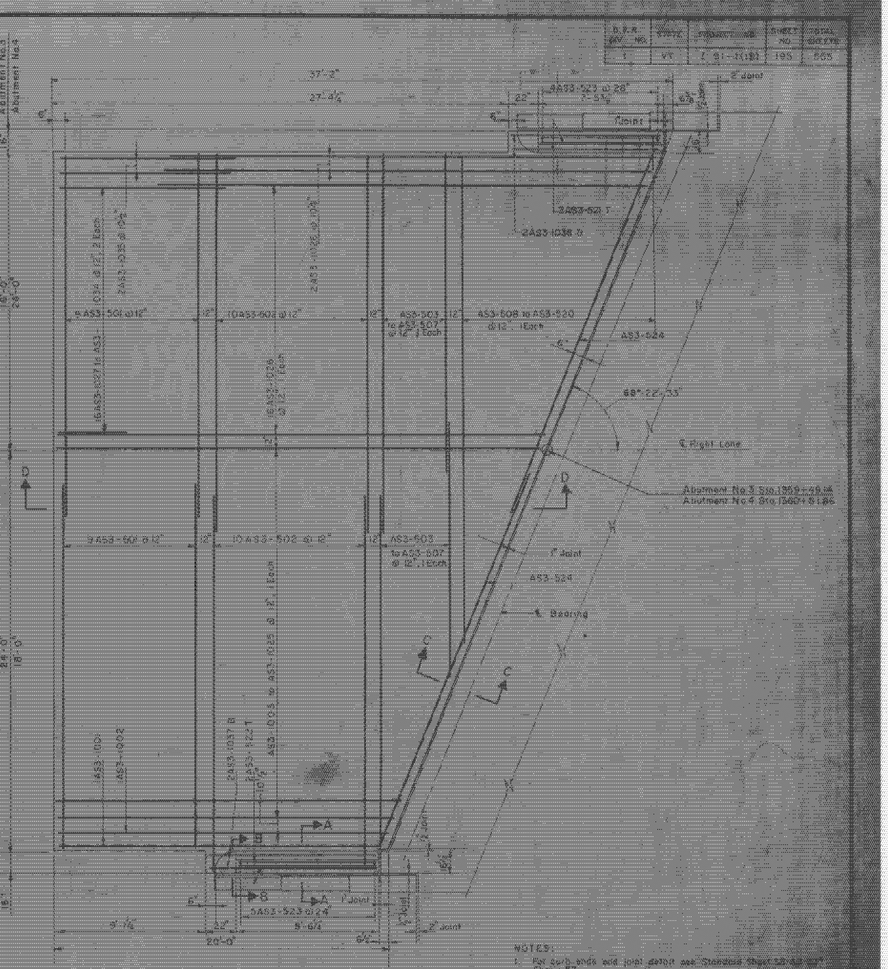

APPROACH SLAB - ABUTMENT NO 3
APPROACH SLAB - ABUTMENT NO. 4 (SIMILAR UNLESS NOTED OTHERWISE)
SCALE: ¼" = 1'-0"

NOTES:
1. For curb ends and joint detail see Standard Sheet SD-42 and Sheet 57.
2. For Sections A-A, B-B, C-C, and D-D, see Standard Sheet SB-AS 30 and Sheet 57.
3. All cover to be 2" unless noted otherwise.
4. Approach Slab - Abutment No. 2 Reinforcing same as Approach Slab - Abutment No. 1 except as noted on this sheet.
5. Approach Slab - Abutment No. 4 Reinforcing same as Approach Slab - Abutment No. 3 except as noted on this sheet.

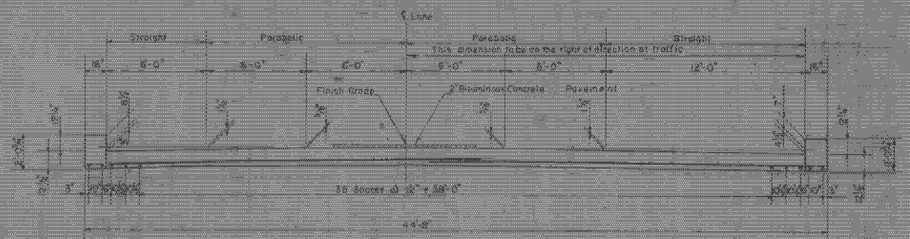

TYPICAL APPROACH SLAB CROSS SECTION
SCALE: ¼" = 1'-0"

IR-DECK(26)
BR18N&S
THIS SHEET FOR INFORMATION ONLY

WESTMINSTER - NORWICH
IM MEMB(30)
SHEET 17 OF 38
FOR REFERENCE ONLY