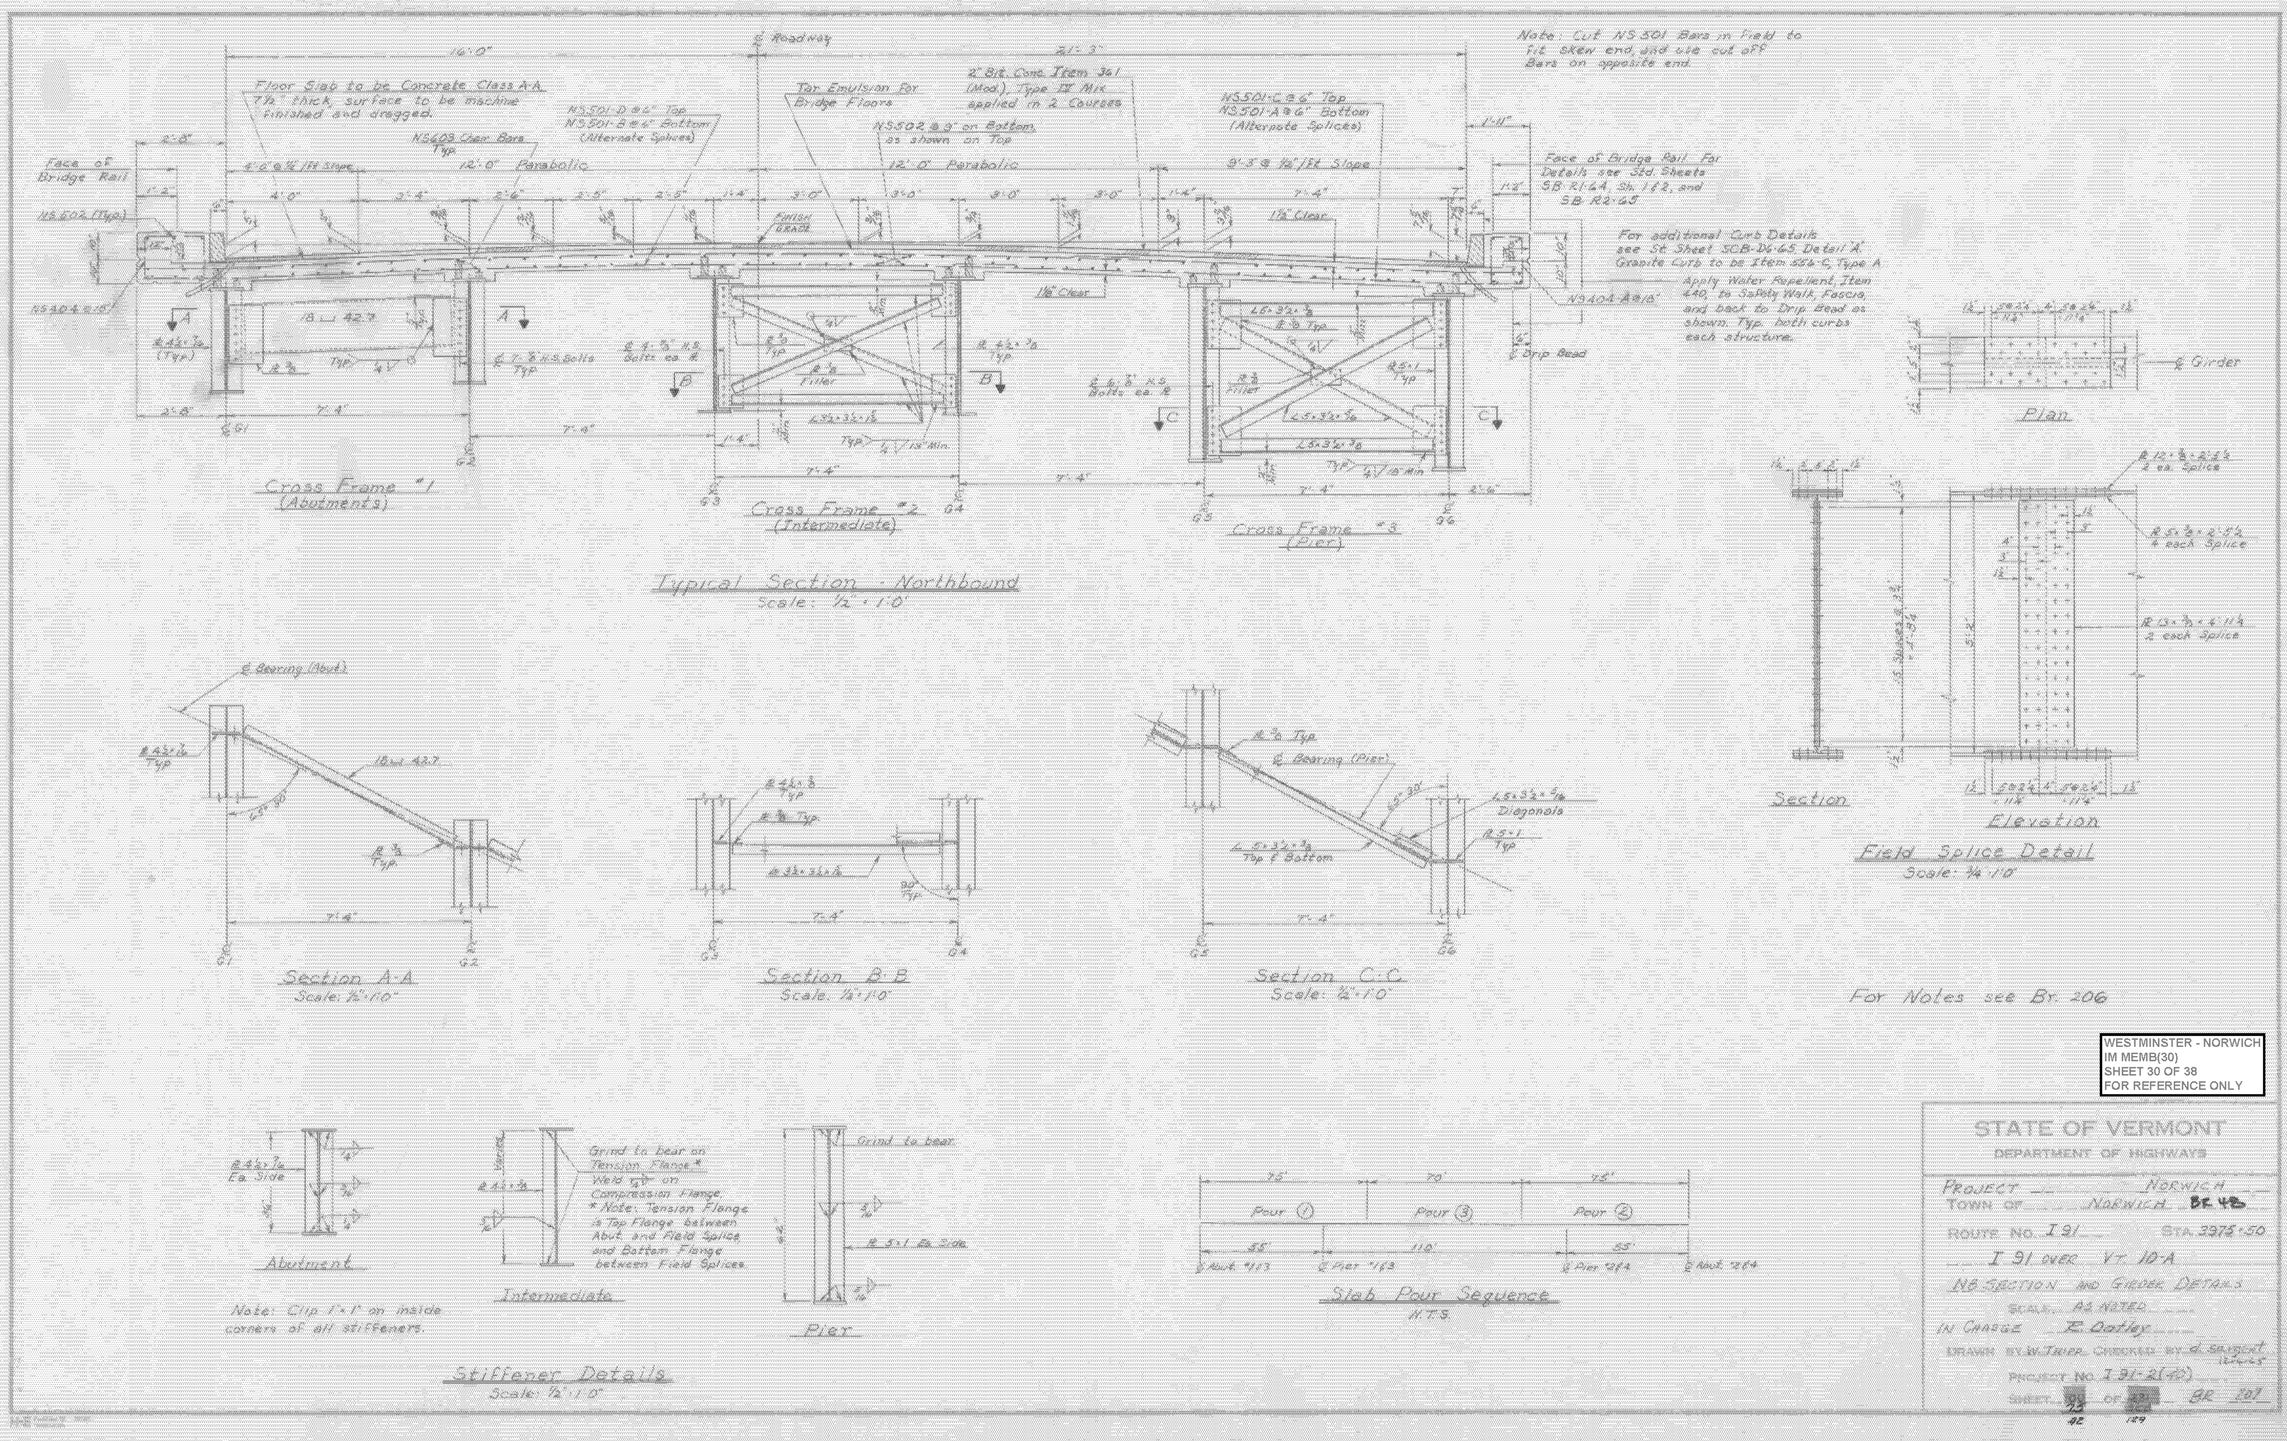

WESTMINSTER - NORWICH
IM MEMB(30)
SHEET 30 OF 38
FOR REFERENCE ONLY

STATE OF VERMONT
DEPARTMENT OF HIGHWAYS

PROJECT NORWICH
TOWN OF NORWICH BF. 48
ROUTE NO. I-91 STA. 3978+50
I 91 OVER VT. 10-A
NB SECTION AND GIRDER DETAILS
SCALE AS NOTED
IN CHARGE R. Dailey
DRAWN BY W. Tyler CHECKED BY d. Sargent
PROJECT NO. I 91-2(90)
SHEET 30 OF 38 BR 207