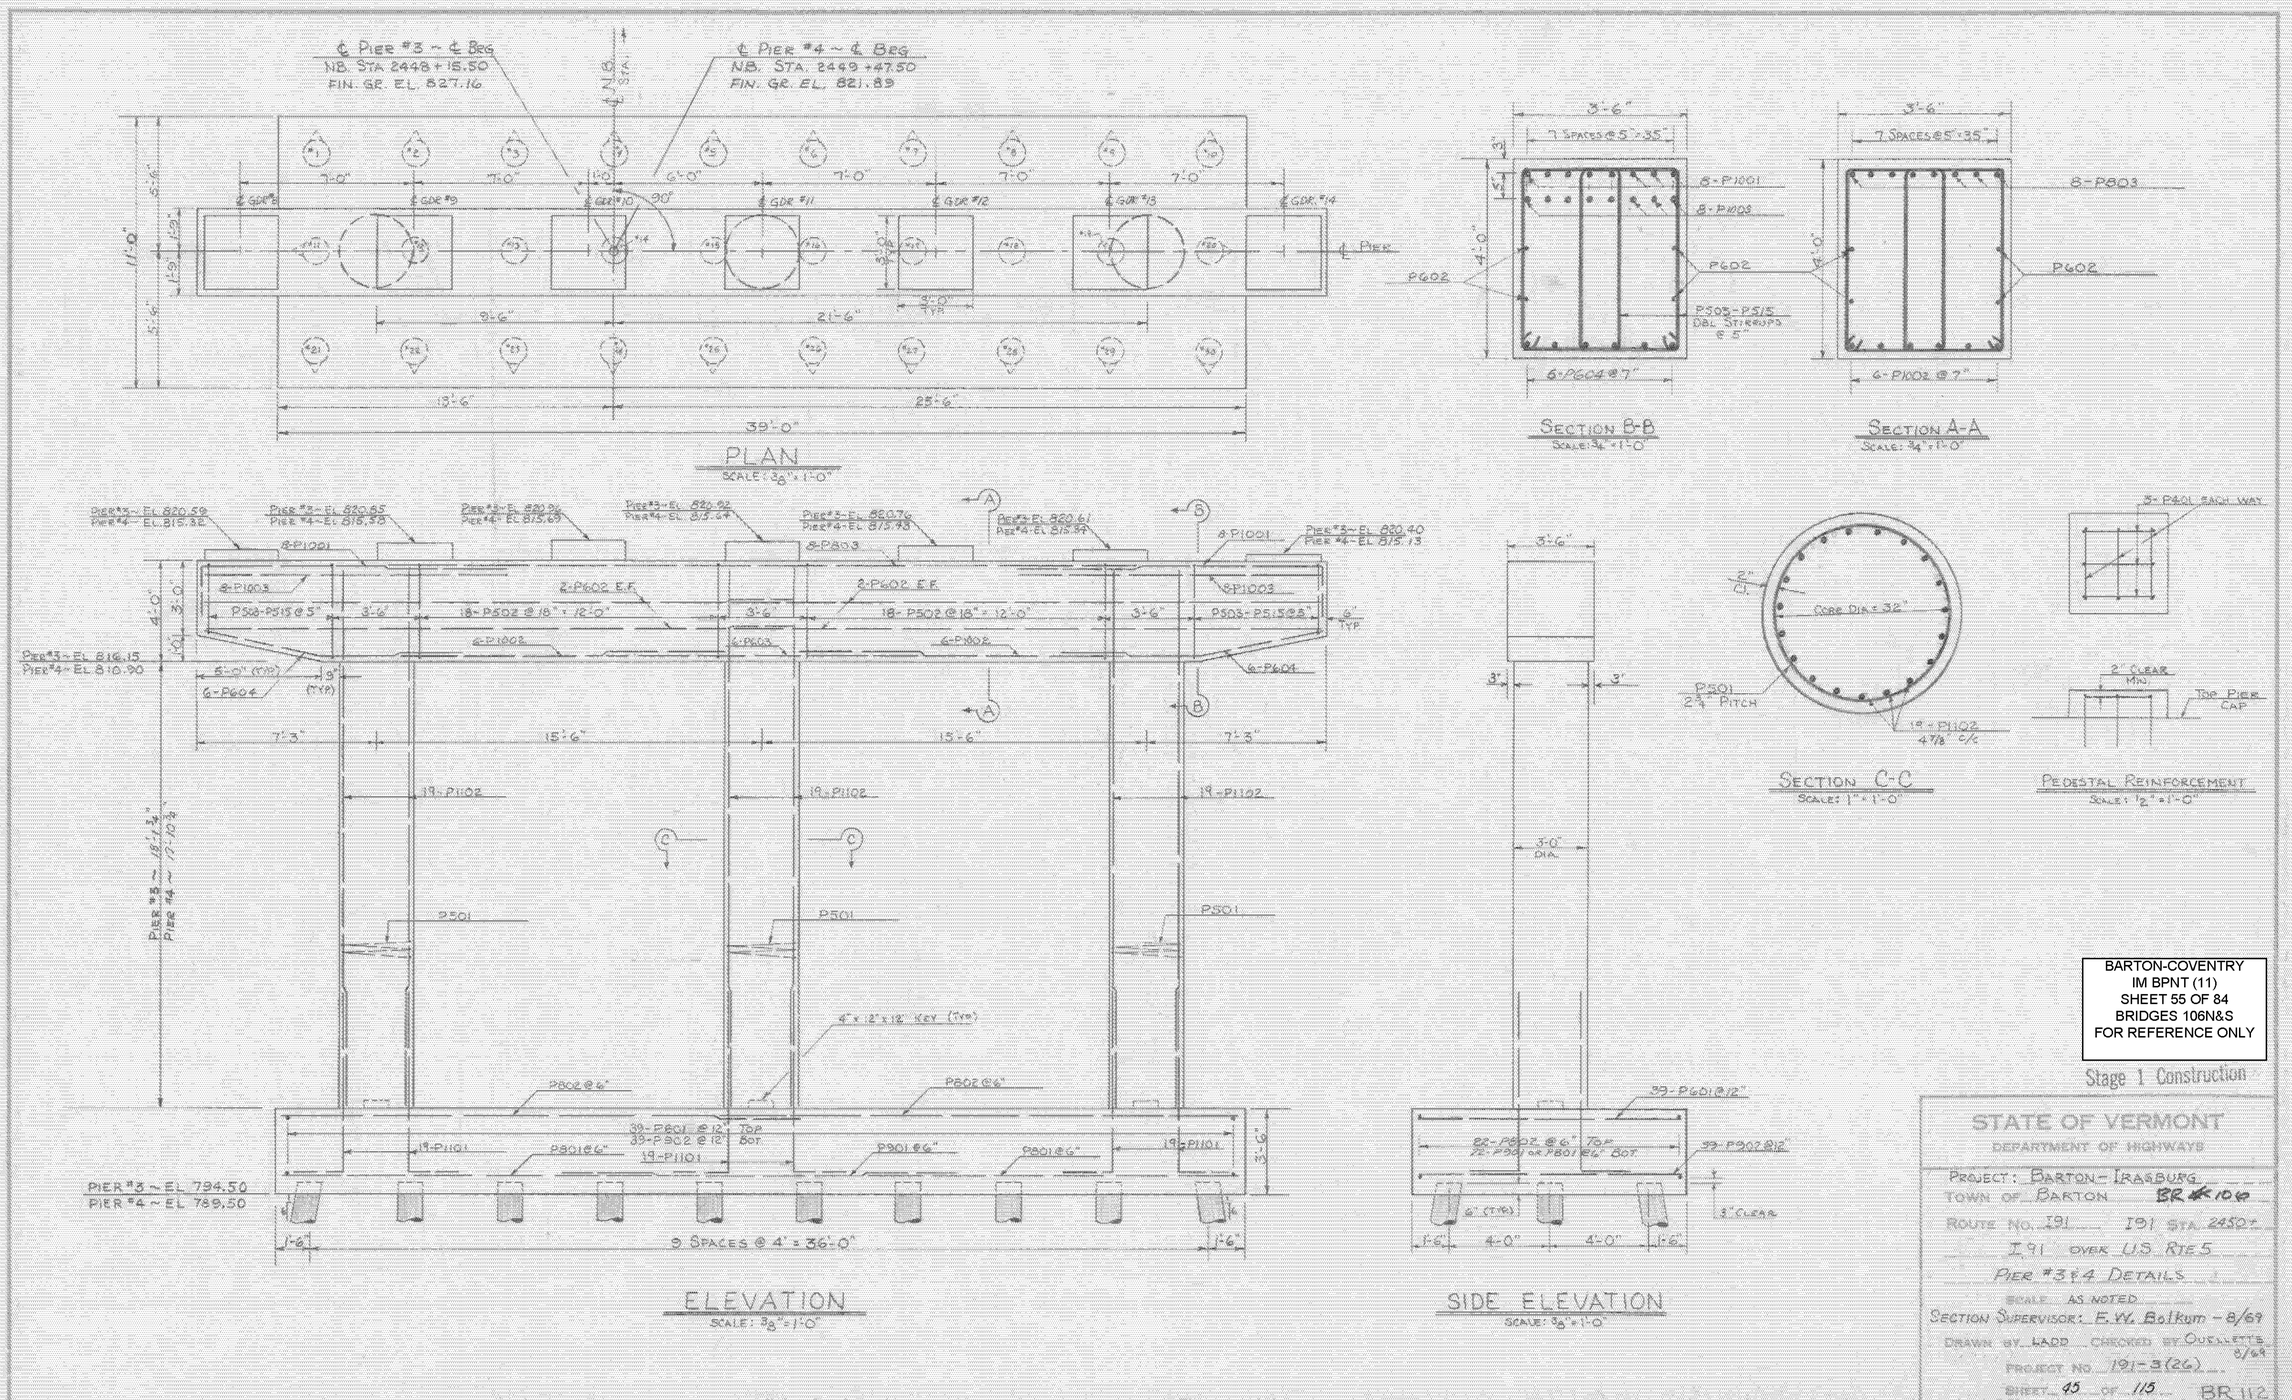

BARTON-COVENTRY
IM BPNT (11)
SHEET 55 OF 84
BRIDGES 106N&S
FOR REFERENCE ONLY

STATE OF VERMONT
DEPARTMENT OF HIGHWAYS

Project: Barton-Irasburg
Town of Barton BR 106
Route No. 191 191 Sta. 2450+
I 91 over U.S. Rte 5
Pier #3 & 4 Details
Scale As noted
Section Supervisor: E.W. Bolkum - 8/69
Drawn by Ladd Checked by Ouellette 8/69
Project No. 191-3(26)
Sheet 45 of 115 BR 112