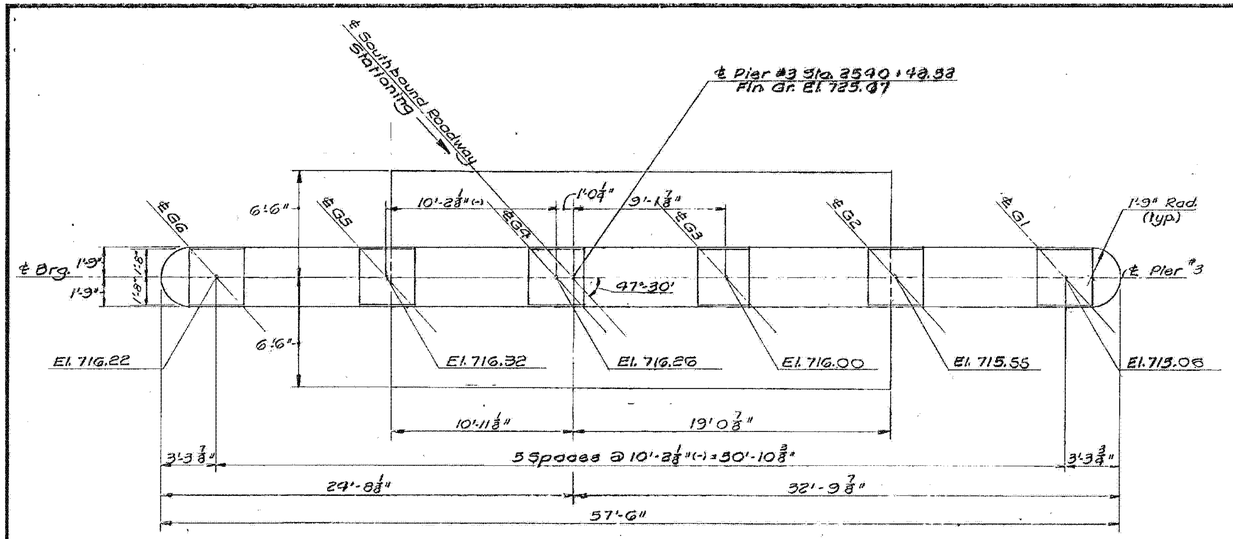

PLAN

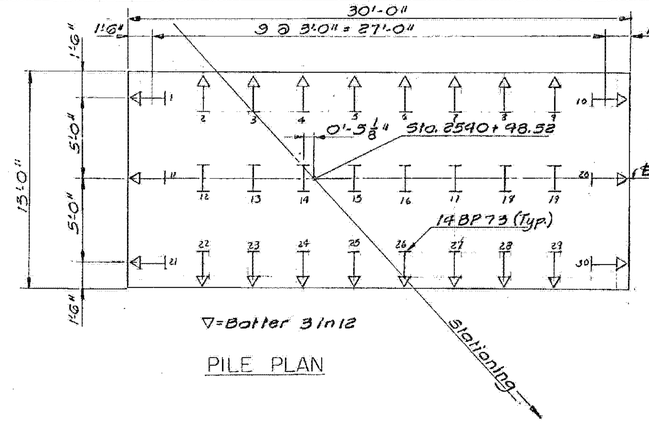

PILE PLAN

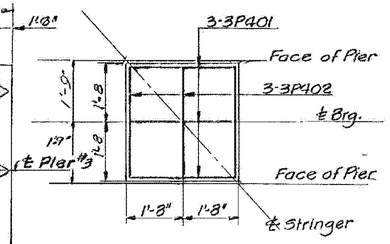

BEARING PAD REINFORCEMENT

SCALE: 1/2" = 1'-0"

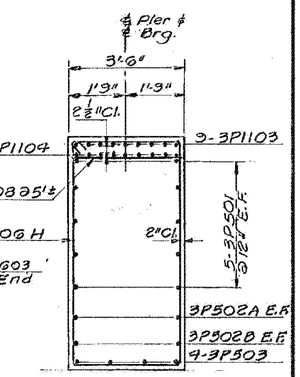

SECTION B-B

SCALE: 1/2" = 1' - 0"

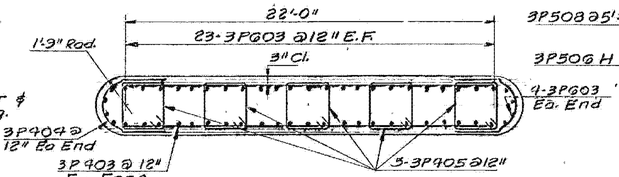

SECTION A-A

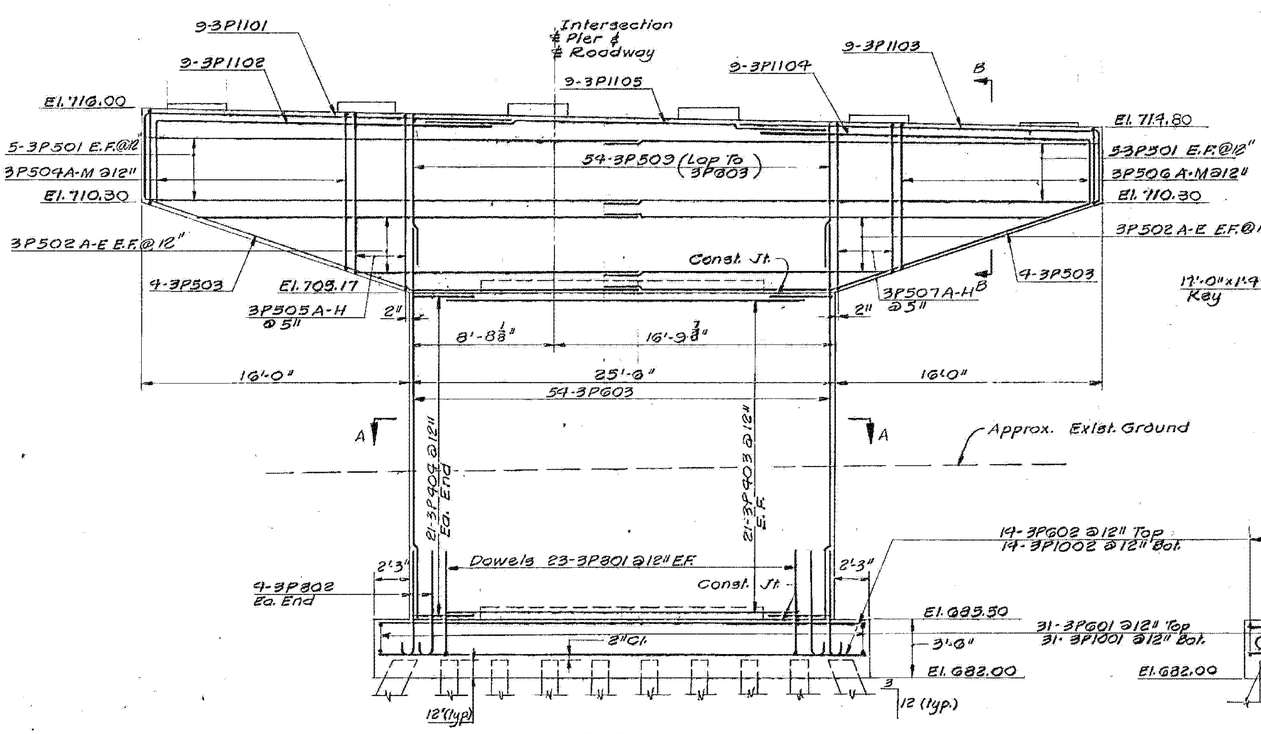

ELEVATION

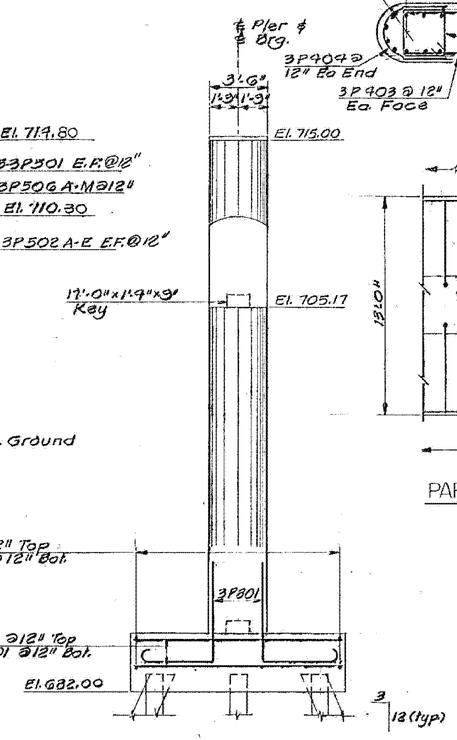

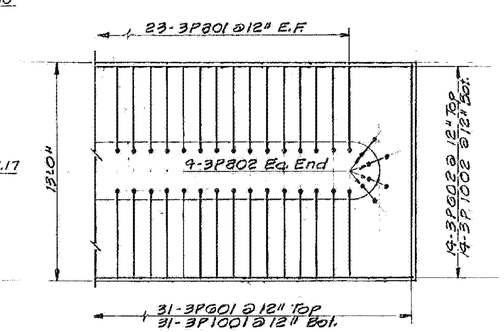

PARTIAL PLAN OF FOOTING REINFORCEMENT

BARTON-COVENTRY
IM BPNT (11)
SHEET 69 OF 84
BRIDGE 102N&S
FOR REFERENCE ONLY

Br. 121 OF 129

STATE OF VERMONT
DEPARTMENT OF HIGHWAYS

PROJECT IRASBURG - DERBY
TOWN OF IRASBURG
ROUTE No. I-91 STA. 2539±
I91 OVER BARTON RIVER AND SA# 3
PIER # 3
SCALE 1/4" = 1'-0" Except as Noted
IN CHARGE C. TERENZIO
DRAWN BY J.B.M. CHECKED BY A. CENTORE
PROJECT No. I91-3(8) 9-67
SHEET 190 OF 608 BR. 121