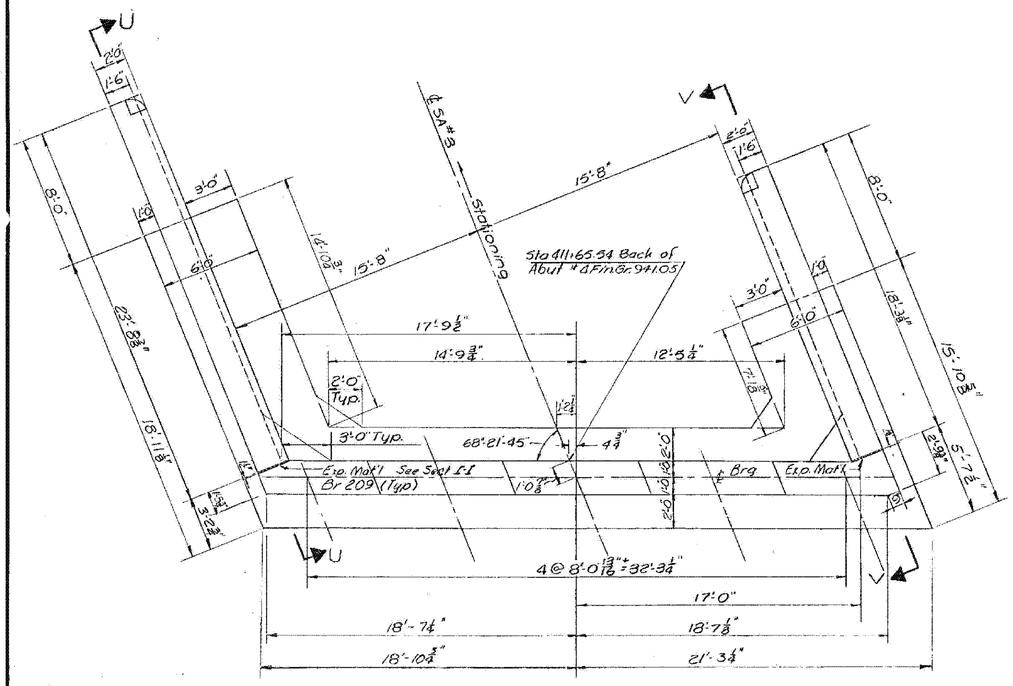

PLAN

For Corner Reinforcing Details, Superstructure Details At Abutment And Abutment Notes See Br. Sh. 207
For Curb Joint Detail See Br. Sh. 209

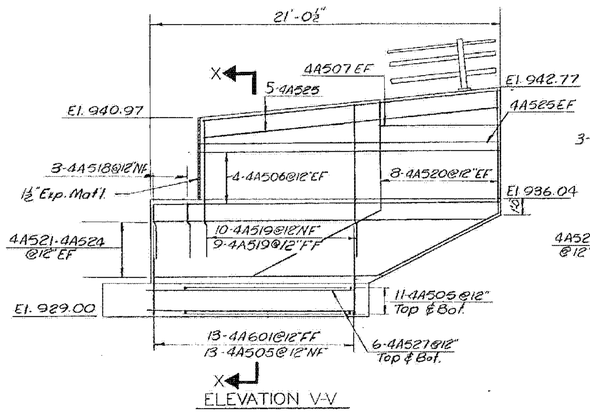

ELEVATION V-V

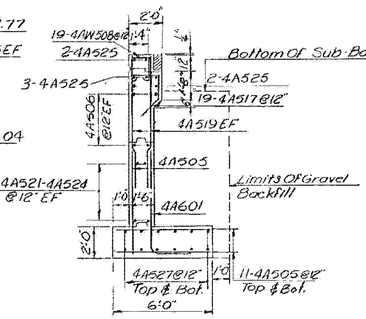

SECTION X-X

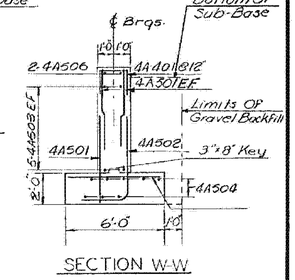

SECTION W-W

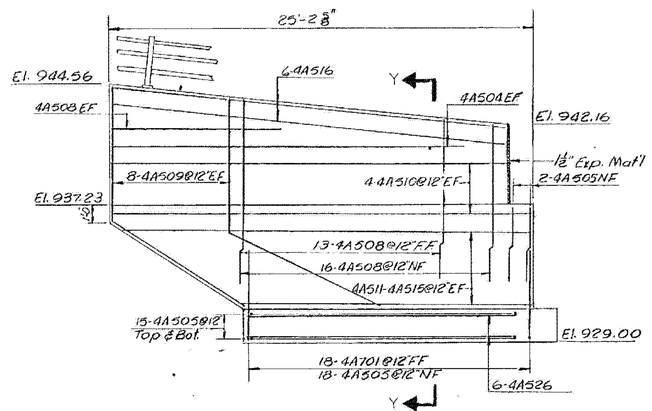

ELEVATION U-U

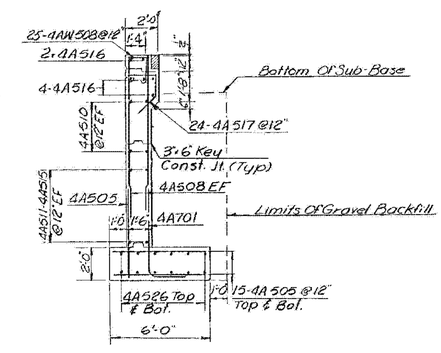

SECTION Y-Y

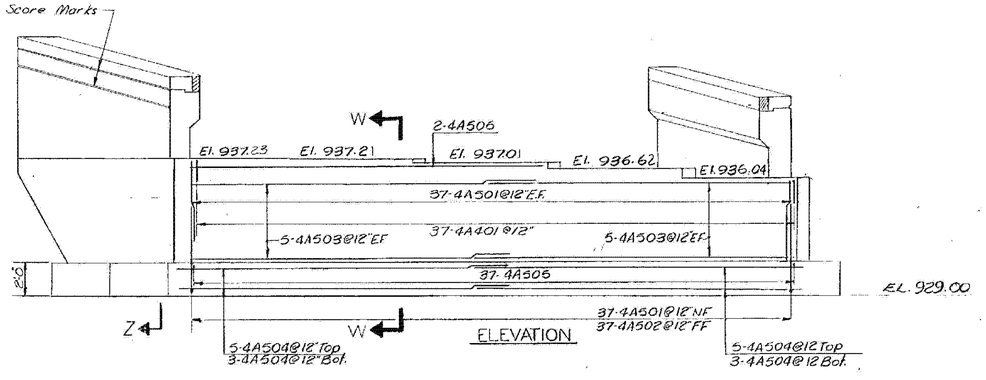

ELEVATION

ITEM NO.	ITEM	UNIT	NET		TOTAL	FINAL
	CHAN. EXCAV. OF EARTH	C. Y.				
	CHAN. EXCAV. OF ROCK	C. Y.				
	UNCLASS. CHAN. EXCAV.	C. Y.				
	STRUCT. EXCAV.	C. Y.				
	CONC. CLASS AA (MOD.)	C. Y.				
	CONC. CLASS B (MOD.)	C. Y.				
	REINF. STEEL	LBS.				
	ASPHALTIC-ASB. COATING	S. Y.				
	TREATED TIMBER PILING	L. F.				
	SPLICES FOR STEEL PILING	EA.				
	STEEL PILING	L. F.				
	UNTREATED TIMBER PILING	L. F.				

Same Changes as BR 207

BARTON-COVENTRY
IM BPNT (11)
SHEET 84 OF 84
BRIDGES 108N&S
FOR REFERENCE ONLY

BR210 OF 212

STATE OF VERMONT
DEPARTMENT OF HIGHWAYS

PROJECT IRASBURG-DERBY
TOWN OF COVENTRY
ROUTE NO. I-91 STA. 2683+
SA3 OVER I-91
ABUTMENT #4
SCALE 1/4 IN.=1 FT.
IN CHARGE EDWARDS & KELCEY
DRAWN BY DLEE CHECKED BY ACENTORE 4-66
PROJECT NO. I-91-3(8)
SHEET 209 OF 605 BR 210