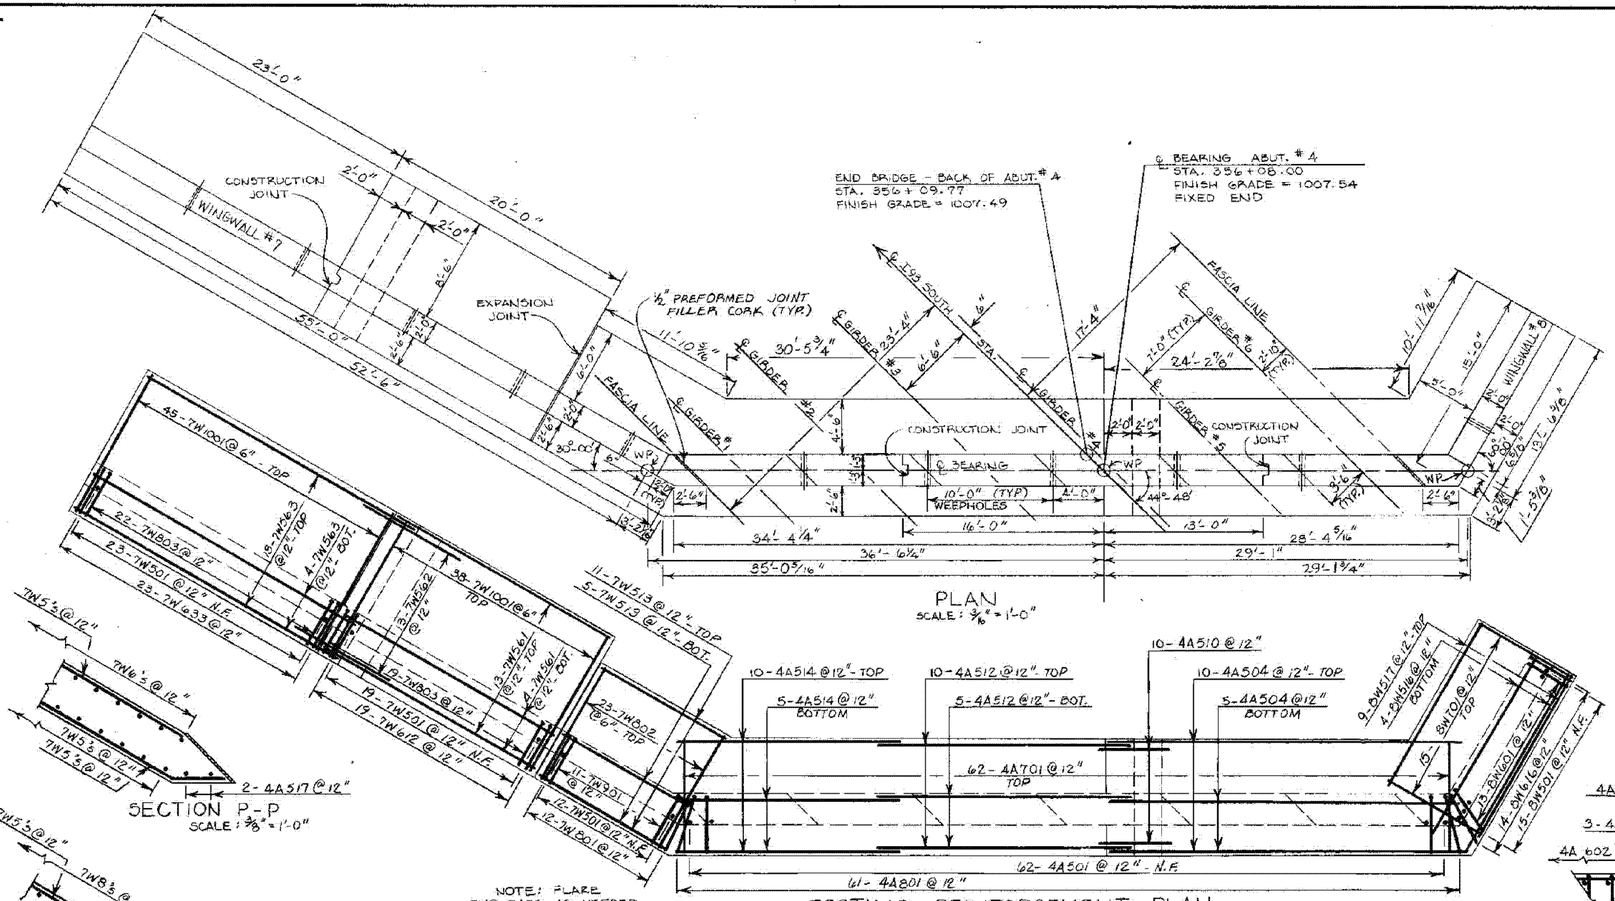

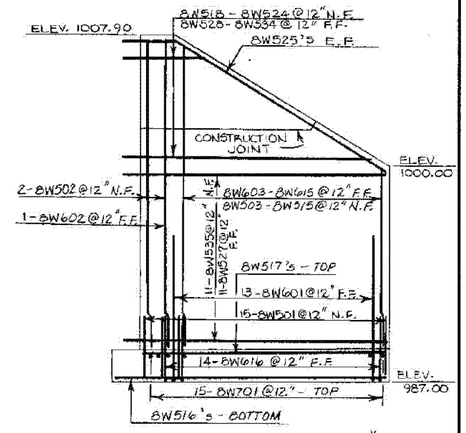

ELEVATION - WINGWALL # 8
SCALE: 1/4" = 1'-0"

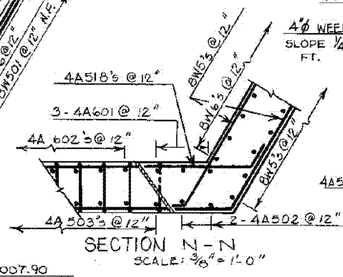

SECTION N-N
SCALE: 3/8" = 1'-0"

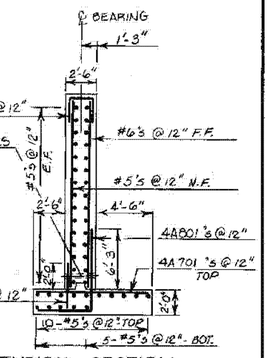

TYPICAL SECTION - ABUTMENT # 4
SCALE: 3/16" = 1'-0"

I-93 BRIDGES 5N&S

WATERFORD
IM MEMB(31)
SHEET 42 OF 48
FOR REFERENCE ONLY

STATE OF VERMONT
AGENCY OF TRANSPORTATION

TOWN OF WATERFORD	Bridge No. 57
HIGHWAY NO. I 93	Log Sta. / Surv. Sta. 354+83
I93 SOUTHBOUND OVER TH # 7	
ABUTMENT NO. 4 DETAILS	
Designed by G.S. ROGERS	Drawn by G.L. DAVIS
Checked by G.S. ROGERS date 6-80	Bridge Design Supervisor F.W. Bolkum date 7/80
PROJECT WATERFORD	PROJECT NO. I93-1(3)CONTR.#2
Bridge Sheet No. BR713	Sheet 164 of 531

BRUNING 44 131 80 (5)

BR-4