TEMPORARY 6 INCH WHITE LINE, PAINT
DURABLE 6 INCH WHITE LINE, POLYUREA
NORTHBOUND
128.699 TO 131.500 SOLID RT
128.699 TO 131.500 DASHED CL
SOUTHBOUND
128.698 TO 131.500 SOLID LT
128.698 TO 131.500 DASHED CL

TEMPORARY 6 INCH YELLOW LINE, PAINT
DURABLE 6 INCH YELLOW LINE, POLYUREA
NORTHBOUND
128.699 TO 131.500 SOLID LT
SOUTHBOUND
128.698 TO 131.500 SOLID RT

REHAB. DROP INLETS,
CATCH BASINS, OR MANHOLES,
CLASS I OR CLASS II
NORTHBOUND
128.897 LT (DI)
128.897 RT (DI)
SOUTHBOUND
128.872 LT (DI)
128.872 RT (DI)

SPECIAL PROVISION
(CAP CURB DROP INLET)
NORTHBOUND
129.966 RT (DI)(PLUGGED)
130.078 RT (DI)(PLUGGED)
SOUTHBOUND
130.049 LT (DI)(PLUGGED)

SPECIAL PROVISION
(DECOMMISSION CURB DROP INLET)
NORTHBOUND
129.862 RT (DI)
130.014 RT (DI)
130.260 RT (DI)
130.316 RT (DI)
130.411 RT (DI)
130.468 RT (DI)
130.544 RT (DI)
130.905 RT (DI)
SOUTHBOUND
129.995 LT (DI)
130.126 LT (DI)
130.515 LT (DI)
130.710 LT (DI)
130.816 LT (DI)

BITUMINOUS CONCRETE CURB, TYPE A
REMOVAL OF EXISTING CURB
STEEL BEAM GUARDRAIL, GALVANIZED
STEEL BEAM GUARDRAIL, GALVANIZED W/8' POSTS
MANUFACTURED TERMINAL SECTION, FLARED
ANCHOR FOR STEEL BEAM RAIL
REPLACE GUARDRAIL POST ASSEMBLY
REPLACE GUARDRAIL BEAM UNIT
REMOVAL AND DISPOSAL OF GUARDRAIL
DELINEATOR WITH STEEL POST
SEE ITEM DETAIL SUMMARY SHEETS

STONE FILL TYPE I
GEOTEXTILE UNDER STONE FILL
SEE DITCH CLEANING SHEETS

REMOVING SIGNS
AS SHOWN - 18

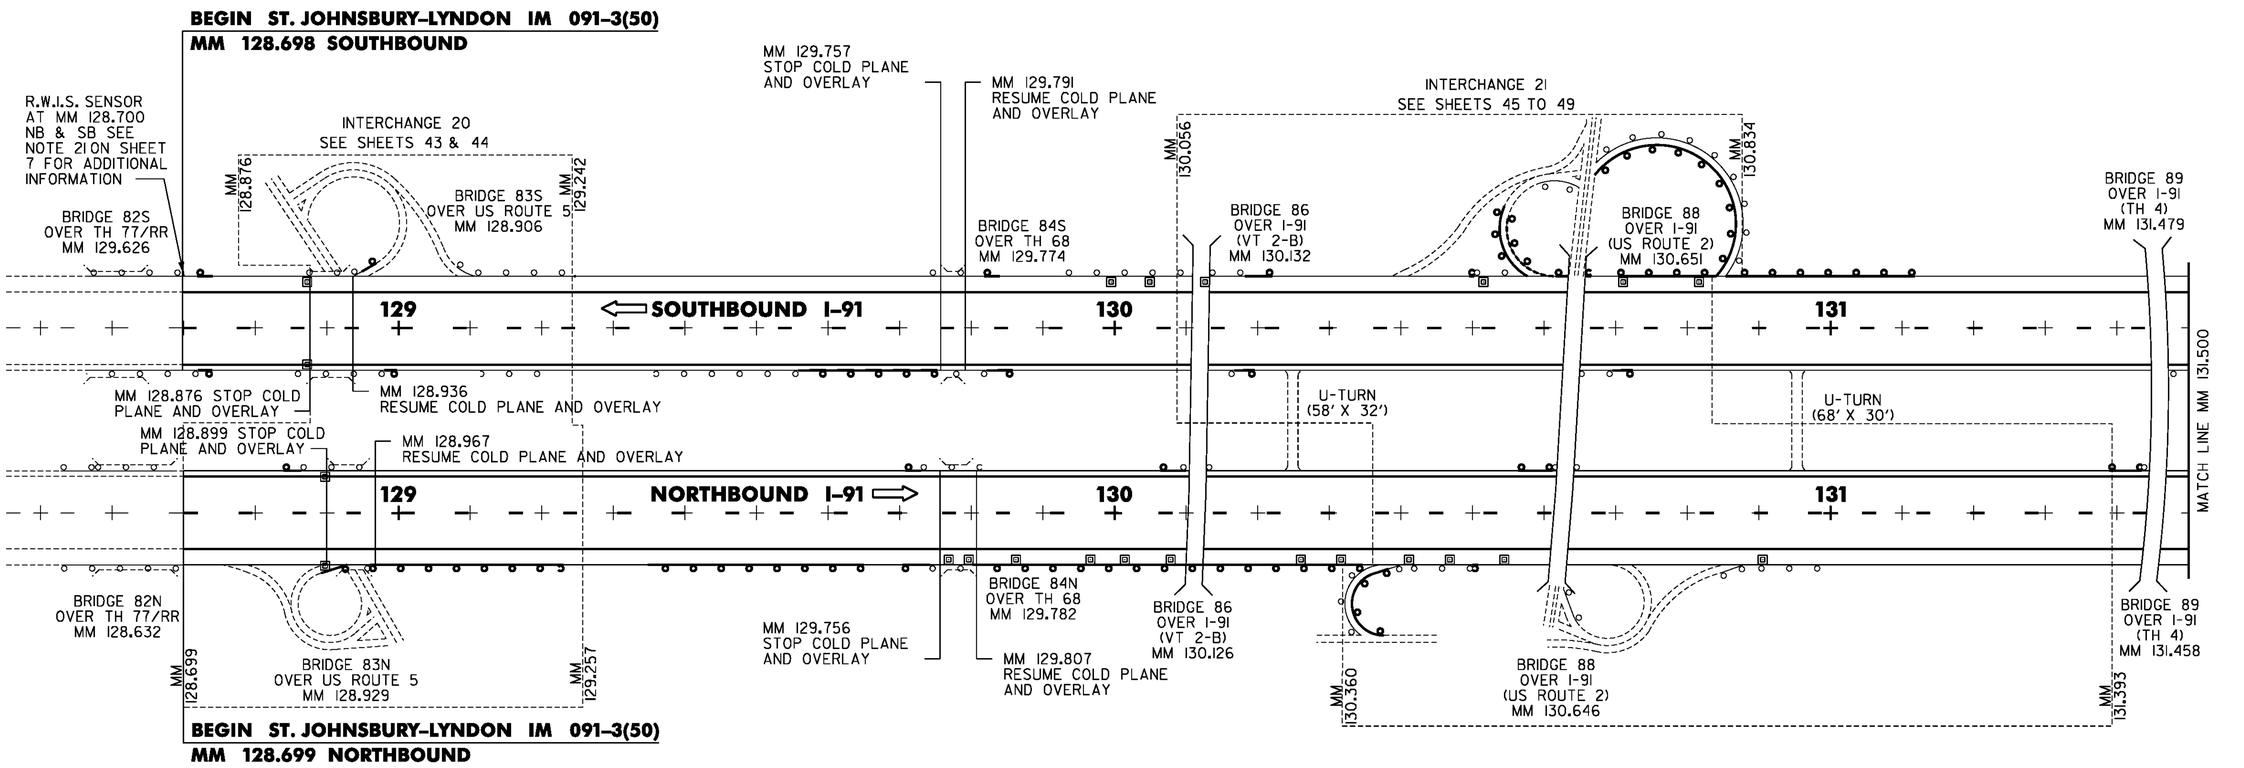

NORTHBOUND
PAVEMENT CORES (IN SHOULDERS)

#	MM	DEPTH	PCC
1	129.40	4.50	NO
2	130.00	6.00	NO
3	130.80	4.25	NO
4	131.40	5.00	NO

SOUTHBOUND
PAVEMENT CORES (IN SHOULDERS)

#	MM	DEPTH	PCC
14	129.00	5.25	NO
15	129.50	5.75	NO
16	130.00	5.50	NO
17	130.50	5.75	NO
18	131.00	5.50	NO
19	131.50	5.25	NO

NB 127.500 RT
NB 127.500 LT
SB 128.450 LT
NB 129.100 RT

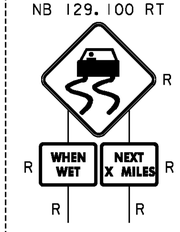

NB 131.195 RT
SB 130.100 LT

NB 131.195 RT
SB 130.100 LT

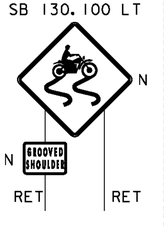

NOT TO SCALE

LEGEND

R	=	REMOVE EXISTING
S	=	SALVAGE
R&S	=	REMOVE AND SALVAGE
N	=	NEW
RET	=	RETAIN
B-B	=	BACK TO BACK
	=	EXISTING GUARDRAIL
	=	PROPOSED GUARDRAIL
YL	=	YELLOW LINE
WL	=	WHITE LINE
	=	DELINEATOR

MAINLINE LAYOUT 1

PROJECT NAME: ST. JOHNSBURY-LYNDON
PROJECT NUMBER: IM 091-3(50)

FILE NAME: lla346/cos/zlla346bdr_nu.dgn
PROJECT LEADER: PTS
DESIGNED BY: NLL
IPARM FILE NAME: plla346_40
PLOT DATE: 10/17/2013
DRAWN BY: JLS
CHECKED BY: PTS
SHEET 40 OF 72