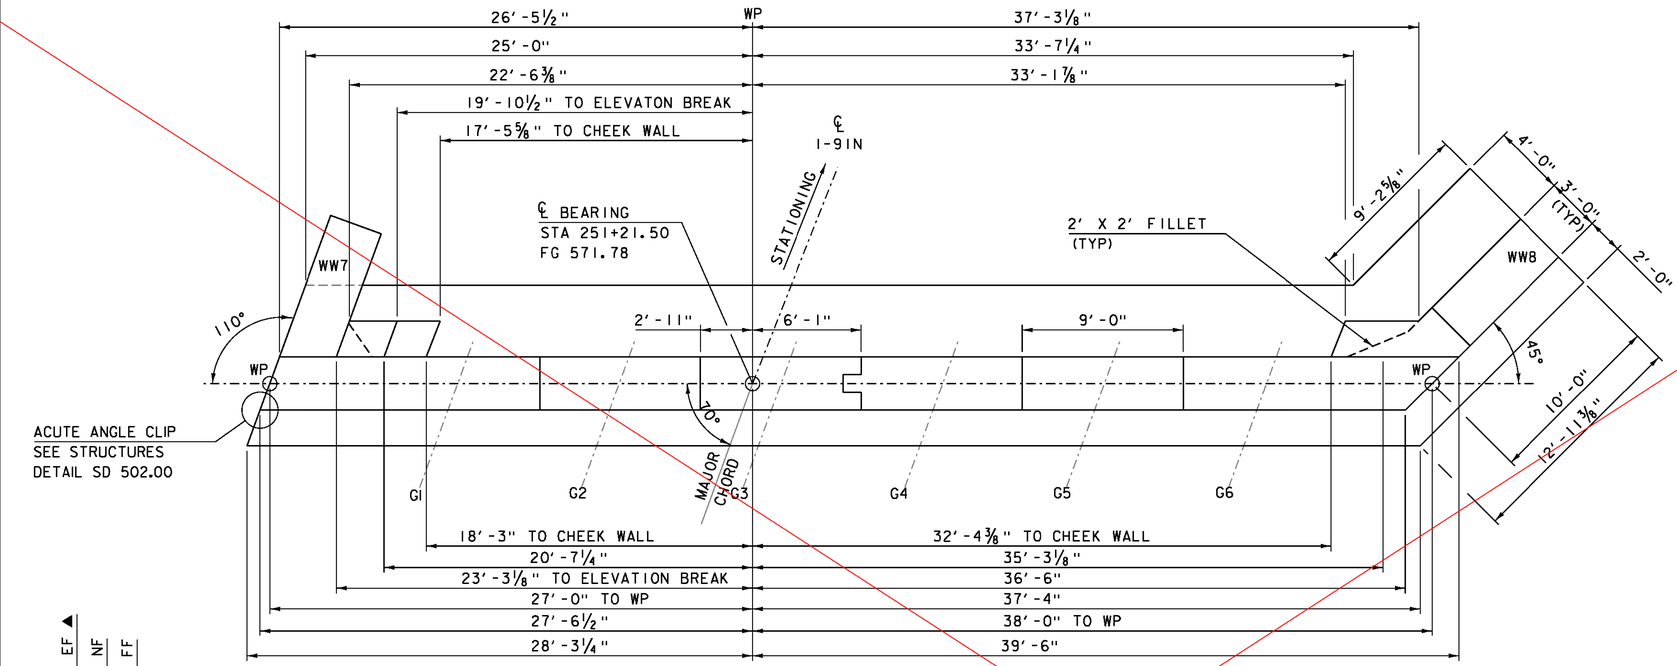

ABUTMENT 4 PLAN

SCALE: ¼" = 1'-0"

BRIDGE SEAT ELEVATIONS

GIRDER	ELEVATION
G1	567.81
G2	567.35
G3	566.88
G4	566.40
G5	565.93
G6	565.47

SLIDE DIRECTION

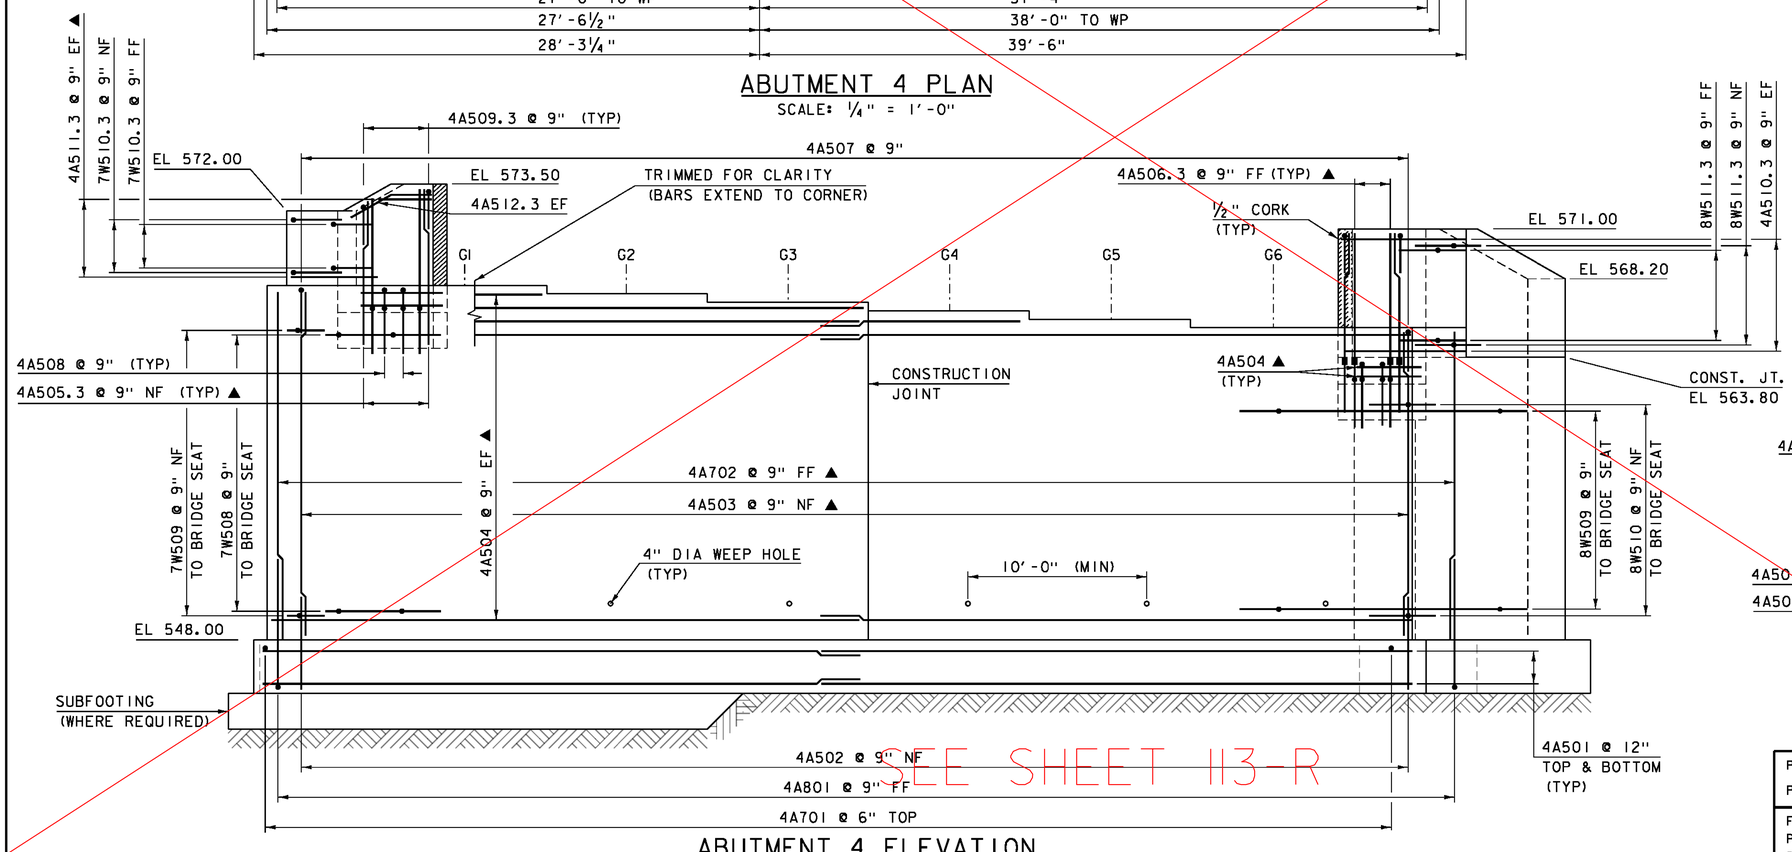

SEE SHEET 113-R

ABUTMENT 4 ELEVATION

SCALE: ¼" = 1'-0"

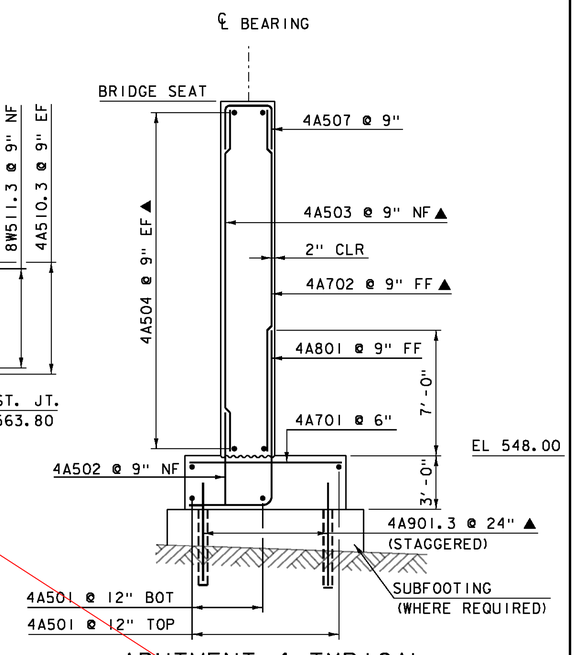

ABUTMENT 4 TYPICAL AT BRIDGE SEAT

SCALE: ¼" = 1'-0"

PROJECT NAME: HARTFORD
PROJECT NUMBER: IM 091-2(79)

FILE NAME: s12a132sub_ab4
PROJECT LEADER: K. HIGGINS
DESIGNED BY: G. LAROCHE
ABUTMENT 4

PLOT DATE: 15-DEC-2014
DRAWN BY: J. SALVATORI
CHECKED BY: G. LAROCHE
SHEET 113 OF 166