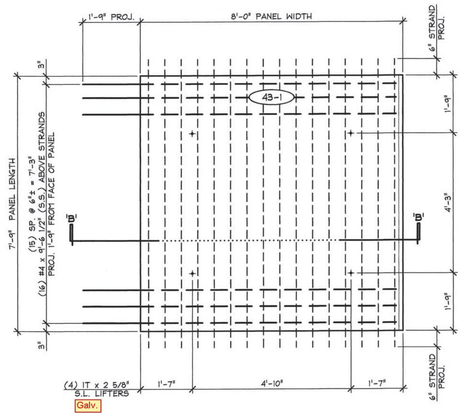

DECK PANEL - '43-1'

1/2" = 1'-0"

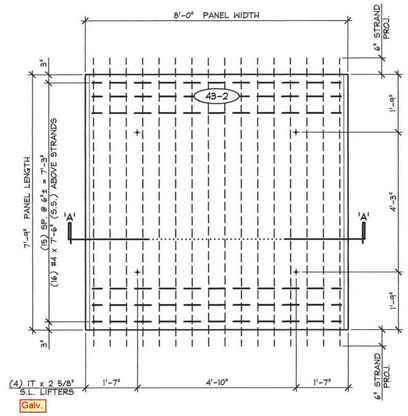

DECK PANEL - '43-2'

1/2" = 1'-0"

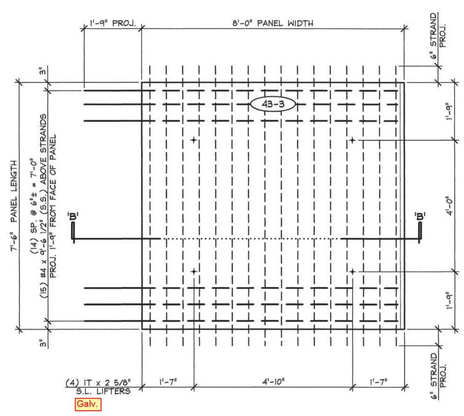

DECK PANEL - '43-3'

1/2" = 1'-0"

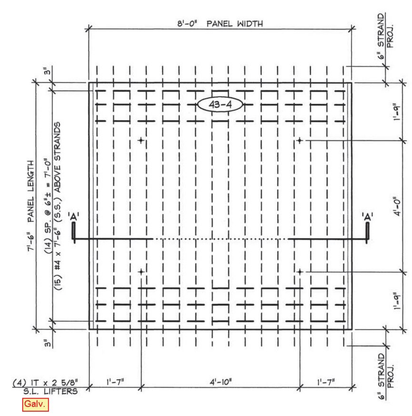

DECK PANEL - '43-4'

1/2" = 1'-0"

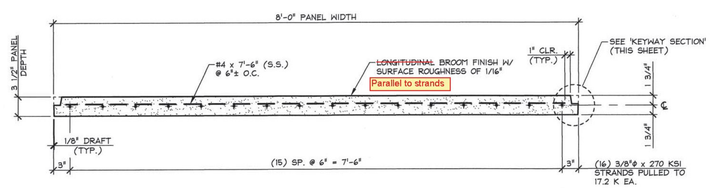

DECK PANEL SECTION - 'A-A'

1" = 1'-0"

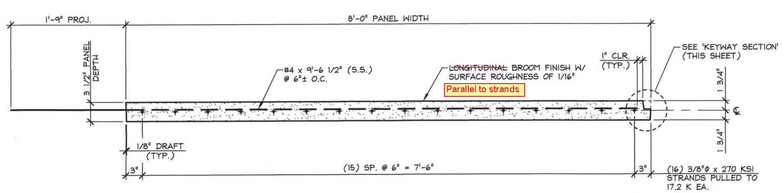

DECK PANEL SECTION - 'B-B'

1" = 1'-0"

① ③ ⑤ ⑦ ⑨ ⑪ ⑬ ⑮ ⑯ ⑭ ⑫ ⑩ ⑧ ⑥ ④ ②

DETENSIONING SCHEDULE

N.T.S.

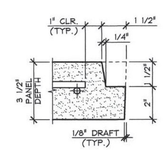

KEYWAY SECTION

3" = 1'-0"

MARK:	43-1	QTY.:	10	WT.:	1.35 T	VOL.:	0.66 cy
MARK:	43-2	QTY.:	65	WT.:	1.34 T	VOL.:	0.66 cy
MARK:	43-3	QTY.:	10	WT.:	1.30 T	VOL.:	0.64 cy
MARK:	43-4	QTY.:	65	WT.:	1.29 T	VOL.:	0.64 cy

MATERIAL LIST / PANEL

ITEM	DESCRIPTION	QTY./PANEL 43-1	43-2	43-3	43-4
1	#4 x 7'-6" (STAINLESS STEEL)		16		15
2	#4 x 9'-6 1/2" (STAINLESS STEEL)	16		15	
3					
4					
5					
6	IT x 2 5/8" SWIFT LIFT LIFTER (GALV.)	4	4	4	4
7					
8	⚠1 ~~LEVELING JACK EMBED INSERTS~~				
9					
10					
11					

⚠1 1-23-15 OMIT LEVELING JACKS

APPROVAL STAMP:

Vermont Agency of Transportation
RECEIVED
CK'D BY RK OK'D BY WL
January 23, 2015
RESUBMIT NO Approved AsNoted
BY KH DATE 2-18-2015

J.P. CARRARA & SONS INC.
Precast & Prestress Manufacturer
2464 CASE STR., MIDDLEBURY, VERMONT 05753 Phone:(802)388-6361 Fax:(802)388-9010

PCL CONSTRUCTION
CONTRACTOR
TAMPA, FLORIDA

STATE OF VERMONT AGENCY OF TRANSPORTATION
COUNTY OF WINDSOR

TOWN OF HARTFORD
INTERSTATE 91 EXIT 11
BRIDGE NO.: 43 N/S PROJECT NO.: IM 091-2(79)

PRESTRESSED S.I.P. FORM PANEL DETAILS

DATE: JAN. 20, 2015
SCALE: NOTED
CHKD: - DFTM: B.L.
JOB NO: 23455-015
DWG. NO: P1

F:\VT-Bridges\23455-15 Hartford\23455-P1.dwg, 1/22/2015 5:44:49 PM