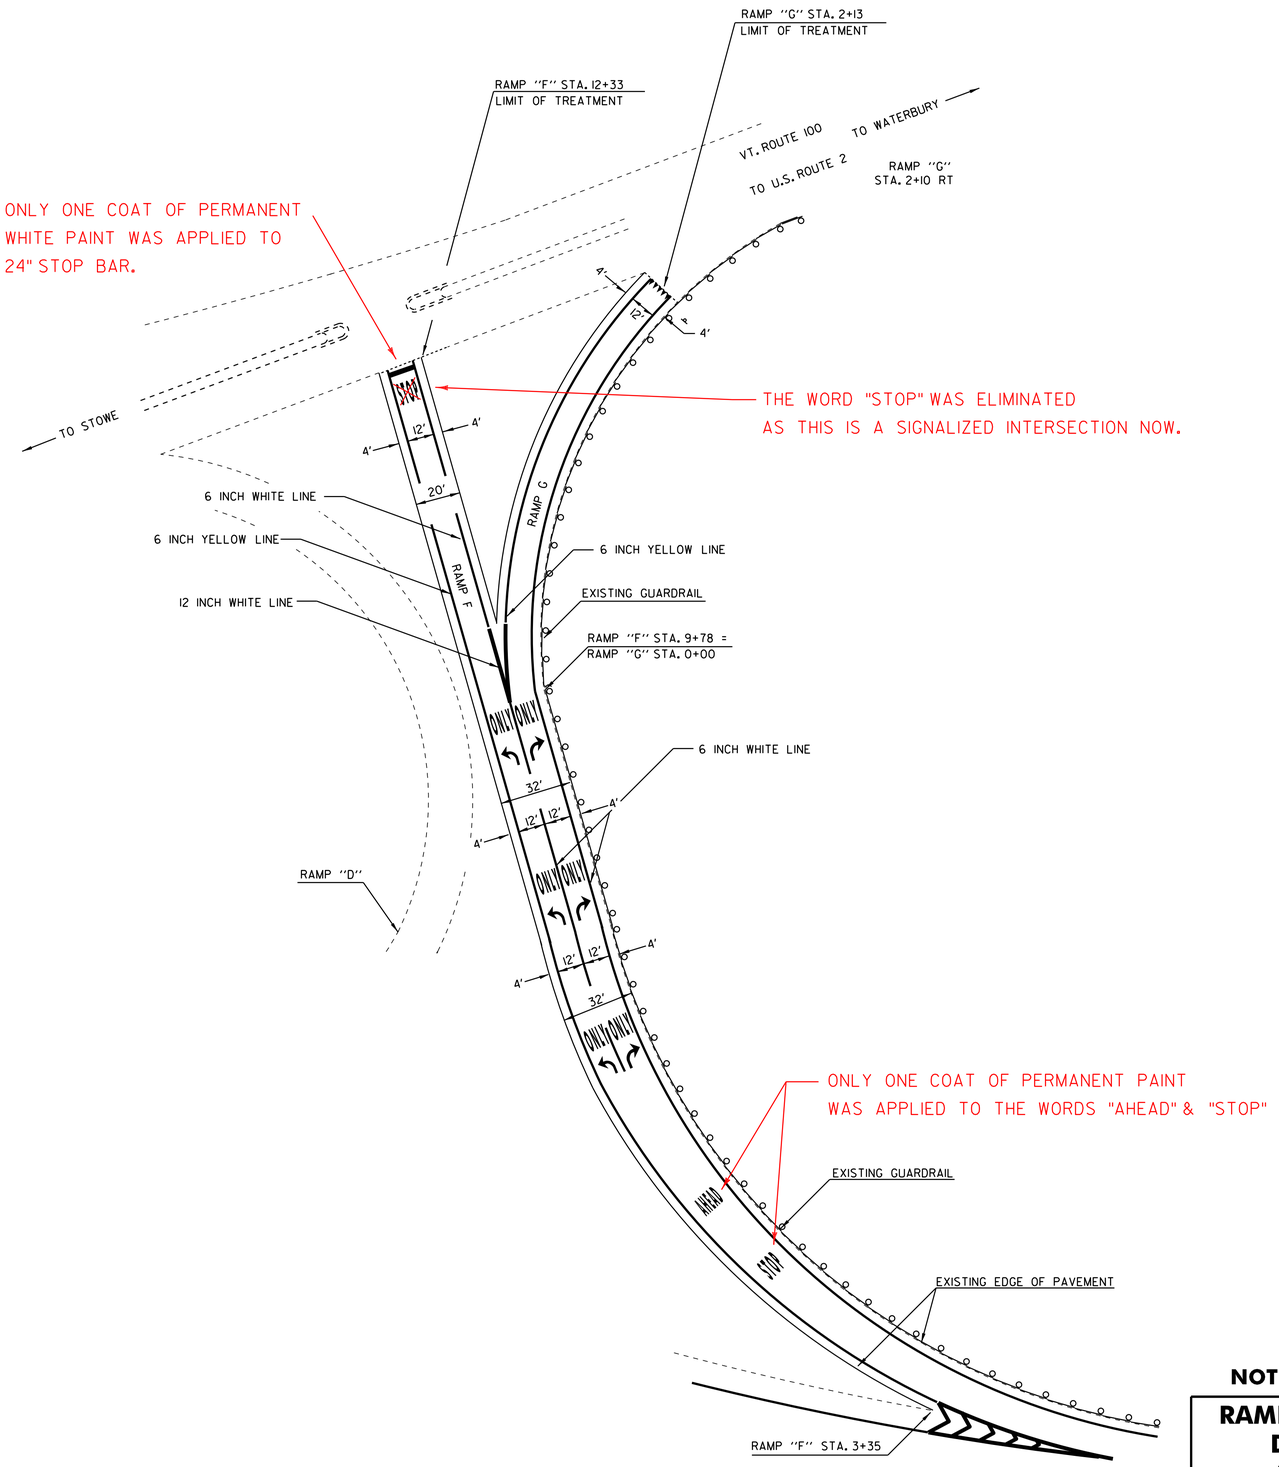

NOT TO SCALE

RAMPS F & G DETAIL SHEET INTERCHANGE #10 (SB)

PROJECT NAME: WATERBURY-RICHMOND
PROJECT NUMBER: IM SURF (33)

FILE NAME: ...12IAI78\...12AI78.dgn
PROJECT LEADER: FOWLER
DESIGNED BY: PVT. MGT.
IPARM FILE NAME: 12AI78_II.i

PLOT DATE: 10-APR-2014 14:16
DRAWN BY: PVT. MGT.
CHECKED BY: PAVT MGMT
SHEET 11 OF 19