
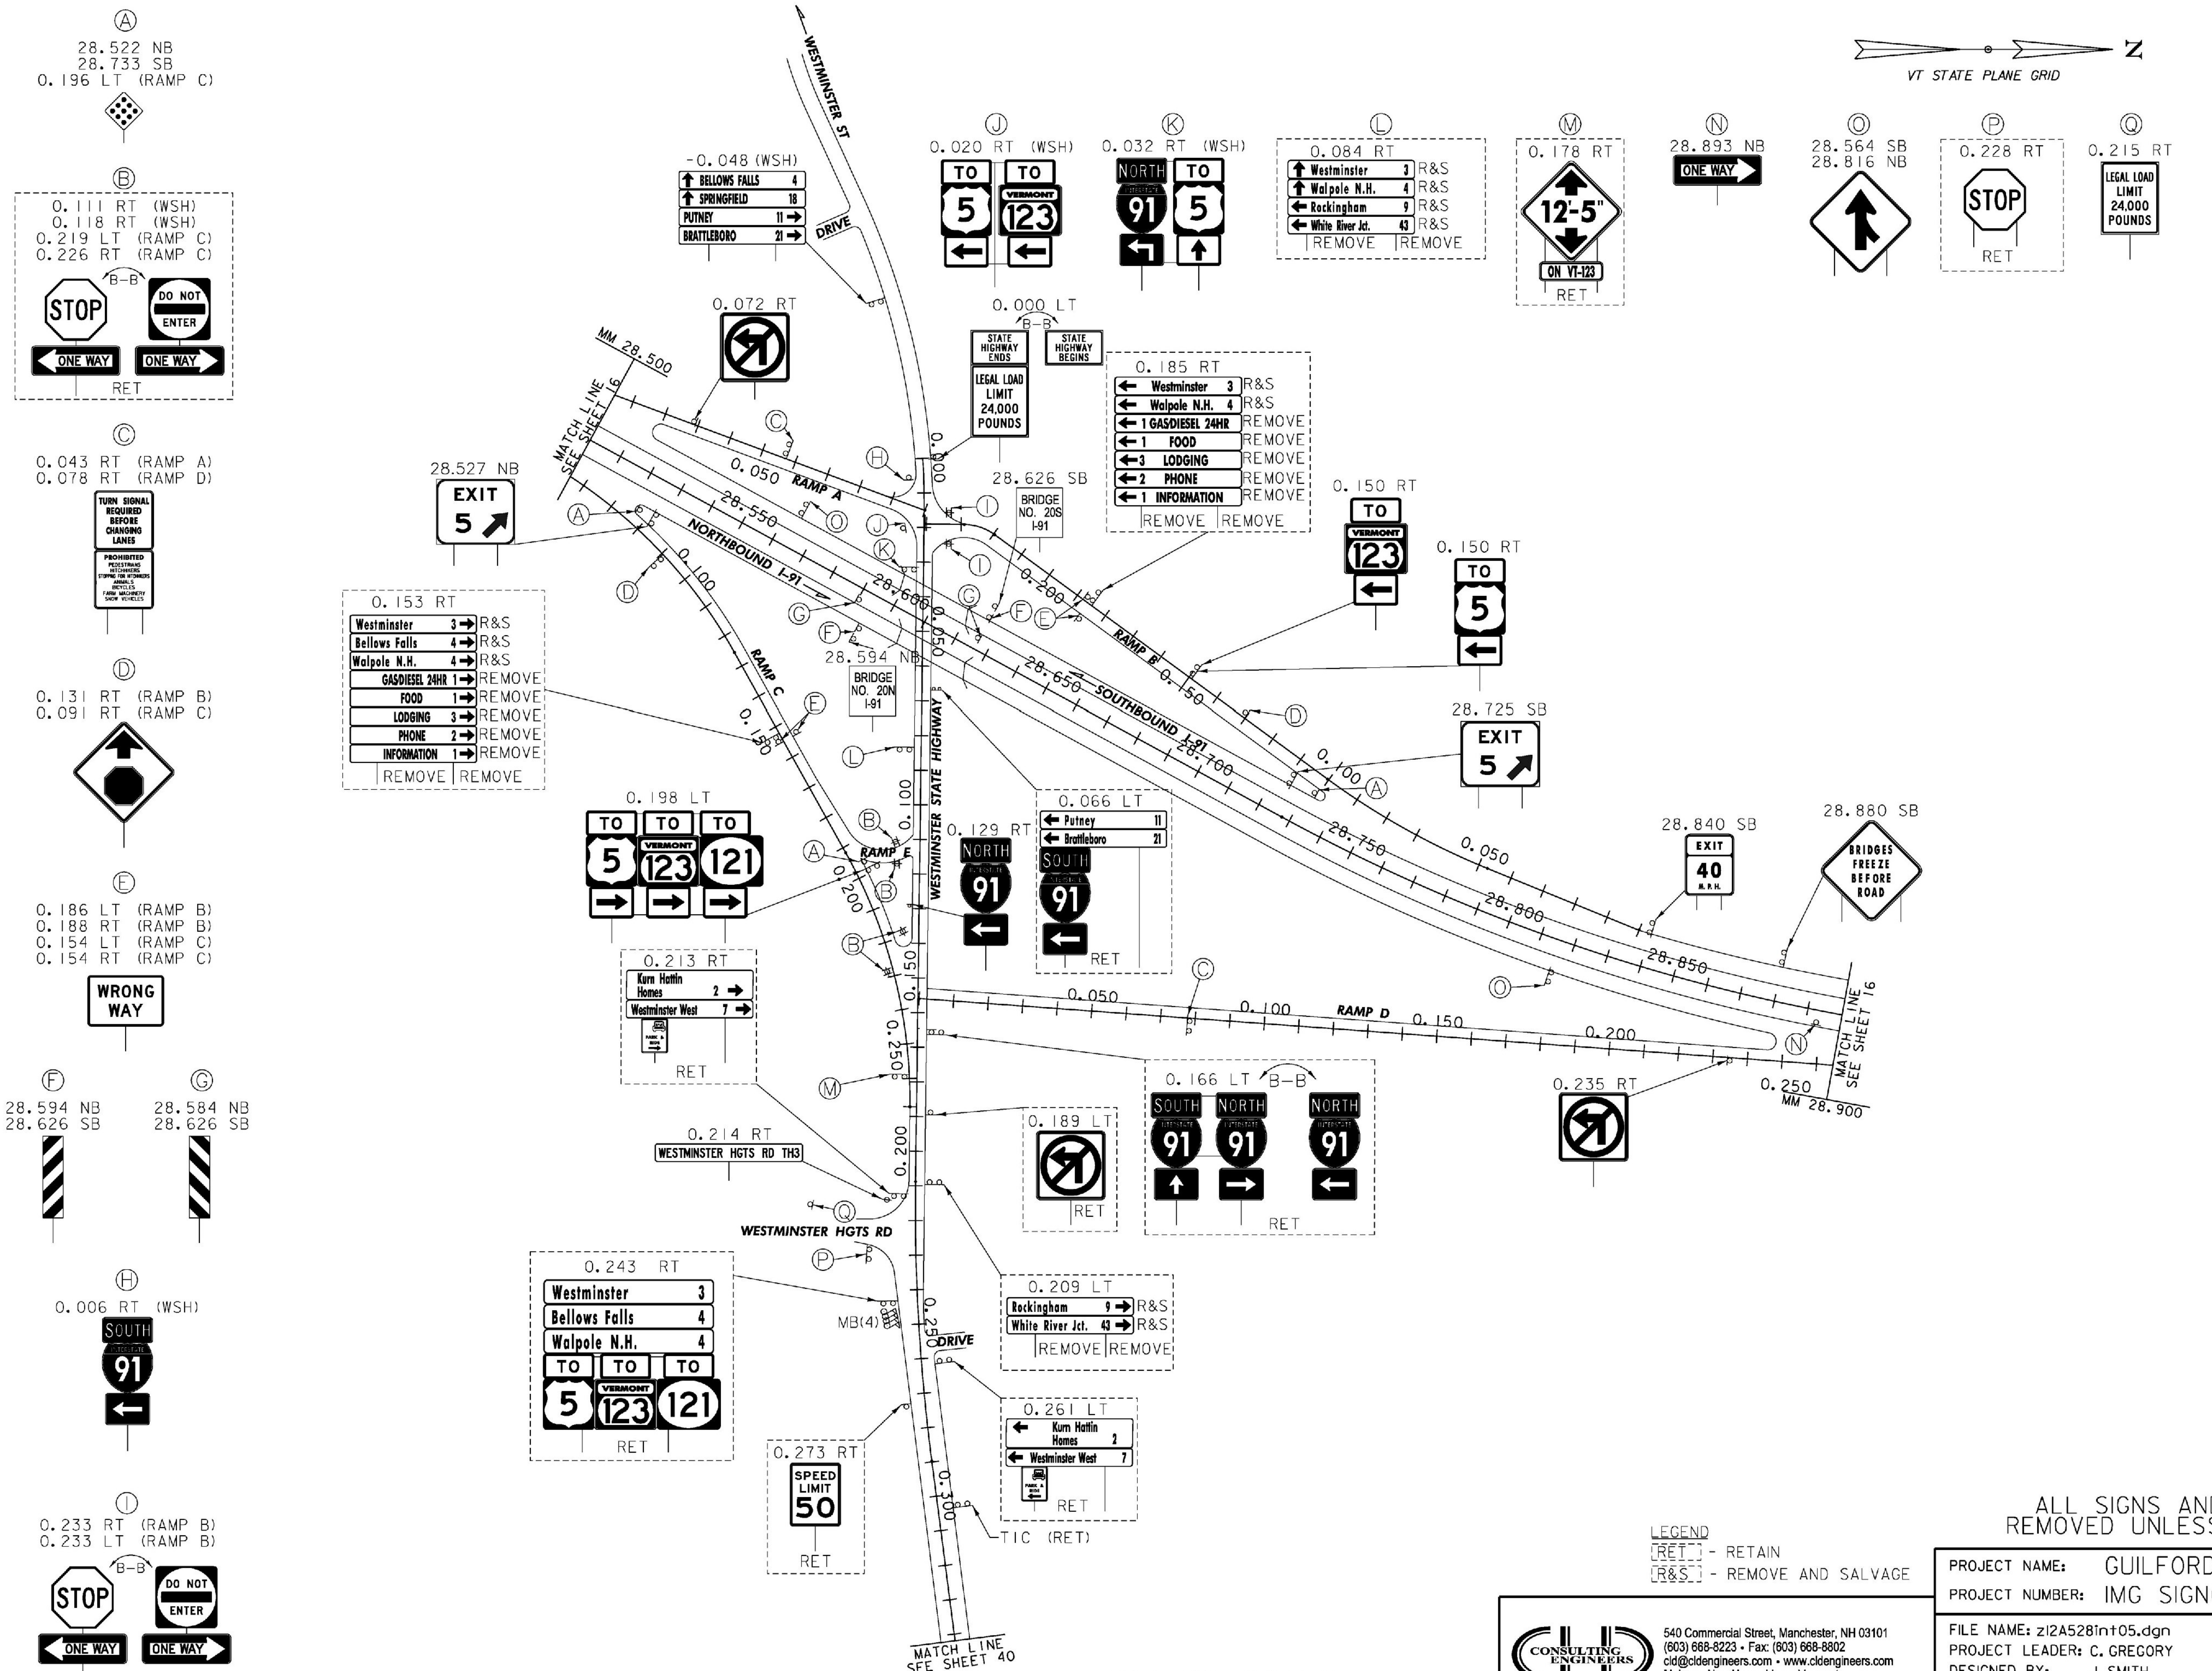


REMOVING SIGNS  
 TYPE A: 109  
 TYPE B: 2  
 BRIDGE PLAQUE: 2

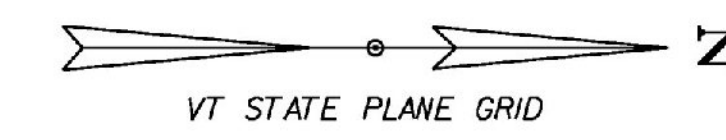

- (A) 28.522 NB  
28.733 SB  
0.196 LT (RAMP C)
- (B) 0.111 RT (WSH)  
0.118 RT (WSH)  
0.219 LT (RAMP C)  
0.226 RT (RAMP C)
- (C) 0.043 RT (RAMP A)  
0.078 RT (RAMP D)
- (D) 0.131 RT (RAMP B)  
0.091 RT (RAMP C)
- (E) 0.186 LT (RAMP B)  
0.188 RT (RAMP B)  
0.154 LT (RAMP C)  
0.154 RT (RAMP C)
- (F) 28.594 NB  
28.626 SB
- (G) 28.584 NB  
28.626 SB
- (H) 0.006 RT (WSH)
- (I) 0.233 RT (RAMP B)  
0.233 LT (RAMP B)

0.153 RT	Westminster	3	R&S
	Bellows Falls	4	R&S
	Walpole N.H.	4	R&S
	GASDIESEL 24HR	1	REMOVE
	FOOD	1	REMOVE
	LODGING	3	REMOVE
	PHONE	2	REMOVE
	INFORMATION	1	REMOVE

0.198 LT	TO	TO	TO
	5	123	121
	VERMONT	VERMONT	VERMONT

0.213 RT	Kurn Hatin Homes	2	RET
	Westminister West	7	RET

0.243 RT	Westminster	3	RET
	Bellows Falls	4	RET
	Walpole N.H.	4	RET
	TO	TO	TO
	5	123	121
	VERMONT	VERMONT	VERMONT

0.273 RT	SPEED LIMIT	50	RET
----------	-------------	----	-----

0.020 RT (WSH)	TO	TO
	5	123
	←	←

0.185 RT	Westminster	3	R&S
	Walpole N.H.	4	R&S
	1 GASDIESEL 24HR	1	REMOVE
	1 FOOD	1	REMOVE
	3 LODGING	3	REMOVE
	2 PHONE	2	REMOVE
	1 INFORMATION	1	REMOVE

	SOUTH	91	RET

0.166 LT (B-B)	SOUTH	91	RET
	NORTH	91	RET
	NORTH	91	RET

0.209 LT	Rockingham	9	R&S
	White River Jct.	43	R&S

0.261 LT	Kurn Hatin Homes	2	RET
	Westminister West	7	RET

LEGEND  
 [RET] - RETAIN  
 [R&S] - REMOVE AND SALVAGE

**CLD**  
 CONSULTING ENGINEERS  
 540 Commercial Street, Manchester, NH 03101  
 (603) 668-8223 • Fax: (603) 668-8802  
 cid@cidengineers.com • www.cidengineers.com  
 Maine • New Hampshire • Vermont

ALL SIGNS AND POSTS WILL BE REMOVED UNLESS OTHERWISE NOTED

PROJECT NAME: GUILFORD-ROCKINGHAM  
 PROJECT NUMBER: IMG SIGN(44)

FILE NAME: z12A528in105.dgn  
 PROJECT LEADER: C. GREGORY  
 DESIGNED BY: J. SMITH  
 INTERCHANGE 5 EXISTING SIGNS (I)

PLOT DATE: 4/17/2014  
 DRAWN BY: S. FORTIER  
 CHECKED BY: D. MUNRO  
 SHEET 38 OF 157

NOT TO SCALE

CLD 12-0350 MODEL: Existing01