STATE OF VERMONT
AGENCY OF TRANSPORTATION

TRAFFIC SIGN SUMMARY SHEET 8

SHSM = FHWA 2004 STANDARD HIIGHWAY SIGNS AND MARKINGS BOOK AND THE 2012 SUPPLEMENT TO THE 2004 EDITION

MILE MARKER, DIRECTION	SIGN LEGEND	SIGN DIMENSIONS EA.	SIGN DIMENSIONS WIDTH (in)	SIGN DIMENSIONS HEIGHT (in)	NEW & SALVAGED SIGNS "A"	NEW & SALVAGED SIGNS "B"	SALV SIGN	SALV TIS	EXIST POST RETAIN	EXIST POST SALVAGE	NO. OF POSTS	FLANGED CHANNEL lb/ft 1.12	FLANGED CHANNEL lb/ft 2.0	FLANGED CHANNEL lb/ft 3.0	SQUARE STEEL (in) 1.75 lb/ft 1.88	SQUARE STEEL (in) 2.0 lb/ft 2.42	SQUARE STEEL (in) 2.5 lb/ft 3.35	ANCHOR	SLEEVE	TUBULAR ALUMINUM DIA (in) 3.0 lb/ft 1.3	TUBULAR ALUMINUM DIA (in) 4.0 lb/ft 1.7	TUBULAR ALUMINUM DIA (in) 4.0Mod lb/ft 1.7	FND-ATION	TUBULAR STEEL DIA (in) 3.0 lb/ft 7.6	TUBULAR STEEL DIA (in) 3.5 lb/ft 9.0	TUBULAR STEEL DIA (in) 4.0 lb/ft 10.8	TUBULAR STEEL DIA (in) 5.0 lb/ft 14.6	W-SHAPE STEEL FTG. SIZE 24"	W-SHAPE STEEL FTG. SIZE 30"	W-SHAPE STEEL WEIGHT	W-SHAPE STEEL POST SIZE	SIGN FRAME	REMARKS	SIGN DETAIL SHSM	SIGN DETAIL DETAIL ON SHEET NUMBER	SIGN DETAIL STD. SHEET NUMBER
11.200 NB MED		1	36	36	9.00						2					X		2																R3-4		
11.275 NB	EXIT 30 MPH	1	48	60	20.00						2												2	206.8										W13-2		
11.459 NB	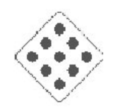	1	18	18	2.25						1				X			1																OM1-1		
11.464 NB	EXIT 3	1	78	60		32.50					2												2	182.4										E5-1a		
11.590 NB		1	48	48	16.00						2												2	205.2										W4-1R		
11.648 NB MED	ONE WAY	1	54	18	6.75						2					X		2																R6-1R		
11.897 NB MED		1	36	36	9.00						2					X		2																R3-4		
11.949 NB	EMERGENCY STOPPING ONLY	1	48	36	12.00						2												2	190.0										R8-7		
12.025 NB	NORTH	1	36 ~~30~~	18 ~~21~~	4.50 ~~4.38~~																												(INTERSTATE) WHITE ON BLUE	M3-1		
	INTERSTATE 91	1	36	36	9.00																													M1-1		
	EISENHOWER INTERSTATE SYSTEM	1	36	36	9.00						1												1		144.0									M1-10		
12.120 NB	SPEED LIMIT 65	1	48	60	20.00																													R2-1		
	MINIMUM 40	1	48	48	16.00						2												2		315.0											E-142
12.368 NB	Putney 6 White River Jct 59	1	150	36		37.50					2												2		292.5										139	
12.600 NB	KEEP RIGHT EXCEPT TO PASS	1	48	60	20.00						2												2	220.4											146	
												FT	FT	FT	FT 9.5	FT 95.2	FT		EA.	LB	LB	LB		LB 1004.8	LB 751.5	LB	LB									
	SUBTOTALS SHEET 8				SF 153.38	SF 70.00	EA.	SF				FT			FT 104.7					LB			EA. 15	LB 1756.3				EA.	EA.	LB						

FINAL POST LENGTHS ARE TO BE DETERMINED IN THE FIELD. POST SIZES ARE COMPUTED BASED ON INFORMATION FURNISHED ON THE STANDARD SHEETS AND THE VTRANS "SIGN POST DESIGN GUIDELINE".

PROJECT NAME: **GUILFORD-ROCKINGHAM**
PROJECT NUMBER: **IMG SIGN(44)**

FILE NAME:	**z12A528tssml.xlsb**	PLOT DATE:	**4/16/2014**
PROJECT LEADER:	**C. GREGORY**	DRAWN BY:	**J. SMITH**
DESIGNED BY:	**J. SMITH**	CHECKED BY:	**D. MUNRO**
TRAFFIC SIGN SUMMARY SHEET 8		SHEET **65**	OF **157**