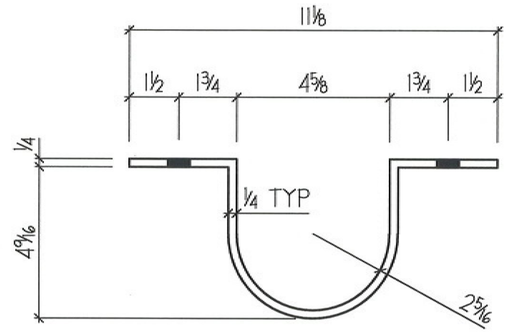

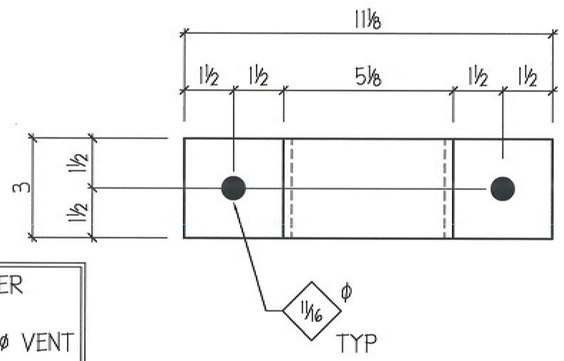

HOT DIP GALV. PER
A.S.T.M. A123
SHOP PROVIDE 9/16ϕ VENT
HLS. AS REQ'D.

4 ~ BRACKETS ~ 6M1

REF: H1

BRIDGE 41 NORTH

Vermont Agency of Transportation
RECEIVED
signed STA Steel Repair Drawings Bridge 42 N 1 rev.pdf

CK'D BY Mark SargentS OK'D BY Mark Sargent

April 17, 2017

RESUBMIT No **Approved AsNoted**
BY Mark Sargent DATE 06/14/2017

SUBMITTAL REVIEW

Review is only for general conformity to the contract drawings and specifications and shall not relieve the contractor of his entire responsibility under the contract, including among other things, dimensions to be confirmed and correlated at the job site, and information that pertains to the fabrication processes or to techniques of construction.

- [x] NO EXCEPTIONS TAKEN
- [ ] MAKE CORRECTIONS NOTED RESUBMITTAL NOT REQUIRED
- [ ] AMEND AND RESUBMIT
- [ ] REJECTED - SEE REMARKS

PARSONS BRINCKERHOFF, INC.
BY: Stephen X. Bragnolo
DATE: 5/17/17

NO.	DATE	REVISION
2	4/19/17	Per App'l
1	3/3/17	Per Check'g

SURFACE PREP: SSPC-SP2 FINISH: GALV PRIMER: N/A DFT: 1.0

SHIP QTY	ASSEMBLY QTY	SECTION	FT	INCH	ASSEMBLY MARK	SHIP MARK	REMARKS	WEIGHT
4		BAR ¼x3	1	5¼±		6M1	BENT BAR	
8		STA ½ϕ	0	4¼		6FB1	STUD ANCHORS 2	

HOLES: 13/16ϕ UNO
SHOP BOLTS: A325-TC
MATL: W's - A992-50; HSS - A500 Grd B; Pipe - A53 Grd B; Bars & ℙ & L - A36
ELECTRODES: E70XX/E71-T
E DWG REF: E1
ENGR DWG REF: H1
SEQ / DIV:
GRID LOCATION:
TOS ELEVATION:
NOTES:

Saw: INITIAL DATE | Drill: INITIAL DATE | Fitter: INITIAL DATE | QC1: INITIAL DATE
Weld: INITIAL DATE | Prep: INITIAL DATE | Paint: INITIAL DATE | Load: INITIAL DATE

RELIANCE STEEL
94 SOUTH OAK CIRCLE, COLCHESTER, VT 05446
TEL 802-655-4810 FAX 802-655-9352
www.reliancesteelofvt.com

CUSTOMER Monoko
PROJECT Bridge Downspouts & Components
DETAIL Downspout Bracket

DRAWN/CHECKED	DATE	JOB NO.	DWG NO.	REV
RCL	FEB 2017	7324	06	2