INTERCHANGE #15

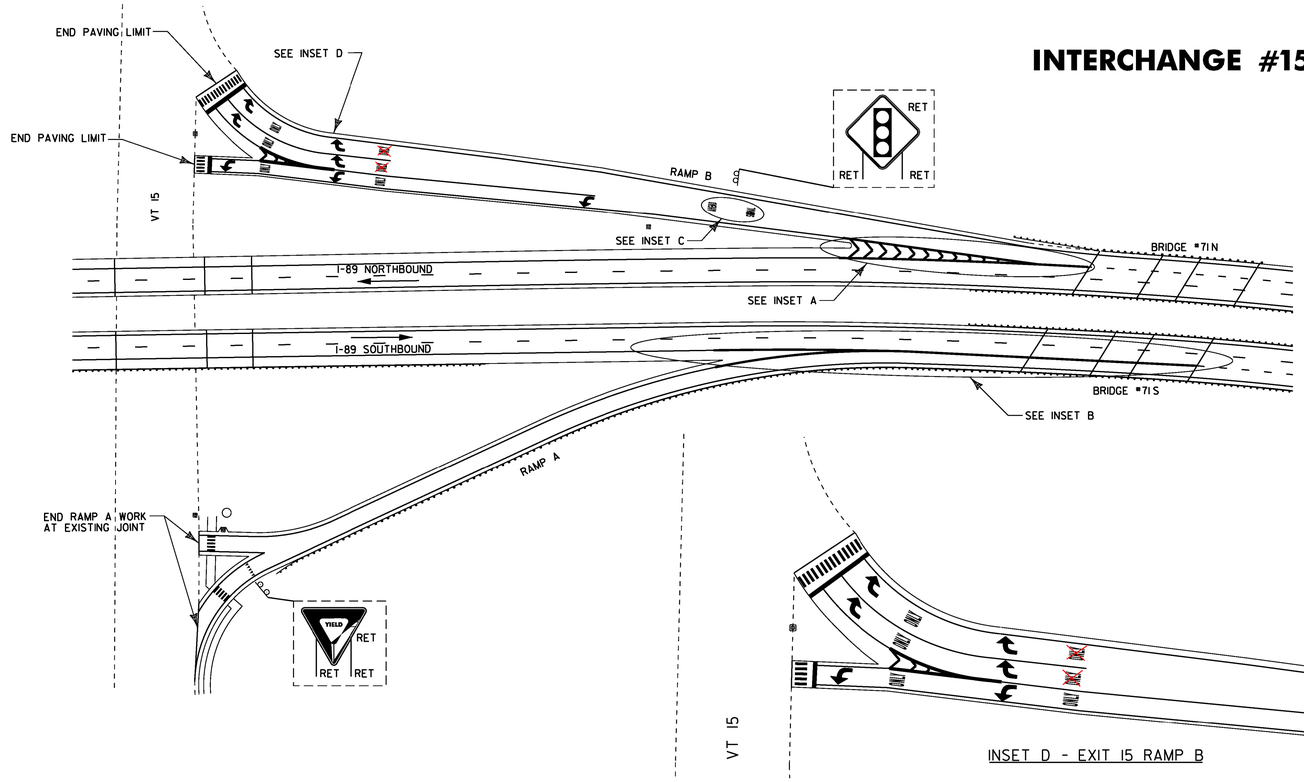

INSET D - EXIT 15 RAMP B

TEMPORARY CROSSWALK MARKING, PAINT
EXIT 15
SOUTHBOUND ON RAMP A
NORTHBOUND OFF RAMP B
NORTHBOUND OFF RAMP B

TEMPORARY 24 INCH STOP BAR, PAINT
EXIT 15
NORTHBOUND OFF RAMP B
NORTHBOUND OFF RAMP B

TEMPORARY 6 INCH WHITE LINE, PAINT
EXIT 15

NORTHBOUND OFF RAMP B	SOLID RT EDGE LINE
INTERSTATE 89	DOTTED RT LANE LINE
NORTHBOUND OFF RAMP B	SOLID LANE LINE
NORTHBOUND OFF RAMP B	SOLID LANE LINE
SOUTHBOUND ON RAMP A	SOLID RT EDGE LINE
INTERSTATE 89	DOTTED LT LANE LINE

TEMPORARY 6 INCH YELLOW LINE, PAINT
EXIT 15

NORTHBOUND OFF RAMP B	SOLID LT EDGE LINE
SOUTHBOUND ON RAMP A	SOLID LT EDGE LINE

TEMPORARY 12 INCH WHITE LINE, PAINT
EXIT 15

NORTHBOUND OFF RAMP B	SOLID LT GORE AREA
INTERSTATE 89	SOLID RT GORE AREA
NORTHBOUND OFF RAMP B	GORE AREA AT VT 15
SOUTHBOUND ON RAMP A	SOLID LT GORE AREA
INTERSTATE 89	SOLID LT GORE AREA

TEMPORARY LETTER OR SYMBOL, PAINT
EXIT 15

NORTHBOUND OFF RAMP B	''SIGNAL''
NORTHBOUND OFF RAMP B	''AHEAD''
NORTHBOUND OFF RAMP B	↰
NORTHBOUND OFF RAMP B	''ONLY'' ''ONLY'' ''ONLY''
NORTHBOUND OFF RAMP B	↰ ↱ ↱
NORTHBOUND OFF RAMP B	''ONLY'' ''ONLY'' ''ONLY''
NORTHBOUND OFF RAMP B	↰ ↱ ↱
NORTHBOUND OFF RAMP B	''ONLY'' ''ONLY'' ''ONLY''
NORTHBOUND OFF RAMP B	↰ ↱ ↱
SOUTHBOUND ON RAMP A	YIELD TRIANGLES (5 EACH)

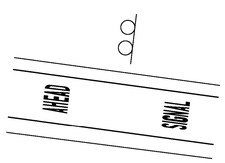

INSET C - EXIT 15 RAMP B

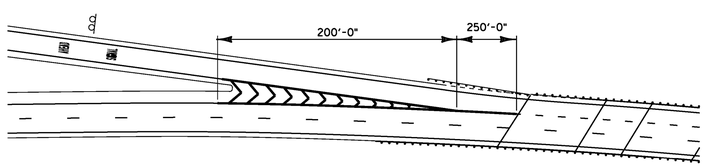

INSET A - GORE DETAIL AT EXIT 15 RAMP B

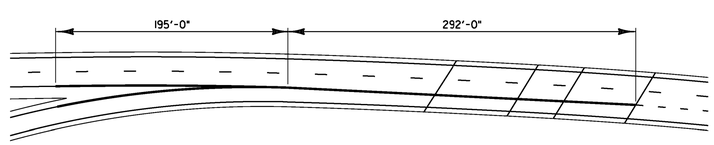

INSET B - GORE DETAIL AT EXIT 15 RAMP A

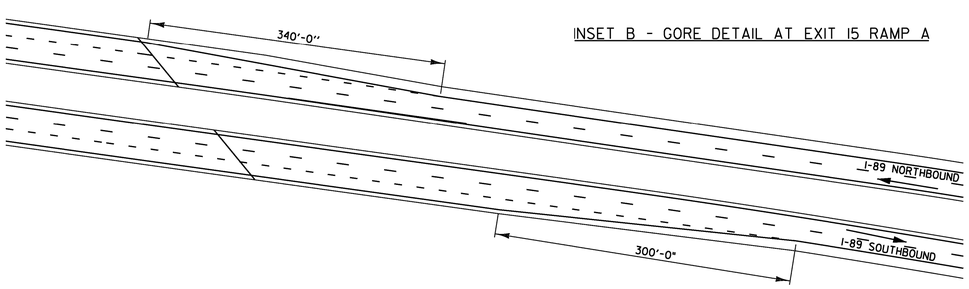

ACCEL/DECEL LANE DETAIL, EXIT 15

DURABLE 6 INCH WHITE LINE, POLYUREA
EXIT 15

NORTHBOUND OFF RAMP B	SOLID RT EDGE LINE
INTERSTATE 89	DOTTED RT LANE LINE
NORTHBOUND OFF RAMP B	SOLID LANE LINE
NORTHBOUND OFF RAMP B	SOLID LANE LINE
SOUTHBOUND ON RAMP A	SOLID RT EDGE LINE
INTERSTATE 89	DOTTED LT LANE LINE

DURABLE 6 INCH YELLOW LINE, POLYUREA
EXIT 15

NORTHBOUND OFF RAMP B	SOLID LT EDGE LINE
SOUTHBOUND ON RAMP A	SOLID LT EDGE LINE

DURABLE 12 INCH WHITE LINE, POLYUREA
EXIT 15

NORTHBOUND OFF RAMP B	SOLID LT GORE AREA
INTERSTATE 89	SOLID RT GORE AREA
NORTHBOUND OFF RAMP B	GORE AREA AT VT 15
SOUTHBOUND ON RAMP A	SOLID LT GORE AREA
INTERSTATE 89	SOLID LT GORE AREA

DURABLE LETTER OR SYMBOL, POLYUREA
EXIT 15

NORTHBOUND OFF RAMP B	''SIGNAL''
NORTHBOUND OFF RAMP B	''AHEAD''
NORTHBOUND OFF RAMP B	↰
~~NORTHBOUND OFF RAMP B~~	~~''ONLY'' ''ONLY'' ''ONLY''~~
~~NORTHBOUND OFF RAMP B~~	~~↰ ↱ ↱~~
NORTHBOUND OFF RAMP B	''ONLY'' ~~''ONLY'' ''ONLY''~~
NORTHBOUND OFF RAMP B	↰ ↱ ↱
NORTHBOUND OFF RAMP B	''ONLY'' ''ONLY'' ''ONLY''
NORTHBOUND OFF RAMP B	↰ ↱ ↱
SOUTHBOUND ON RAMP A	YIELD TRIANGLES (5 EACH)
NORTHBOUND OFF RAMP B	→

DURABLE CROSSWALK MARKING, POLYUREA
EXIT 15
SOUTHBOUND ON RAMP A
NORTHBOUND OFF RAMP B
NORTHBOUND OFF RAMP B

DURABLE 24 INCH STOP BAR, POLYUREA
EXIT 15
NORTHBOUND OFF RAMP B
NORTHBOUND OFF RAMP B

NOT TO SCALE

PAVEMENT MARKING DETAIL SHEET 12 EXIT 15

PROJECT NAME:	RICHMOND - COLCHESTER
PROJECT NUMBER:	IM SURF (38)
FILE NAME: pl3al36.dgn	PLOT DATE: 19-DEC-2013
PROJECT LEADER: M. FOWLER	DRAWN BY: LOCKE
DESIGNED BY: LOCKE	CHECKED BY: FOWLER
IPARM FILE NAME: pl3al36pmdl2.i	SHEET 28 OF 41