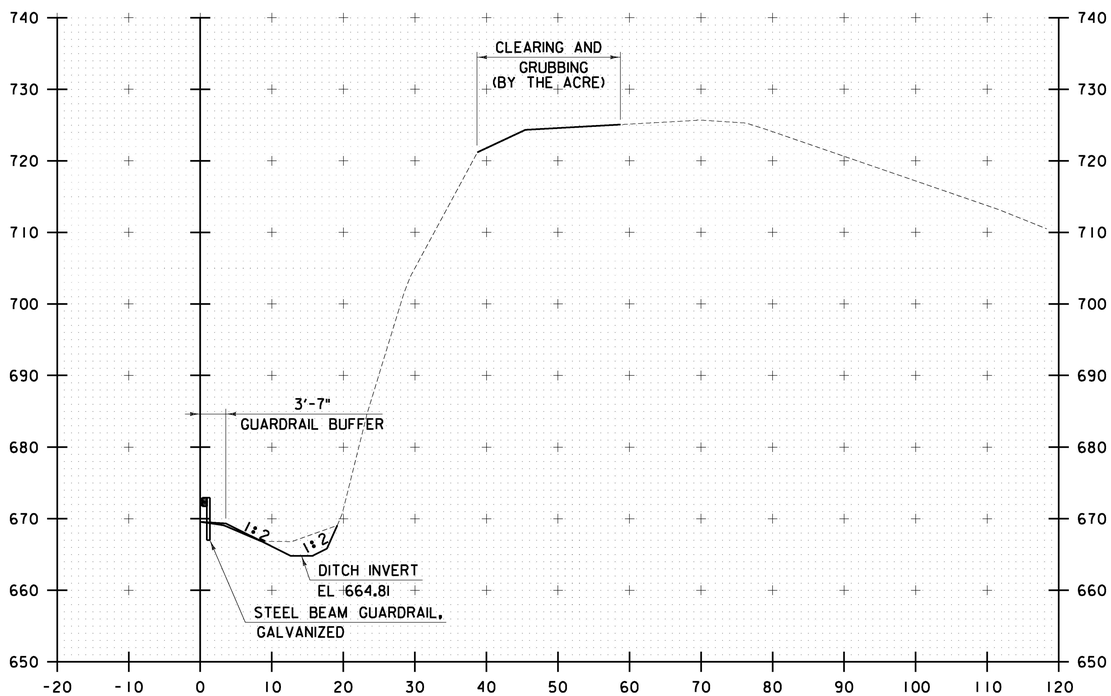

N 6171+00

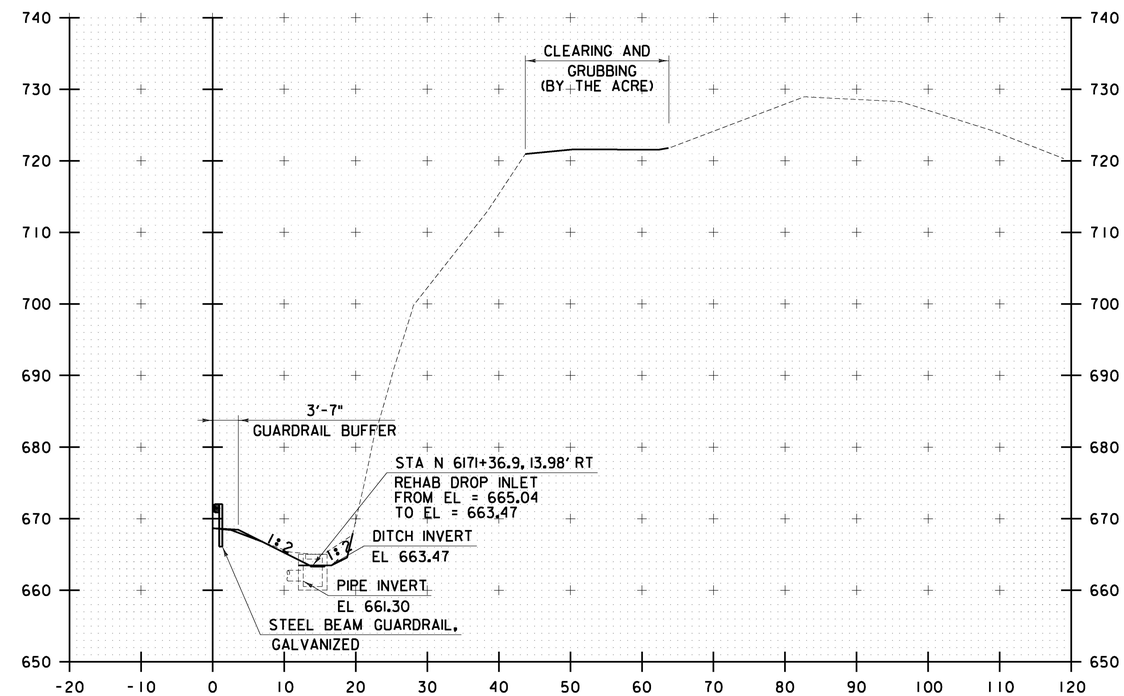

N 6171+36.9

STA. N 6171+00 TO STA. N 6171+36.9

10 0 10
SCALE IN FEET

CHA

PROJECT NAME: RYEGATE	
PROJECT NUMBER: IM 091-2(80)	
FILE NAME: z13a368xsc.dgn	PLOT DATE: 3/30/2017
PROJECT LEADER: D. GOZALKOWSKI	DRAWN BY: J. HEALD
DESIGNED BY: J. OLSEN	CHECKED BY: J. SHIELDS
CROSS SECTION SHEET 2	SHEET 37 OF 61

FILE NAME = V:\Projects\ANY\K4\29741\CADD_MSTN\13a368\Consultants\Highway\z13a368xsc.dgn
DATE/TIME = 3/30/2017
USER = 5323