


S 6175+50

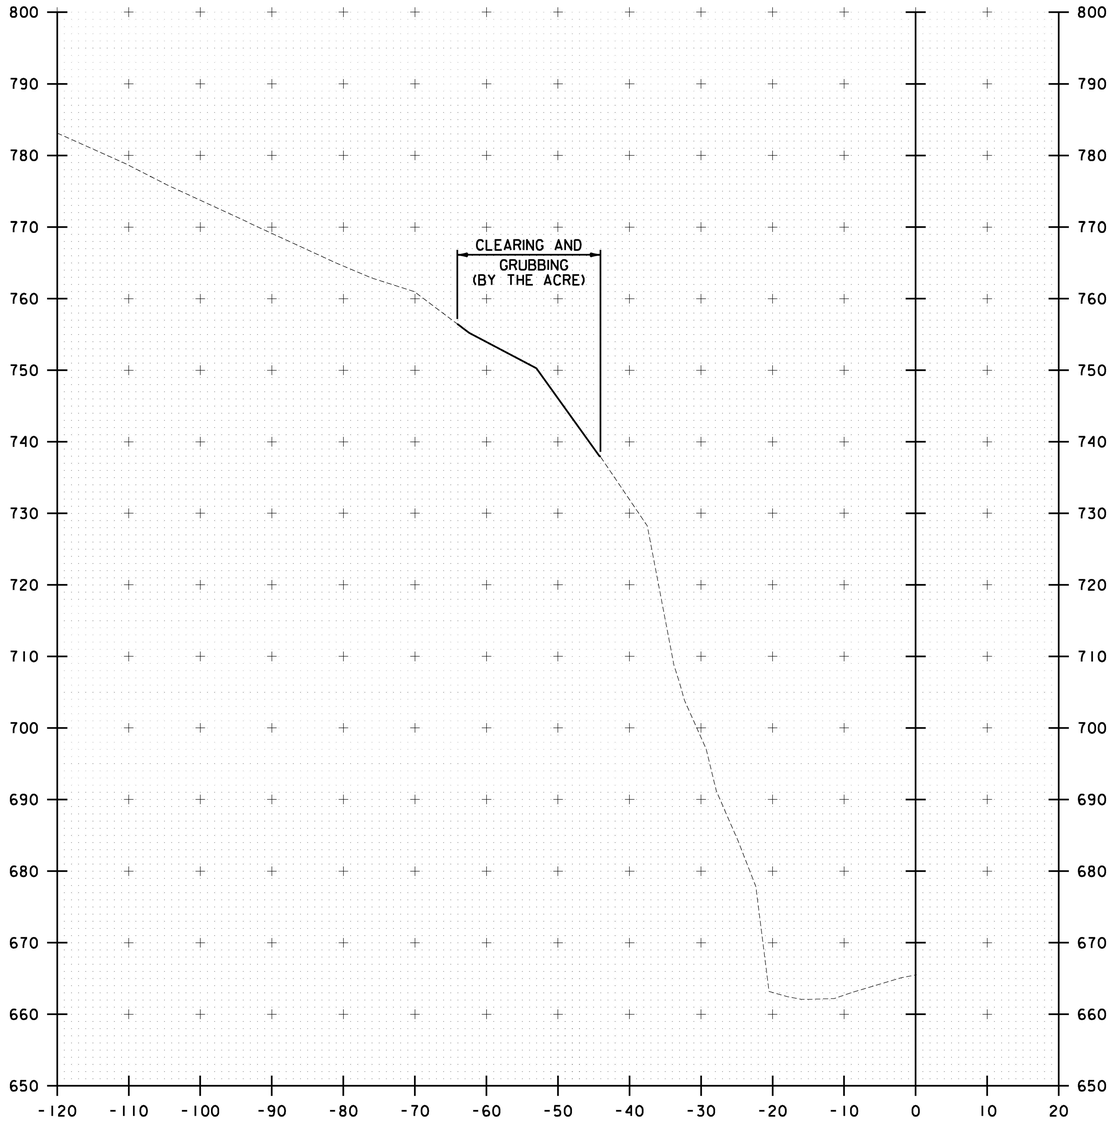


S 6176+00

STA. S 6175+50 TO STA. S 6176+00

10 0 10
SCALE IN FEET

CHA
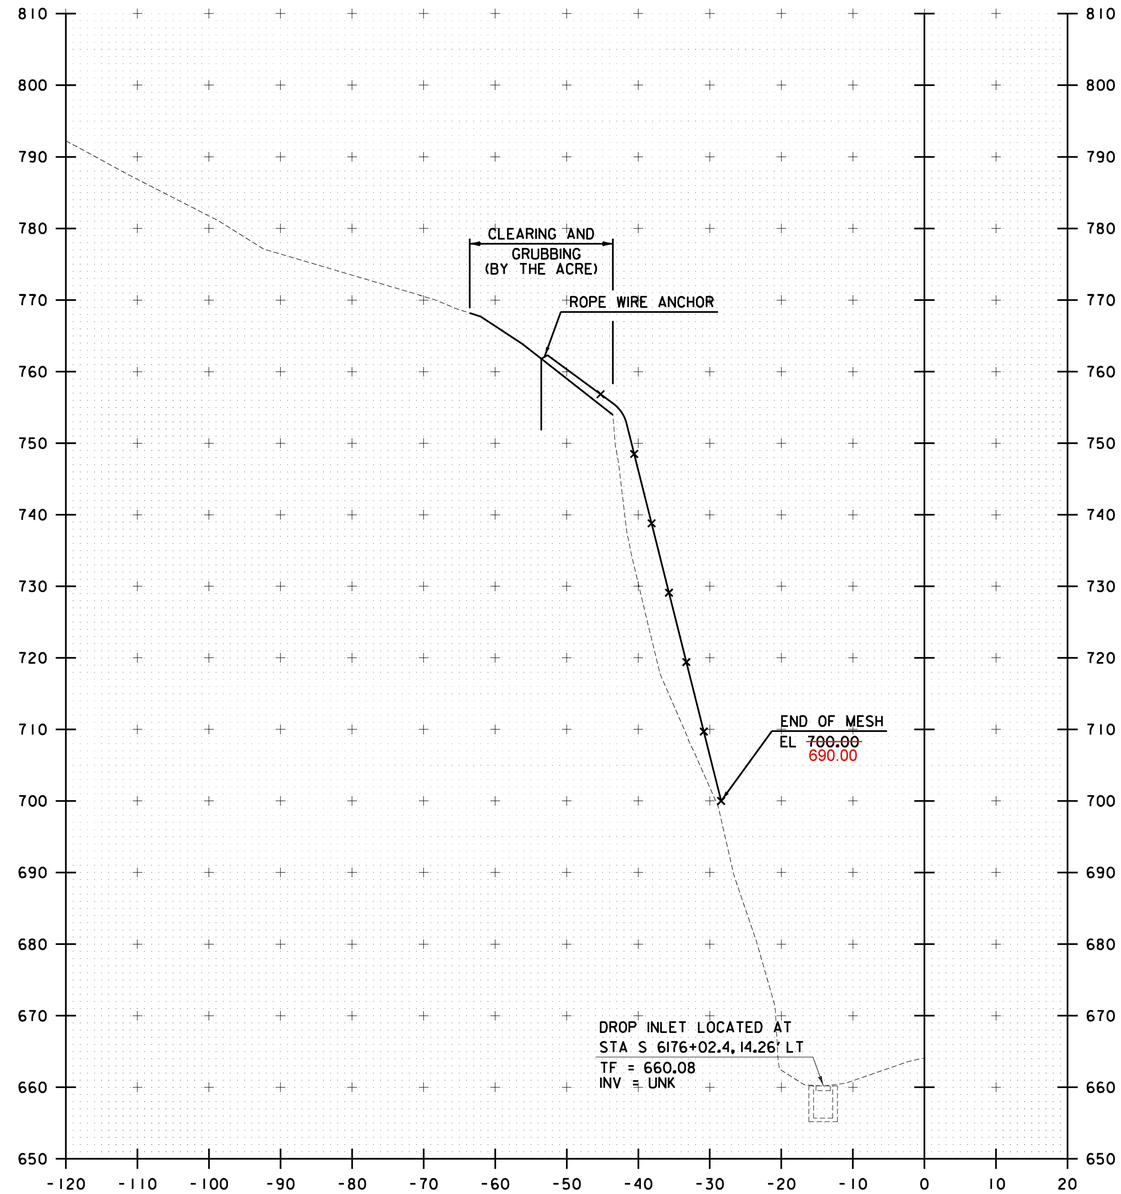
| | |
|---|---|
| PROJECT NAME: RYEGATE | |
| PROJECT NUMBER: IM 091-2(80) | |
| FILE NAME: z13a368xsc.dgn | PLOT DATE: 3/30/2017 |
| PROJECT LEADER: D. GOZALKOWSKI | DRAWN BY: J. HEALD |
| DESIGNED BY: J. OLSEN | CHECKED BY: J. SHIELDS |
| CROSS SECTION SHEET 14 | SHEET 49 OF 61 |

FILE NAME = V:\Projects\ANY\K4\29741\CADD_MSTN\13a368\Consultants\Highway\z13a368xsc.dgn
DATE/TIME = 3/30/2017
USER = 5323