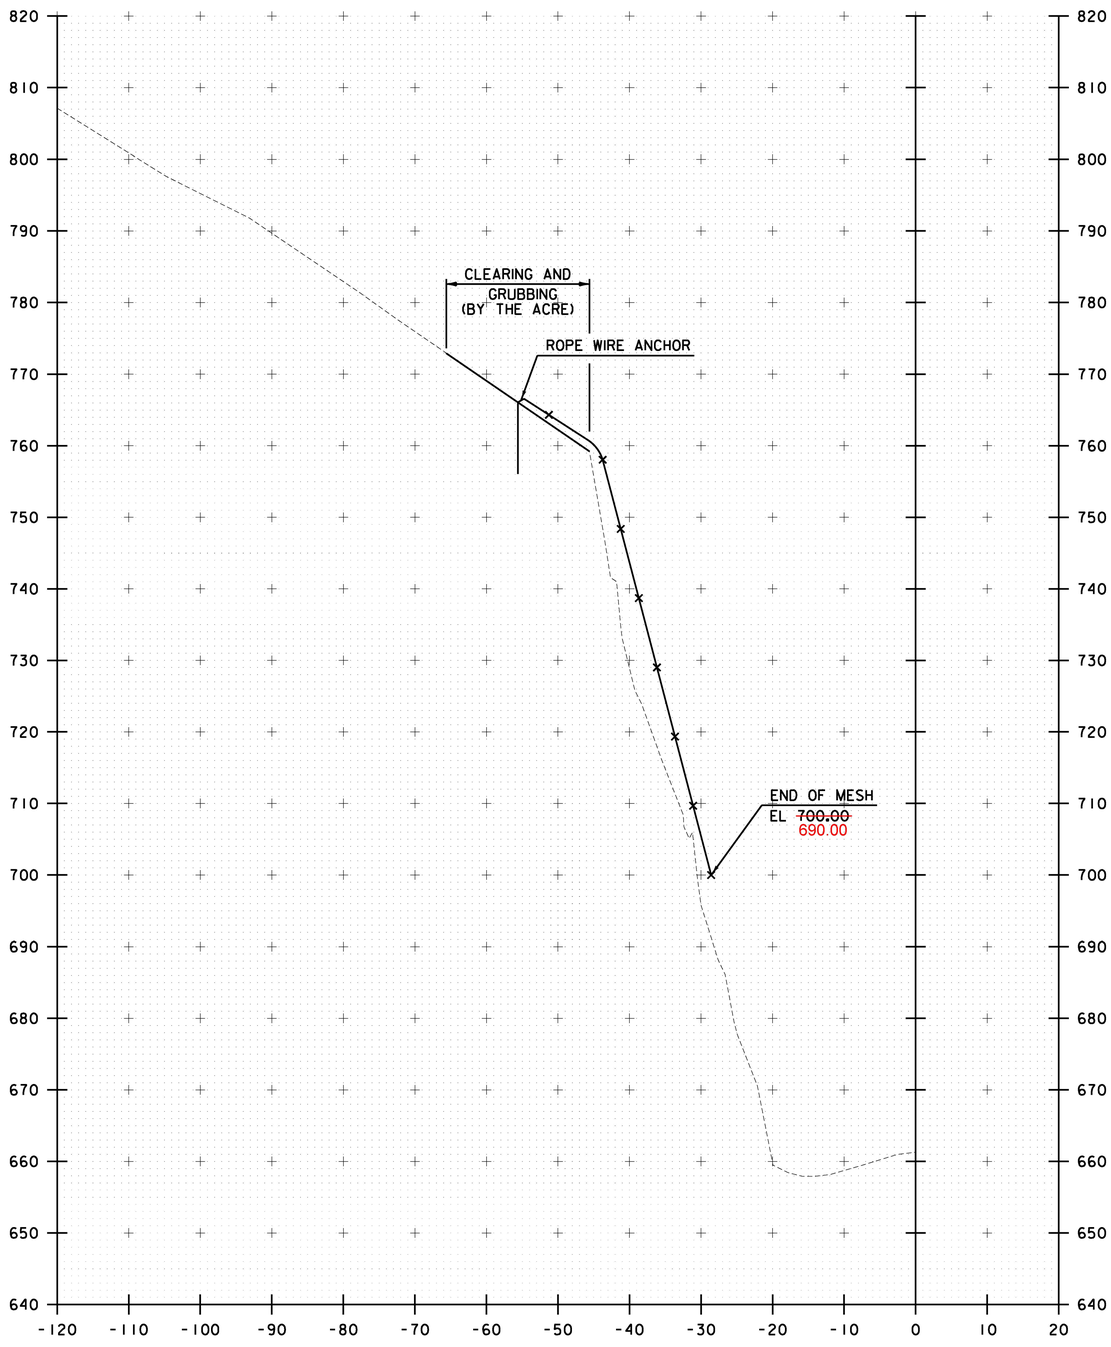

S 6177+00

10 0 10
SCALE IN FEET

STA. S 6177+00

PROJECT NAME: RYEGATE
PROJECT NUMBER: IM 091-2(80)

FILE NAME: zl3a368xsc.dgn
PROJECT LEADER: D. GOZALKOWSKI
DESIGNED BY: J. OLSEN
CROSS SECTION SHEET 16

PLOT DATE: 3/30/2017
DRAWN BY: J. HEALD
CHECKED BY: J. SHIELDS
SHEET 51 OF 61

FILE NAME = V:\Projects\ANY\K4\29741\CADD_MSTN\13a368\Consultants\Highway\zl3a368xsc.dgn
DATE/TIME = 3/30/2017
USER = 5323