EROSION MATTING
ITEM 654.10
70+00 – 73+50 LT.

Stone Fill Type I
69+50 – 70+00 Lt.

Drilling & Blasting of Solid Rock Subgrade
67+00 – 67+25
73+75 – 80+00

Scarifying Existing Pavements
72+00 – 74+00

Construct Drive
71+00 Rt.

Surv M/L CURVE NO. 2
Δ 11° 27' LT
D 3°
R 1909.86'
T 191.47'
L 381.67'
E 69.67'
BANK .038 FT./FT.

Rev Curve No.
Δ 14° 53' 20" Lt
D 3°
R 1909.86
T 249.55
L 496.29
E 16.23

Excavation & Removal of Paint Surfaces and Pavement
68+55 – 72+00

Guard Rail Std Steel Beam w/ Wood Posts (6-3") TYP
76+25 – 79+75 Rt

Breakaway Cable Terminal for G.R. Std St Beam w/ Wood Post
76+00 – 76+25 Rt
79+75 – 80+00 Rt

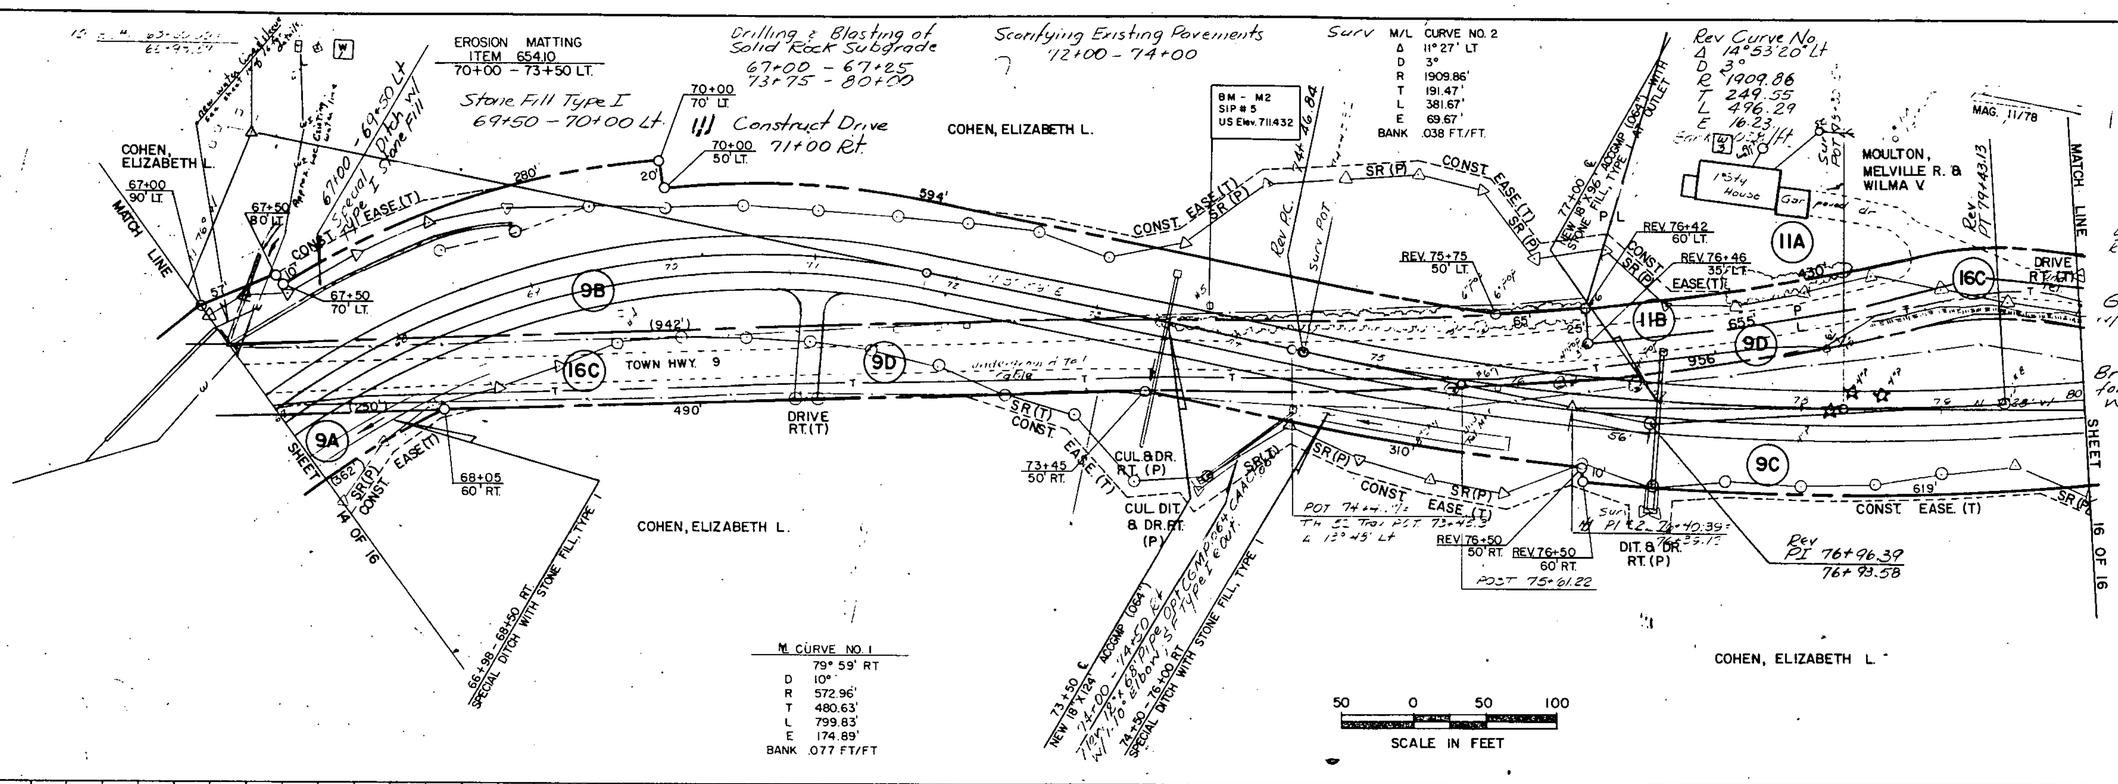

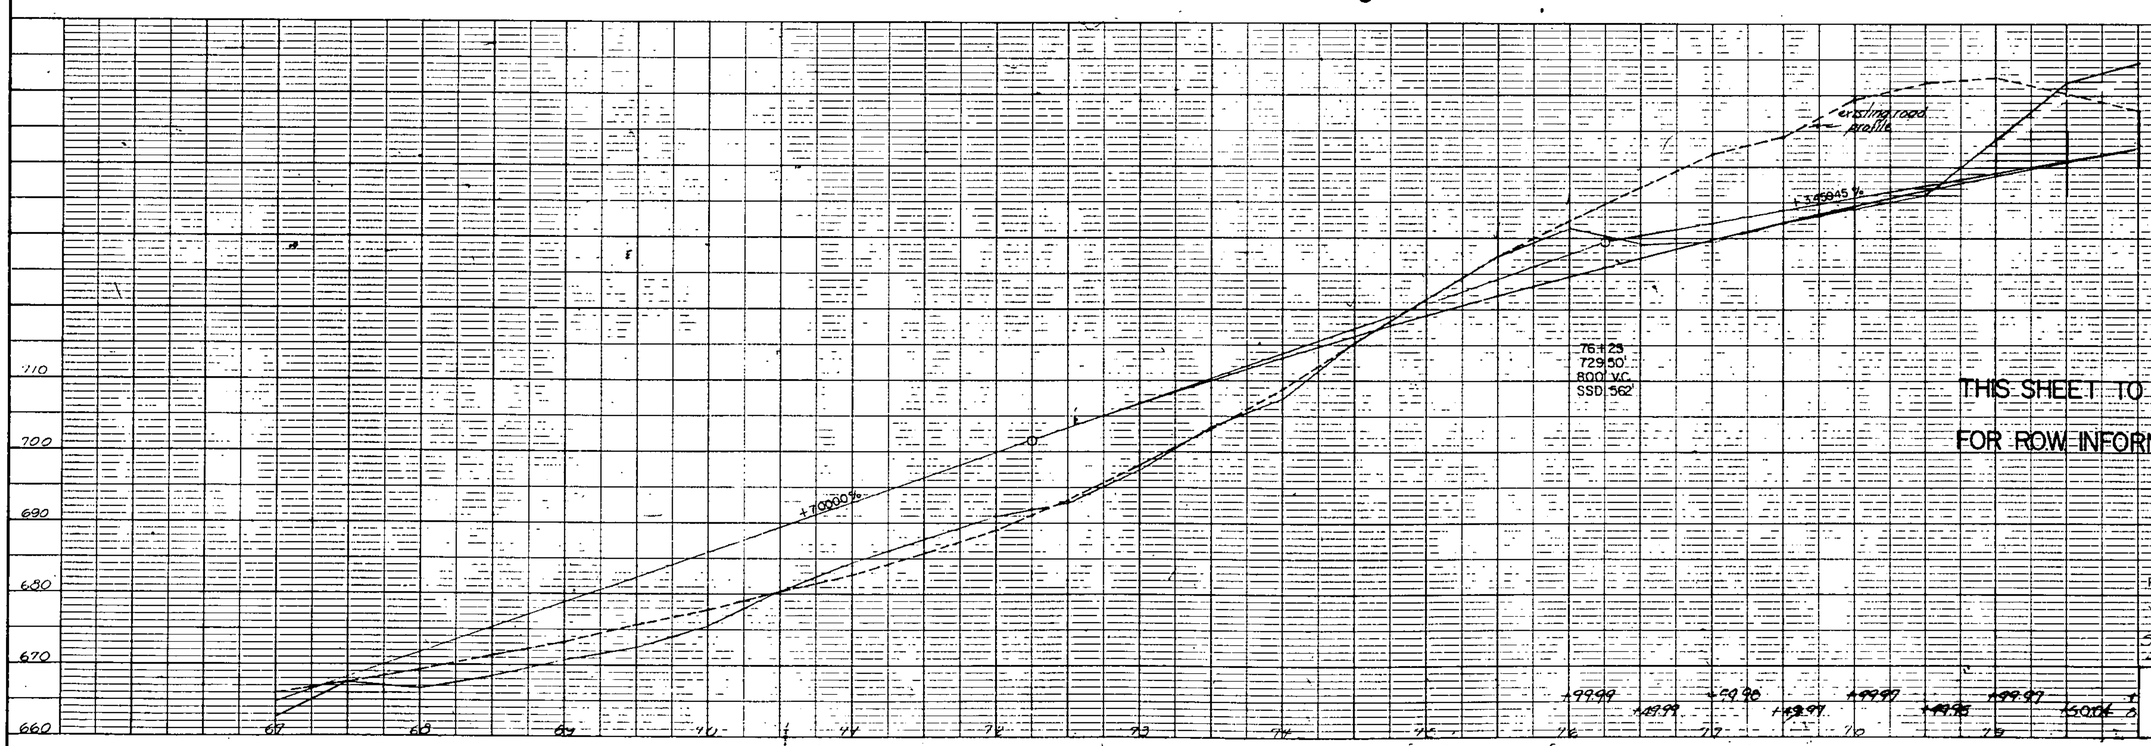

ROW PLANS
R.O.W. SHEET 15 OF 16
ST. JOHNSBURY
Surv. by Fails Sta. 9/20/11/35
L. 411.2/ 2010, Page 67, Bk.

ST. JOHNSBURY
DP FF 041-1(10)
SHEET 28 OF 229

PLAN
SURVEYED
PLOTTED
NOTE BOOK
ALIGNMENT CHECKED
R.O.W. CHECKED
No.

PROFILE
SURVEYED
PLOTTED
NOTE BOOK
GRADES CHECKED
STRUCTURE DETAILS CHECKED
No.

K+B PLATE 1, PLAN-PROFILE