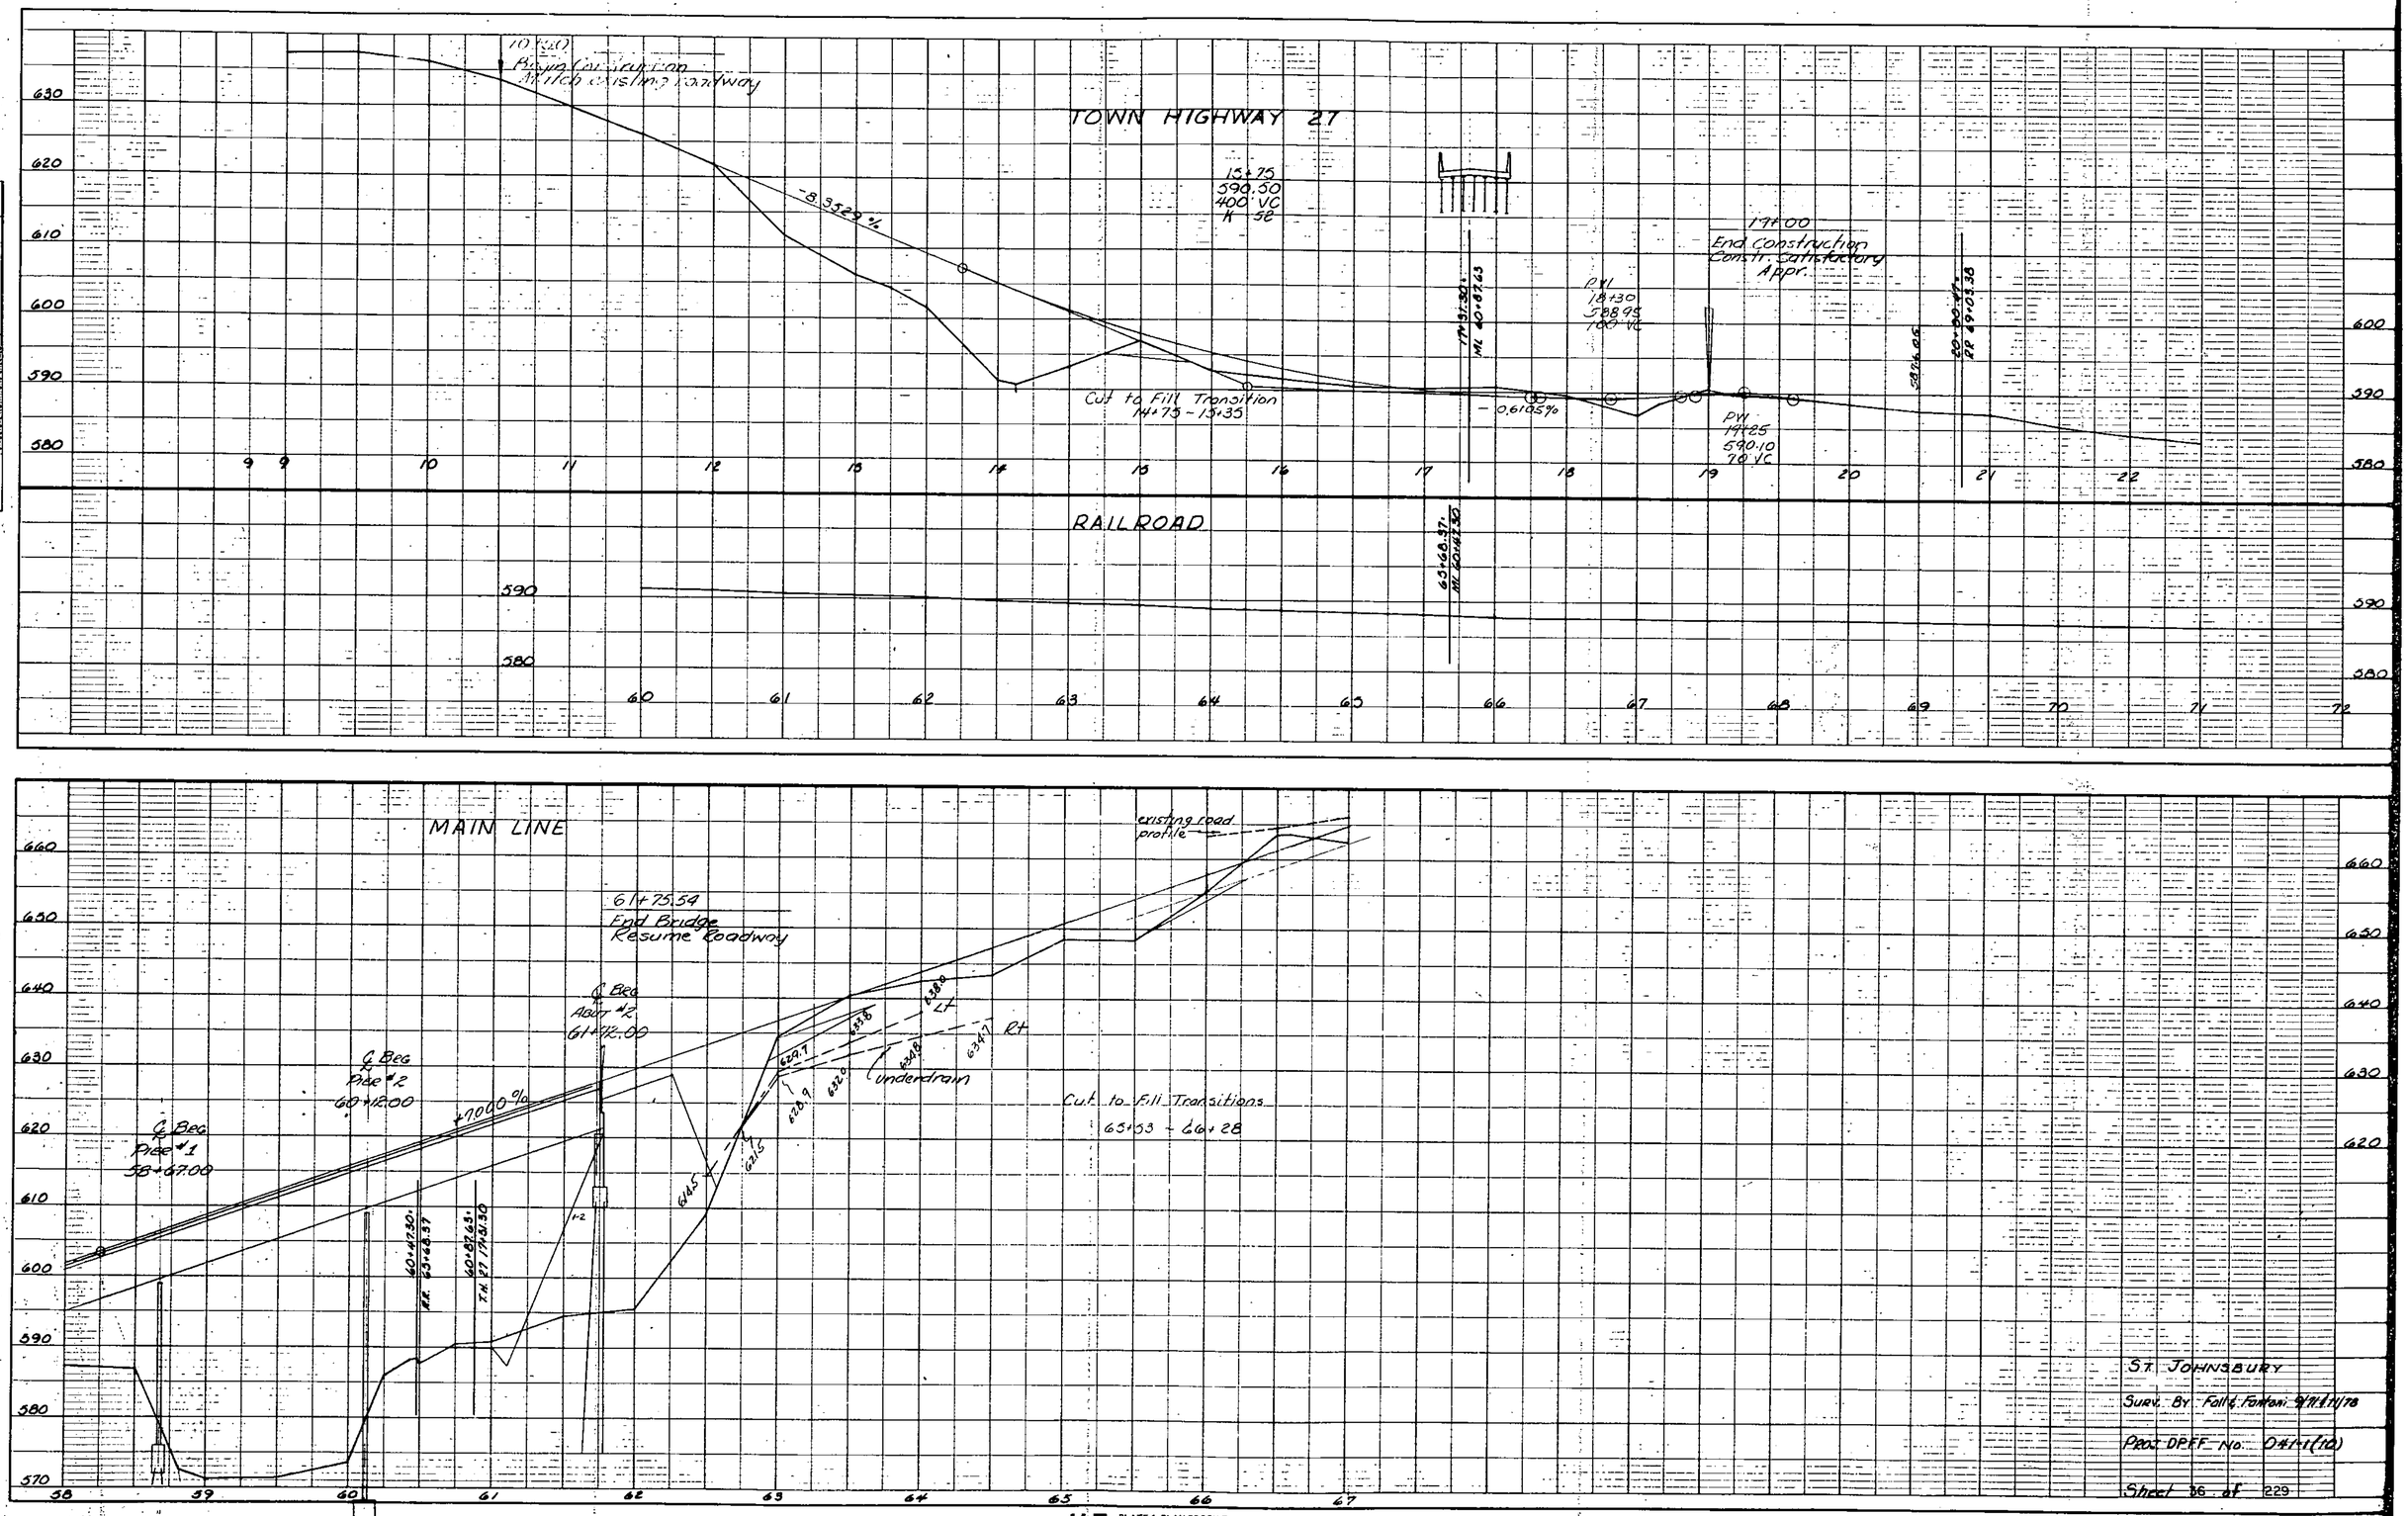

PROFILE
SURVEYED
PLOTTED
NOTE BOOK
CHECKED
No.
STRUCTURE INSTALLATIONS CHECKED

PLATE 1. PLAN-PROFILE