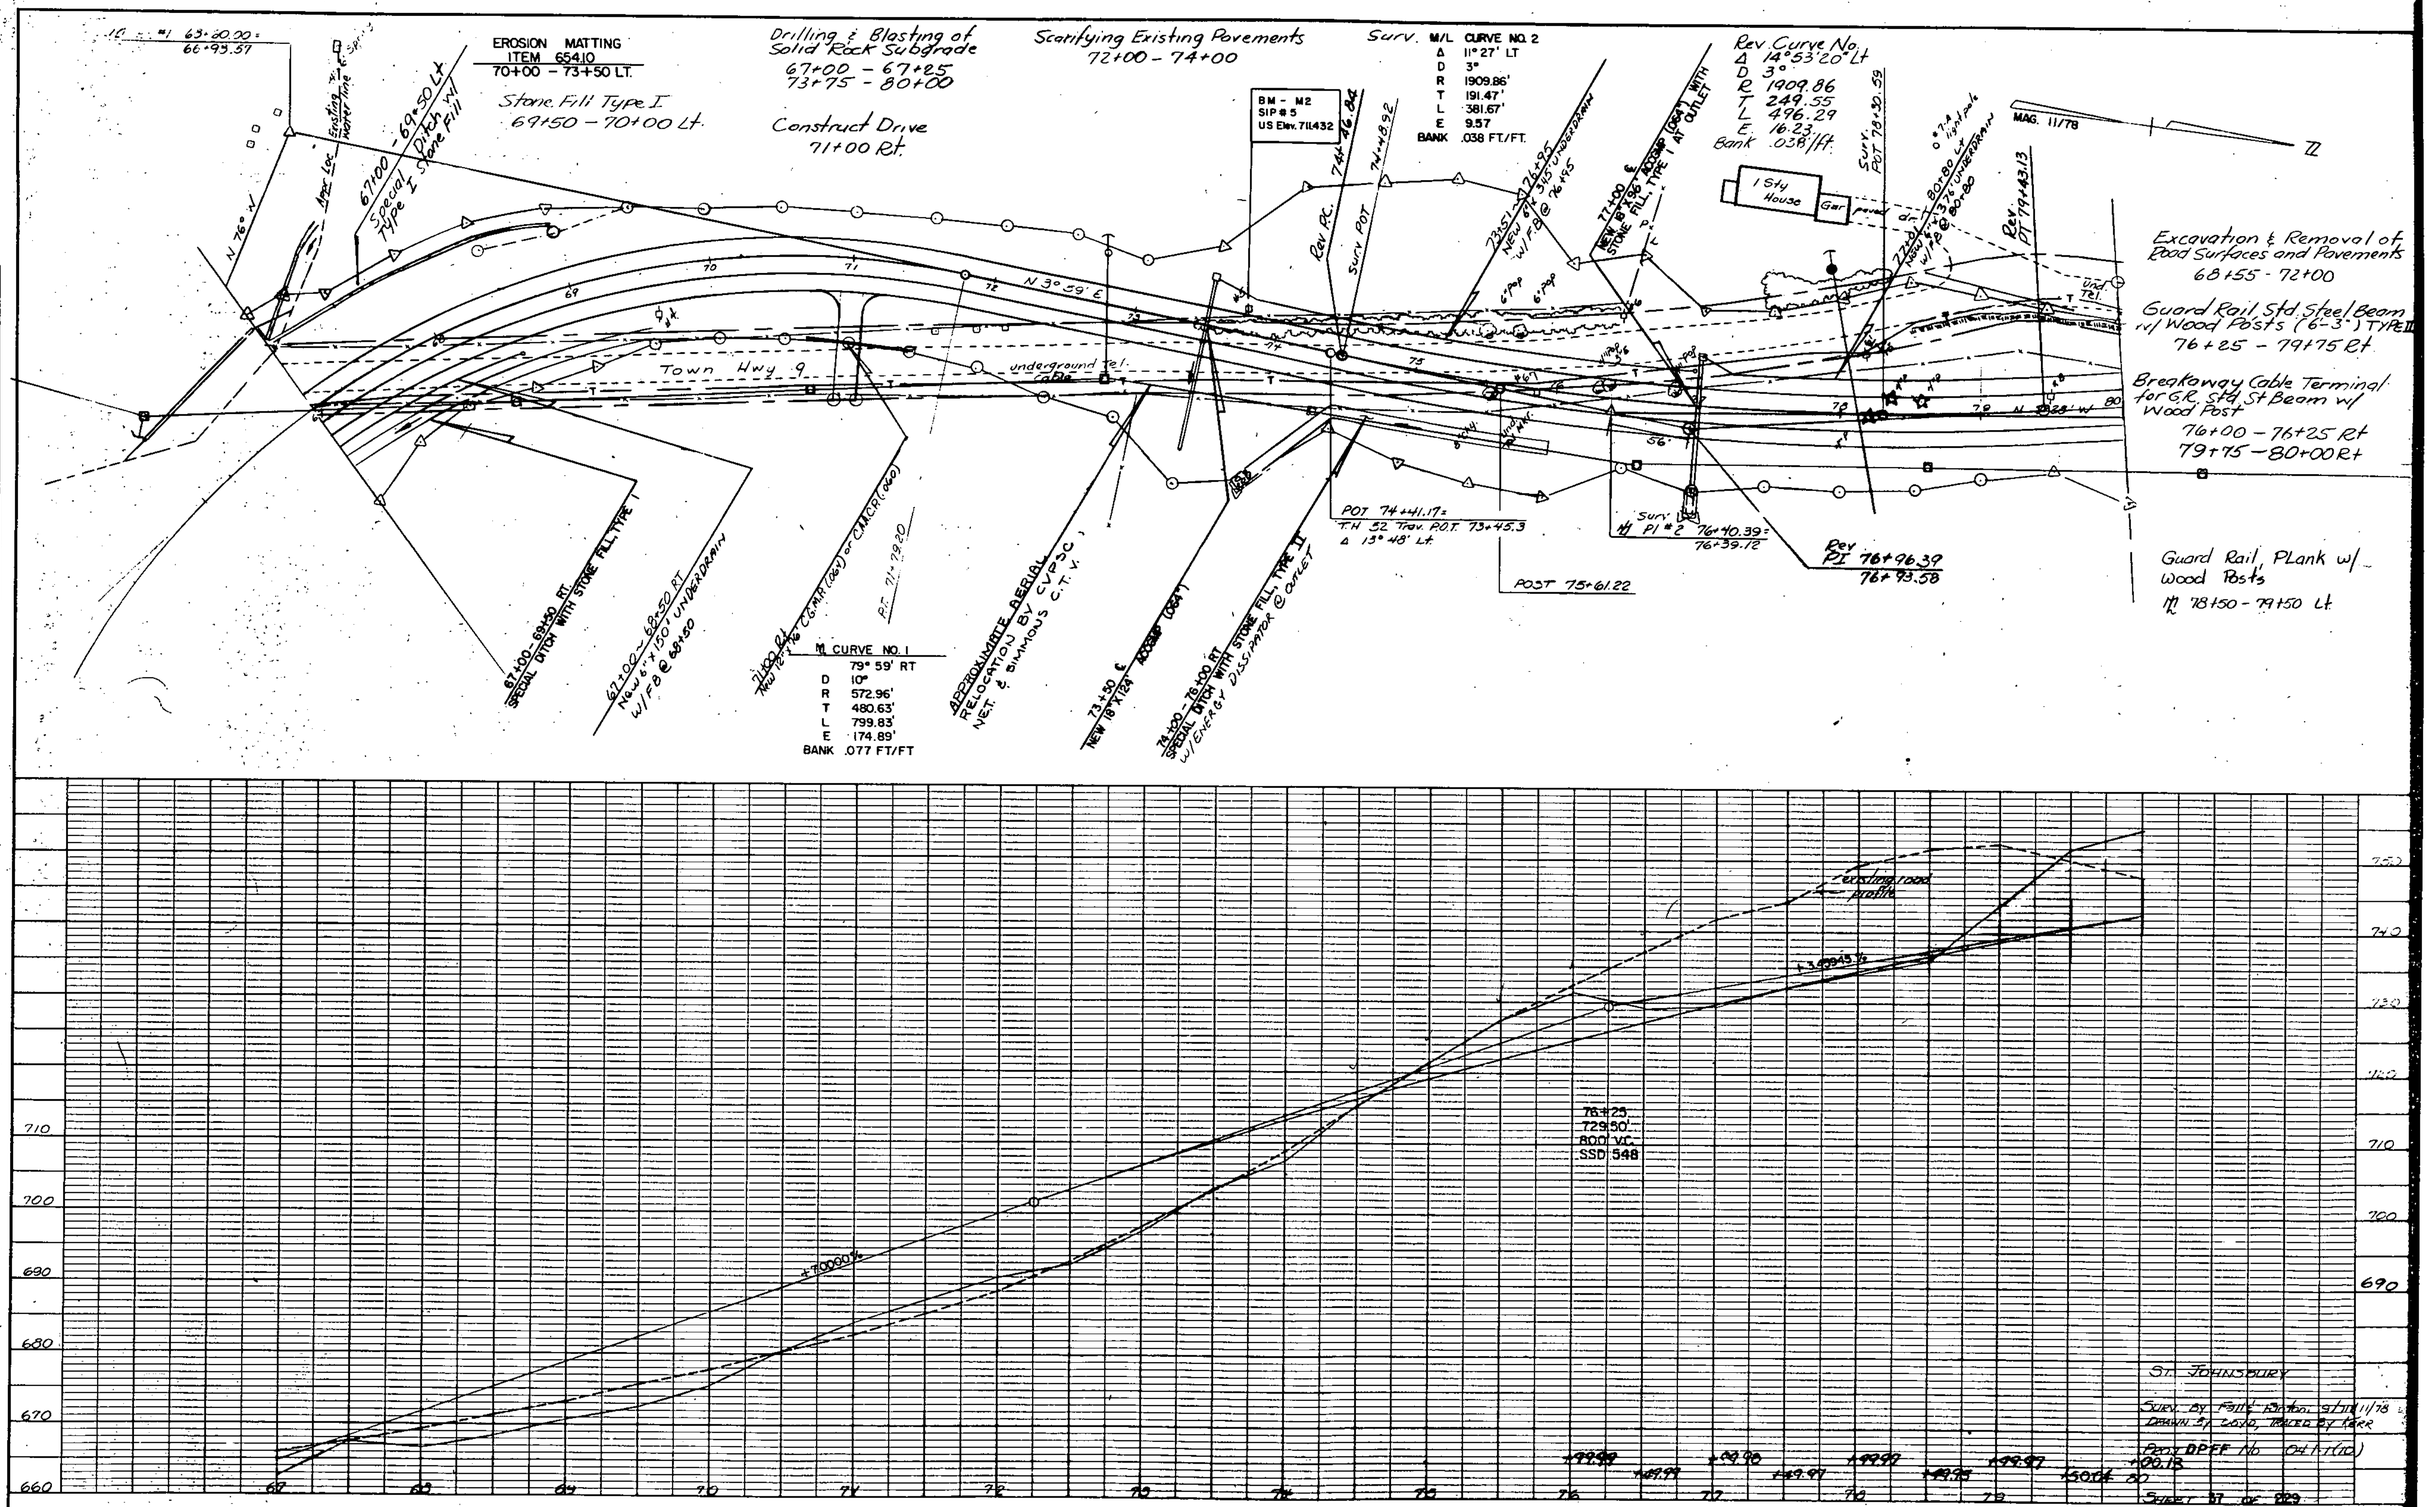

PLAN
SURVEYED
PLOTTED
NOTE BOOK ALIGNMENT CHECKED
No. RT. OF WAY CHECKED

PROFILE
SURVEYED
PLOTTED
NOTE BOOK GRADES CHECKED
No. STRUCTURE DATA CHECKED
STRUCTURE CALCULATIONS CHECKED

K+E PLATE 1, PLAN-PROFILE