COMPOSITE SHEET - TRAFFIC SIGN SUMMARY - TRAFFIC ITEM SUMMARY - NOTES AND DETAILS

TRAFFIC SIGN SUMMARY

MILEMARKER, STATION OR SIGN NUMBER	LEGEND	TYPE	SIGN DIMENSIONS	EXISTING SIGNS TO BE SALVAGED: REMOVE (S.F.)	RETAIN (X)	NEW AND SALVAGED SIGNS (S.F.): NEW "A"	SALVAGED "A"	NEW "B"	SALV. "B"	EXISTING POSTS: RETAIN	DRILL	SALV.	NEW POSTS: NUMBER OF POSTS	TYPE "A" (FLANGED CHANNEL): 2.0 LB./FT.	2.5 LB/FT.	3.0 LB/FT.	TYPE "C" (ALUMINUM): 3" /	3" □	4" Ø MOD.	4" Ø	TYPE "B" BR'KAWAY STEEL	REMARKS	FOR SIGN DETAIL SEE SHEET OR STANDARD SHEET NUMBER
I-91 N.B. @ MM. 131.55 (EXISTING SIGN) NOT A PART OF PROJ. DP FF 041-1(10)	(L) NEXT EXIT (—) MILES; NUMERAL MISSING - ADD A "5"; STANDARD NUMERAL 8" SERIES "E" MODIFIED				X																		
28 A } GO IN SEQUENCE W/ #28 ON SHEET #52	(2)	A	18" x 24"			3							1	X									E-19
28 B		A	18" x 24"			3							1	X									E-19
						6																	
41	SPEED LIMIT 30	A		X						REMOVE													
42		A		X						REMOVE													
				2																			
						108.6	TOT. SHEET 50																
						134.6	TOT. SHEET 51																
				5		109.5	TOT. SHEET 52																
				2		6	TOT. THIS SHEET																
TOTALS COLUMN																							
PROJECT				12		358.7																	

TRAFFIC ITEM SUMMARY

ITEM NUMBER	ITEM	UNIT			SUB TOTAL		ROUNDING		TOTAL
646.21	PAINTED CURBS	L.F.			558		2		560
646.35	TEMPORARY 4" REFLECTORIZED WHITE LINE	L.F.			10152		3		10155
646.36	TEMPORARY 4" REFLECTORIZED YELLOW LINE	L.F.			6495		–		6495
646.60	DURABLE 4" REFLECTORIZED WHITE LINE	L.F.			448		2		450
646.61	DURABLE 4" REFLECTORIZED YELLOW LINE	L.F.			2552		3		2555
646.64	DURABLE 24" STOP BAR	L.F.			117		3		120
646.65	DURABLE ARROW MARKINGS	EA.			7		-		7
646.66	DURABLE LETTER IN WORD MARKINGS	EA.			44				44
675.20	TRAFFIC SIGNS TYPE "A"	S.F.			358.7		1.3		360
675.35	TRAFFIC SIGN POSTS, TYPE "A"	LB.			1658		2		1660
675.37	TRAFFIC SIGN POSTS, TYPE "C"	LB.			68.4		1.6		70
675.53	REMOVING SIGNS	EA.			12		-		12
678.16	FLASHING BEACON (PRICE OF FLASHING BEACON TO INCLUDE POLES, BASES, CONDUCTOR, CONDUIT, SPAN WIRE, BEACON, ALL NECESSARY FITTINGS OR HARDWARE AND ALL WORK REQUIRED TO PROVIDE A FULLY FUNCTIONING INSTALLATION MEETING APPLICABLE CRITERIA OF SECTION 678 OF THE STANDARD SPECIFICATIONS.)	EA.			1				1

NOTES AND DETAILS

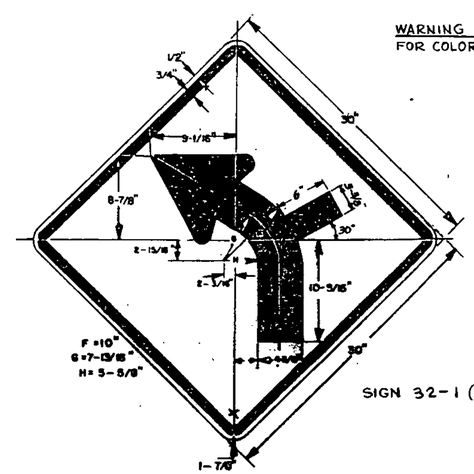

WARNING SIGNS - SEE STD. E-19A FOR COLORS AND MATERIALS

SIGN 32-1 (SEE SHEETS 48 & 52)

SIGN 9-10

WHITE TEXT AND ARROW ON A BLUE BACKGROUND (ALL REFLECTORIZED)

(SEE SHEETS 46 & 50)

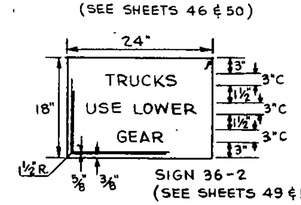

SIGN 36-2 (SEE SHEETS 49 & 52)

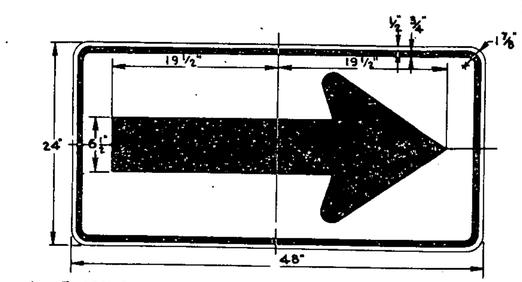

MOUNT ARROWS POINTING LEFT

SIGNS 29, 30 & 31 (SEE SHEETS 48 & 52)

SIGN SUMMARY
TRAFFIC ITEM SUMMARY
NOTES AND DETAILS

SURVEYED BY _____ DATE _____
DRAWN BY _____ DATE _____
TRACED BY _____ DATE _____

ST. JOHNSBURY
PROJ. DP FF NO. 041-1 (10)
SHEET 53 OF 229