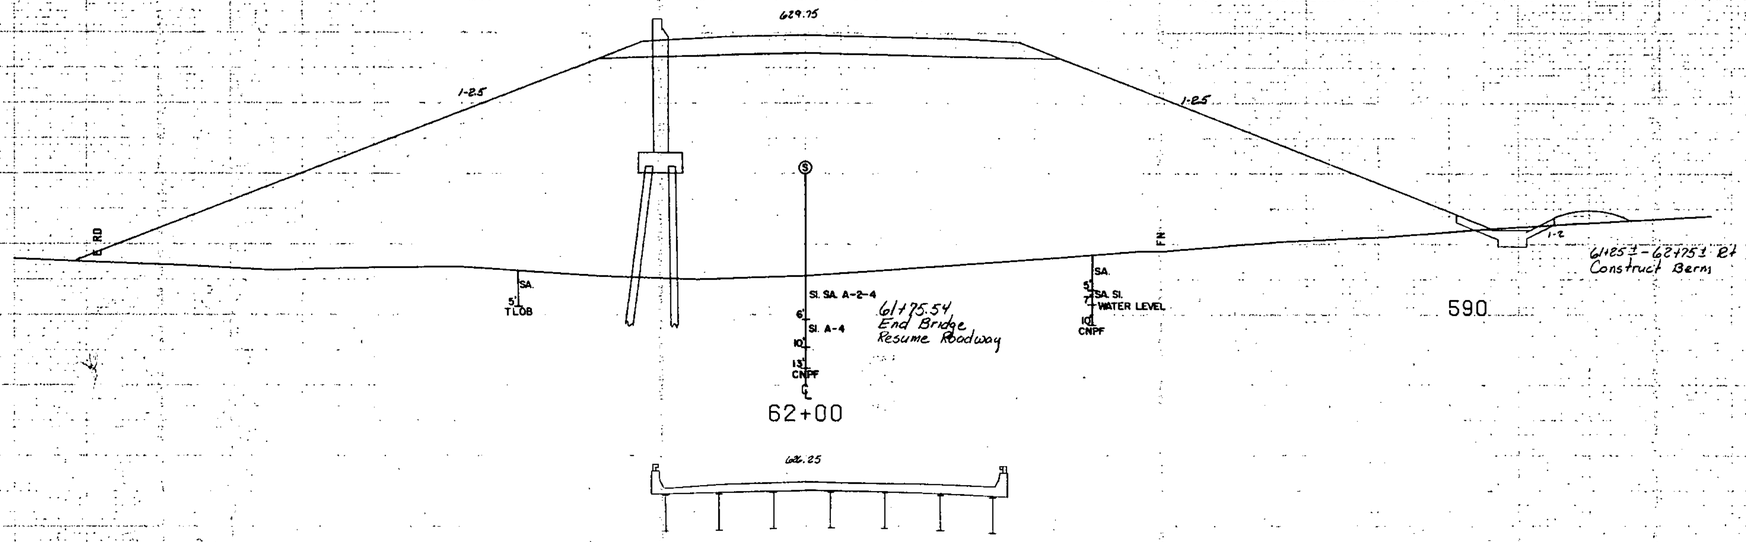

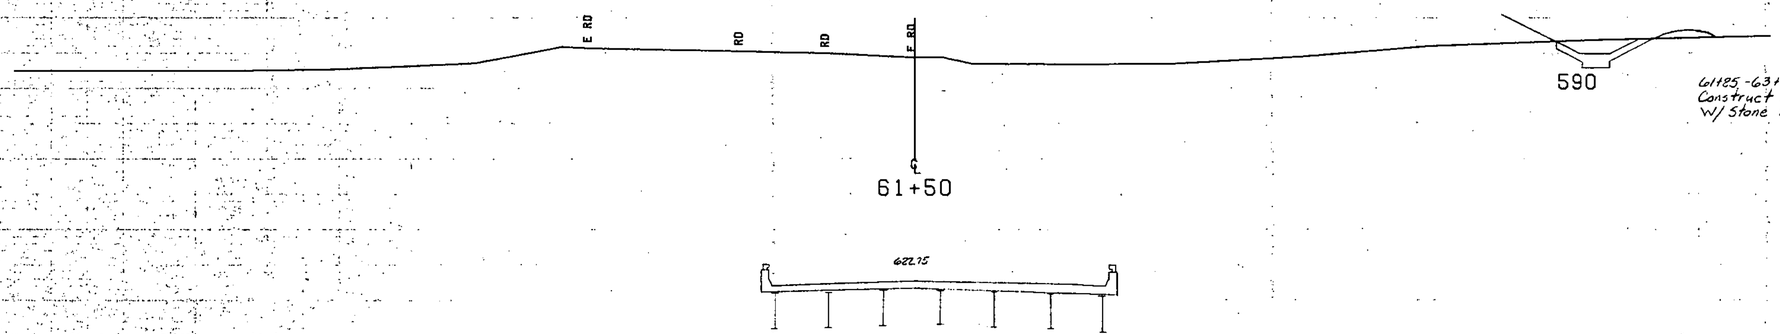

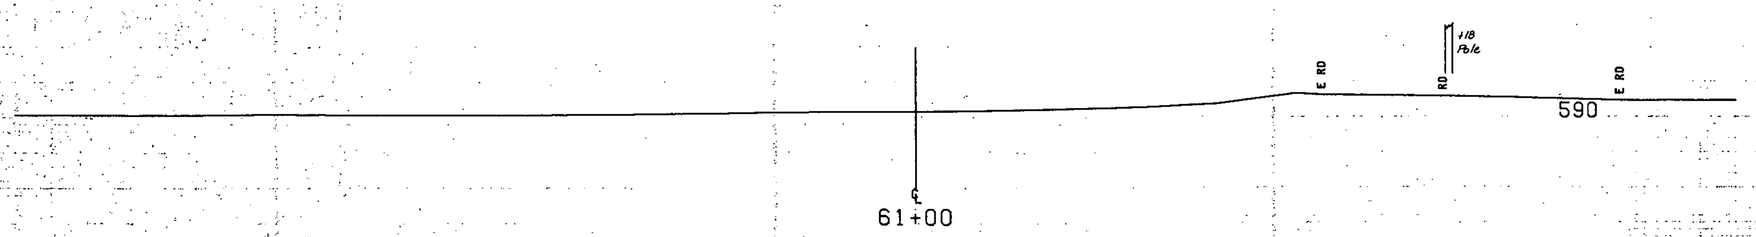

FROM STA.	61+00	TO STA.	62+00
PROJECT NAME		ST. JOHNSBURY MAIN	
NO.		DP-FF041-1(10)	PLOTTED 12/11/84
SURVEYED BY		FANTONI	11/78
SHEET NO	OF	SHEETS 229	

SCALE 10 FEET