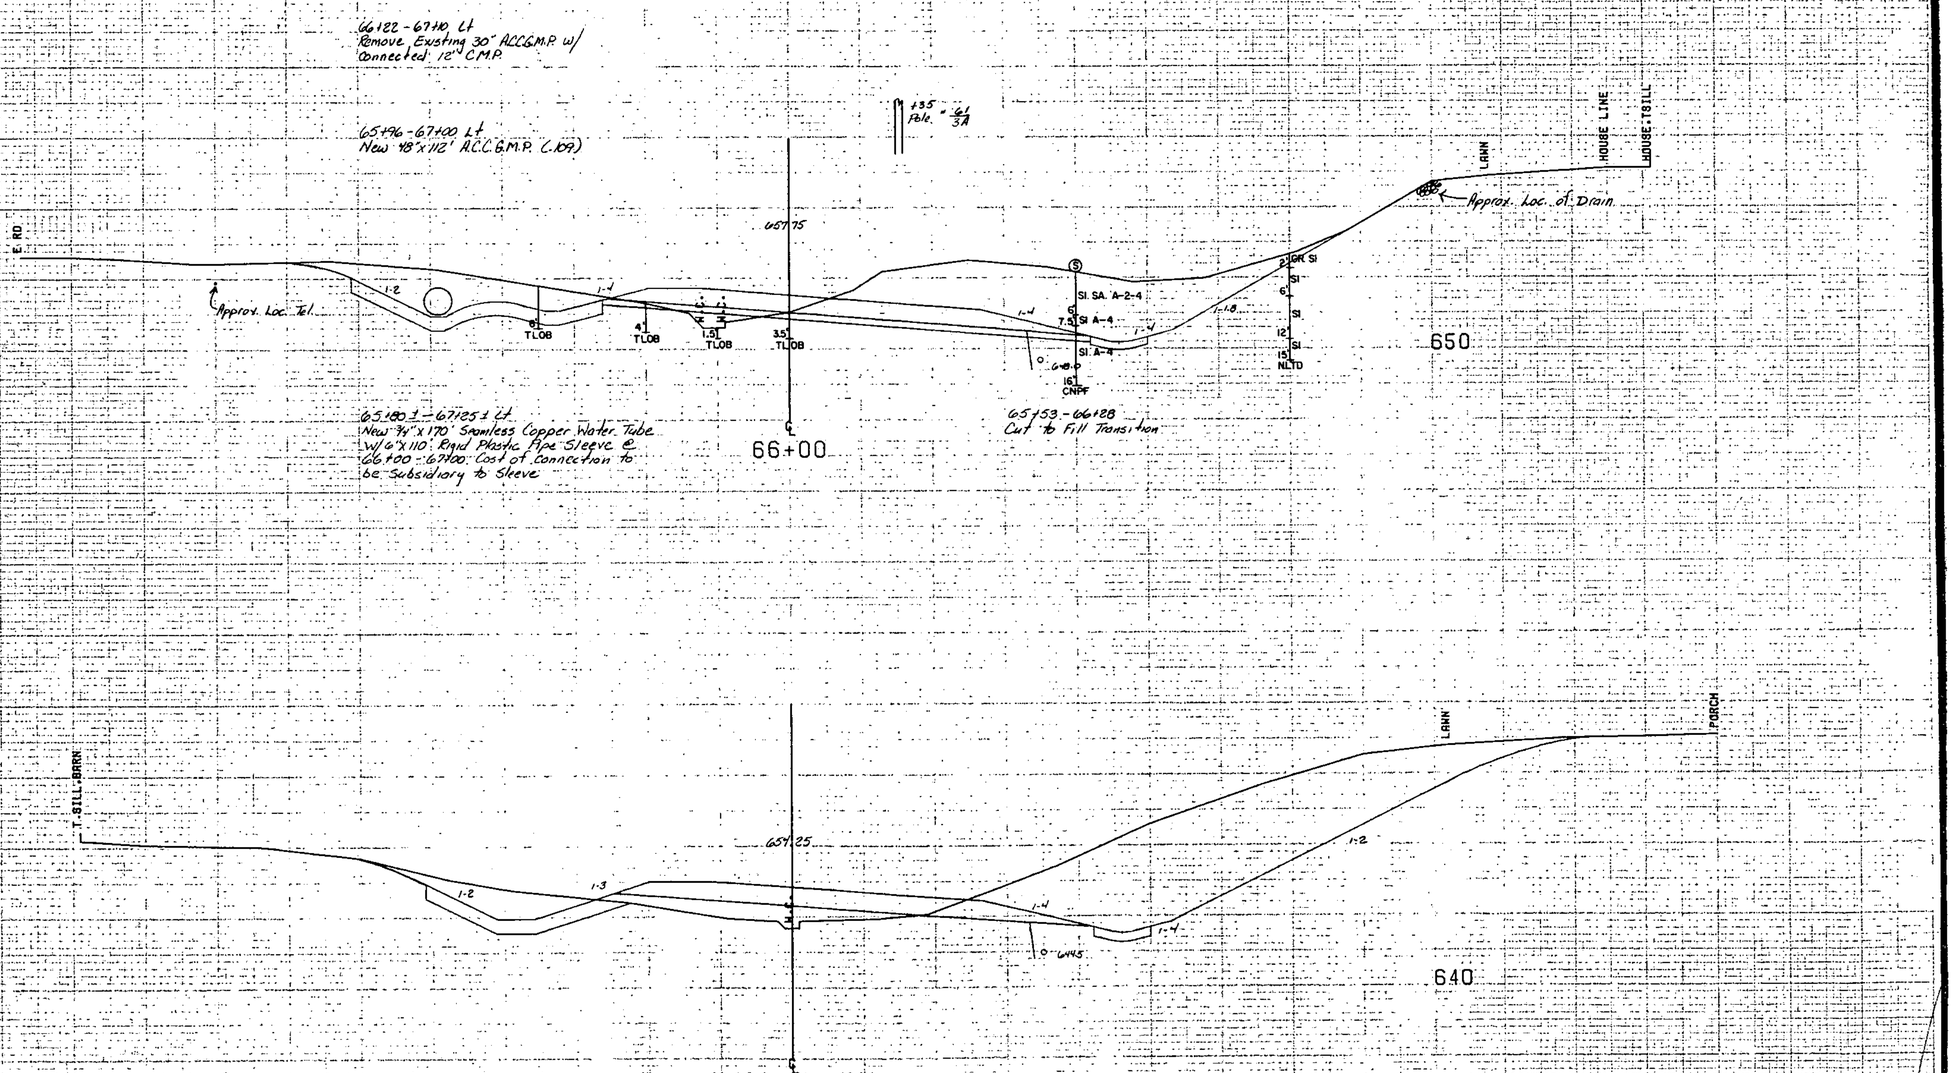

FROM STA. 65+50		TO STA. 68+00	
PROJECT NAME	ST. JOHNSBURY MAIN		
NO.	OP-FF041-(10)	PLOTTED	12/11/84
SURVEYED BY	FANTONI	11/78	
SHEET 113 OF [redacted]	SHEETS 229		

SCALE 1" = 10 FEET