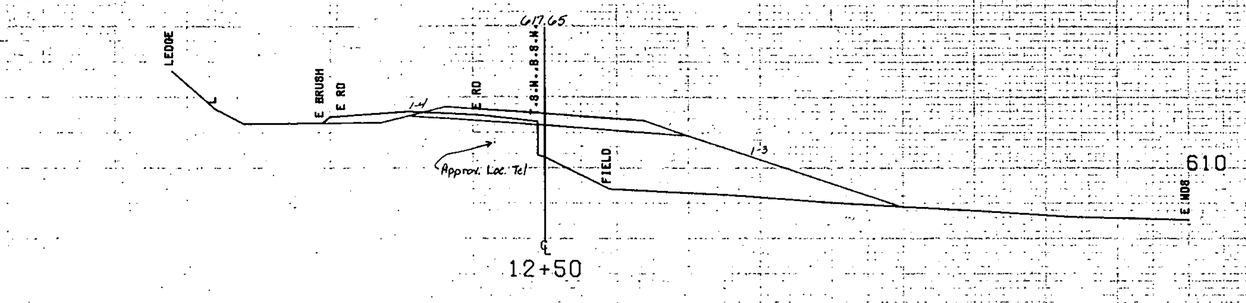

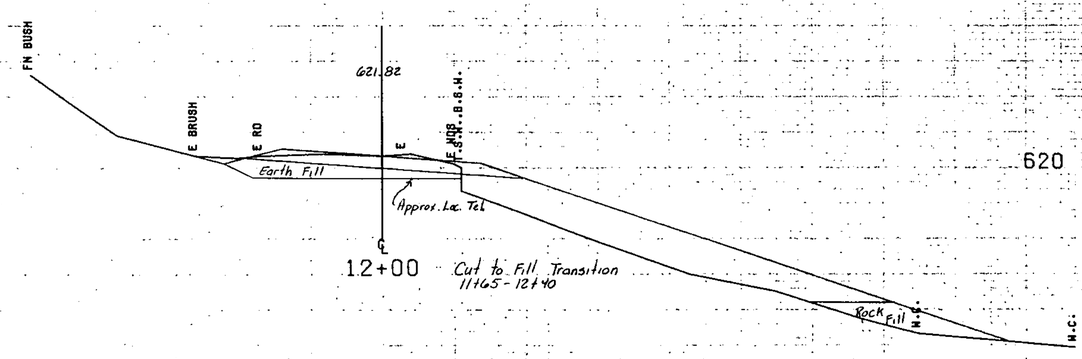

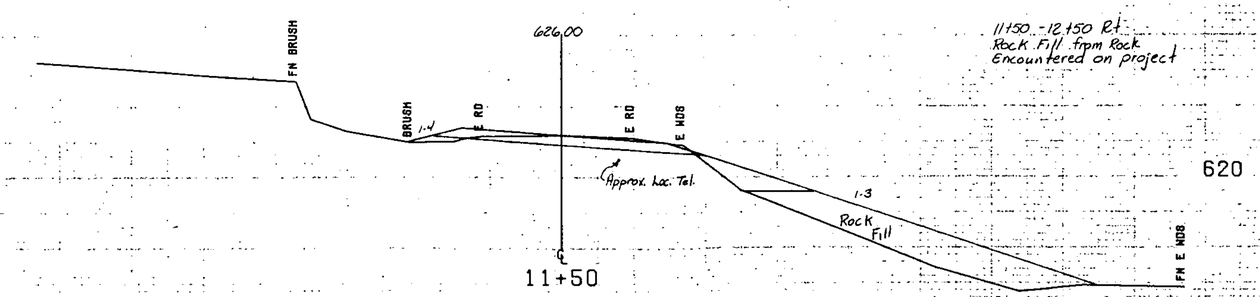

11+50 - 12+50 Rt.
Rock Fill from Rock
Encountered on project

FROM STA.	11+50	TO STA.	12+50
PROJECT NAME	ST. JOHNSBURY T-H 27		
NO.	OP-FF041-1(10)	PLOTTED	12/11/84
SURVEYED BY	FANTONI		11/78
SHEET 58 OF [redacted]	SHEETS 229		

SCALE 10 FEET