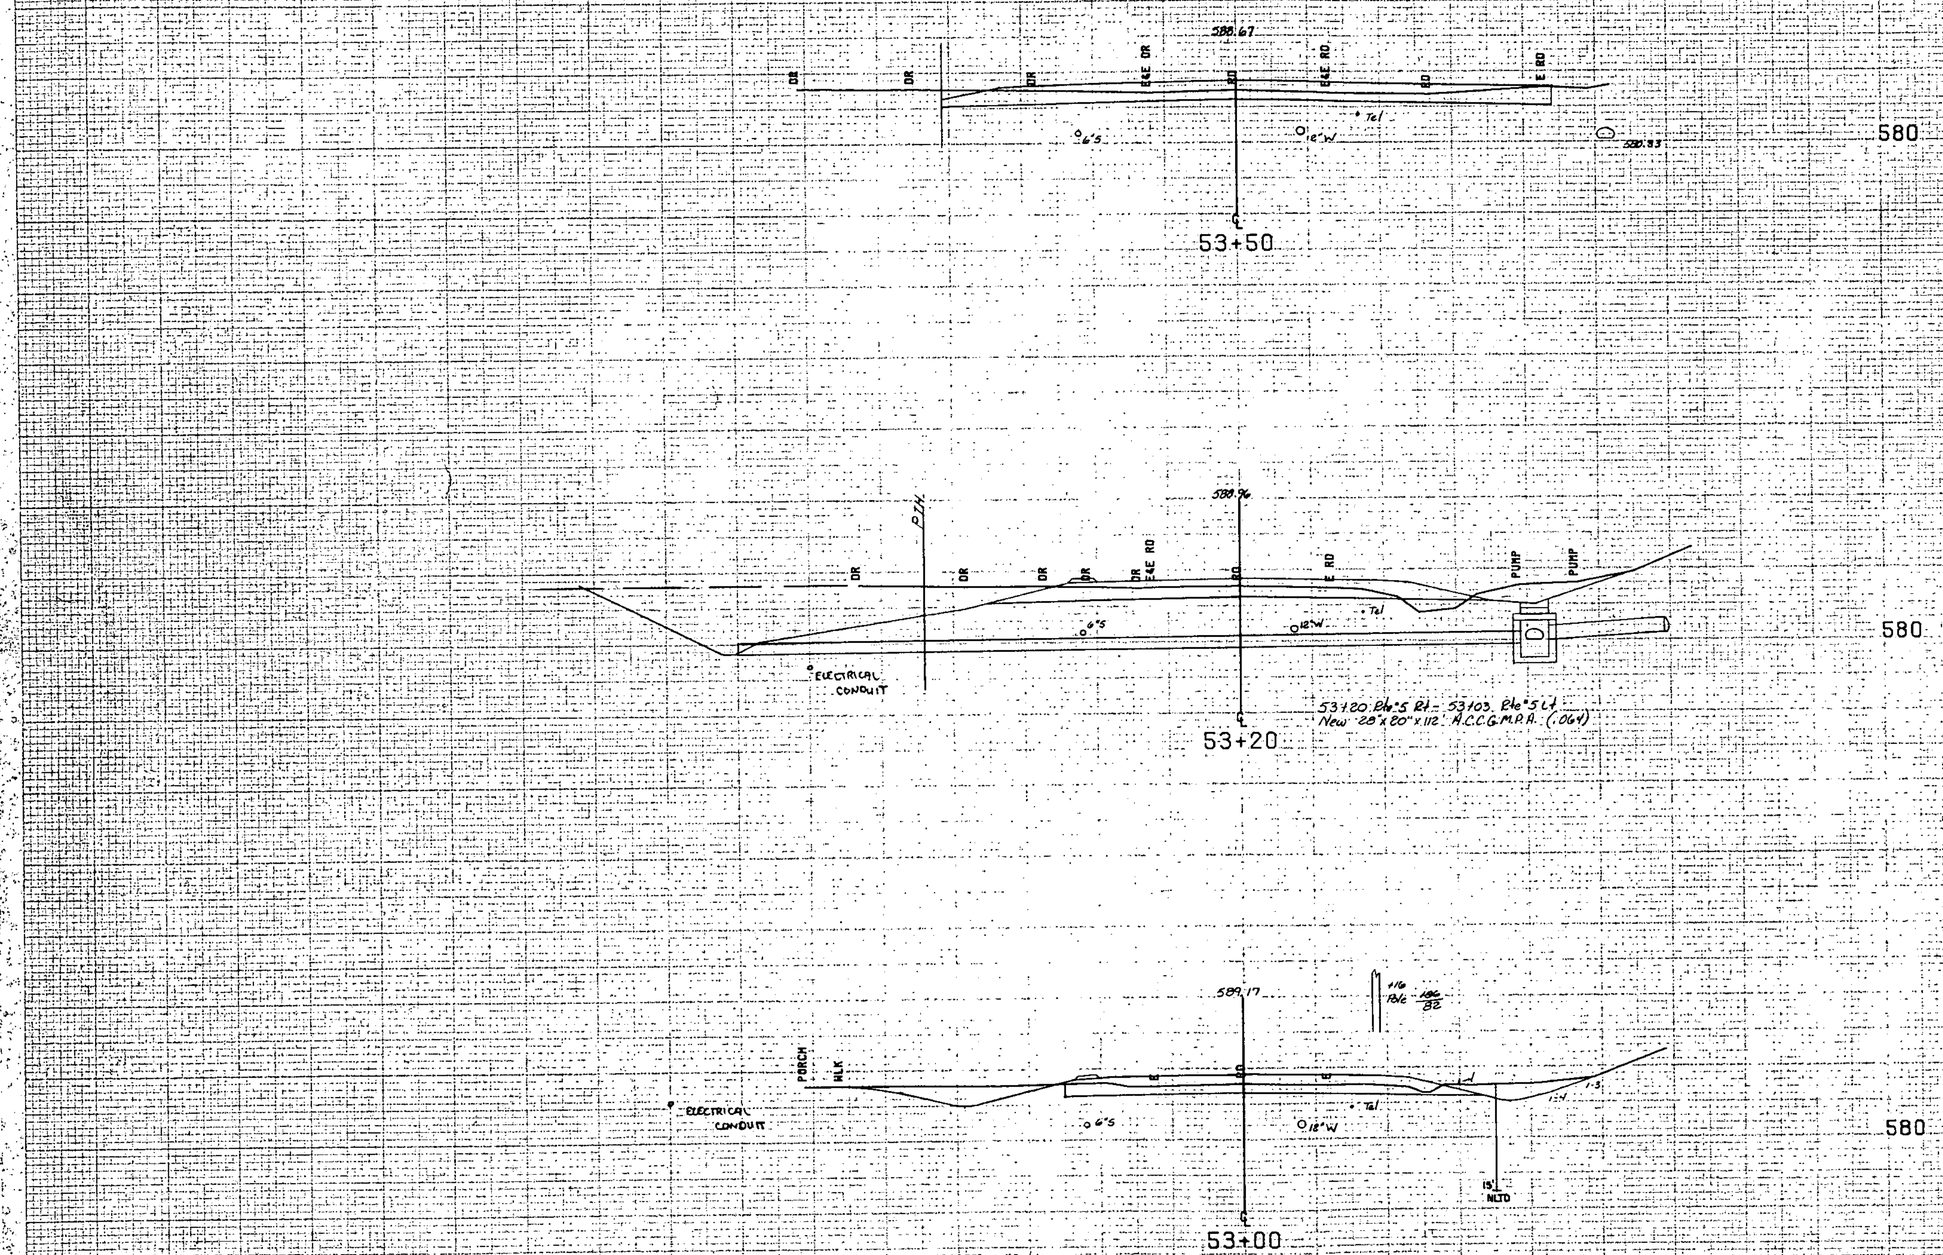

FROM STA. 53+00		TO STA. 53+50	
PROJECT NAME	ST. JOHNSBURY U.S. RTE. 5		
NO.	OP-FF041-1(10)	PLOTTED 12/11/84	
SURVEYED BY	FANTONI	11/78	
SHEET 53 OF 63	SHEETS 53-223		

SCALE 1" = 10 FEET